

E. C. R.
SAMASTIPUR
DIVISION

TOTAL SHEET:—31

Qua d cable Route Plan

SAMASTIPUR — DARBHANGA

LEGEND

Railway Track

--




Qua d cable Route

--



Station Building

--

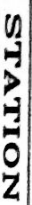

Derivation joint:-

--



Level Crossing

--



Straight Through joint

--



G.I.Pipe

--



Culvert/ROB

--



ERP

--



CONTRACTOR

SSE/T/C/MFP

ASTE/Pro./HIP

DY.CSTE/Pro./HIP

M/S. S. V. Engineering Works

Partners

Partners

SCALE

X 1 mm : 4.00m

Y 1 mm : 1.10m

SHEET:- 01

EAST CENTRAL RAILWAY
SAMASTIPUR
DIVISION

Drawing title as built drawing
Block section Samastipur-Muktapur

QUAD CABLE ROUTE PLAN

DRAWN BY:-

MADHURI CHOUCK

Road

Road

ROAD

Infront of DRM Building

Water tank

ROAD

ROAD

Drain

CENRAL
PANEL
SPJ

N

Road

Road

Road

BOUNDARY WALL

BOUNDARY WALL

LEGEND

Railway Track

--



Quad cable Route

--



Station Building

--



Derivation joint:--

--



Level Crossing

--



Straight Through joint

--



G.I. Pipe

--



Culvert/ROB

--



ERP

--



CONTRACTOR

BSR/T/C/MFP

ASTR/PRO./HJP

DY. CSTE/PRO./HJP

W. S. Engineering Works

Asst. Engr.

W. S. Engineering Works

SCALE

X 1 mm : 4.00m

Y 1 mm : 1.10m



SHEET:- 02

EAST CENTRAL RAILWAY
SAMASTIPUR
DIVISION

Drawing title as built drawing
Block section Samastipur-Muklapur

QUAD CABLE ROUTE PLAN

DRAWN BY:-

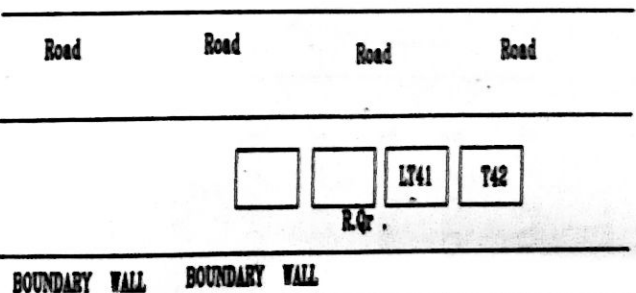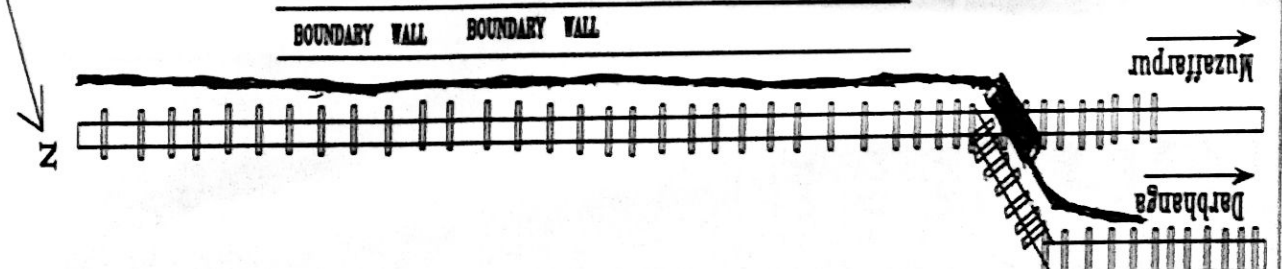

LEGEND

Railway Track	--	
Qua d cable Route	--	
Station Building	--	
Derivation joint:--	--	
Level Crossing	--	
Straight Through joint	--	
G.I.Pipe	--	
Culvert/ROB	--	
ERP	--	

CONTRACTOR	SSE/T/C/MFP	ASTR/Pro./BJP	DY.CSTE/Pro./BJP
------------	-------------	---------------	------------------

M/S. Aenu Engineering Works

Signature

Partner

SCALE

X 1 mm : 4.00m
Y 1 mm : 1.10m


SHEET:- 03

EAST CENTRAL RAILWAY
SAMASTIPUR
DIVISION

Drawing title as built drawing
Block section Samastipur-Muktapur

QUAD CABLE ROUTE PLAN

DRAWN BY:-

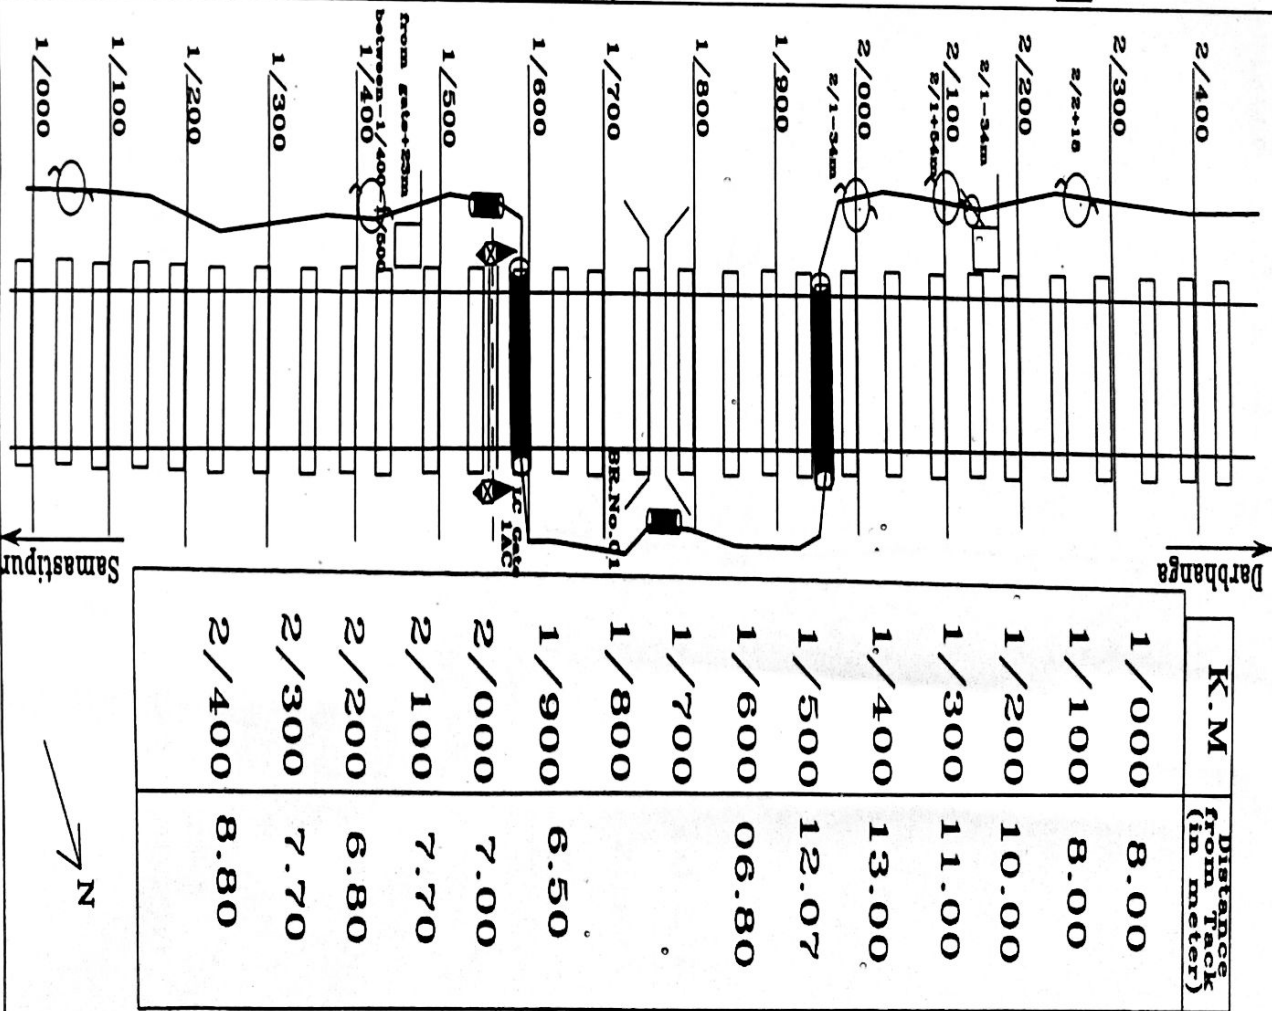

LEGEND

Railway Track

..
i



Quaid cable Route

 $\ddot{i}$ 

Station Building

..

STATION

Derivation joint:—



Level Crossing

11



Straight Through joint

$$\ddot{i}$$


G.I. Pipe

1



Culvert/ROB

1



ERP

1



CONTRACTOR	SSE/T/C/MFP	ASTE/Pro./HJP	DY.CSTE/Pro./HJP
------------	-------------	---------------	------------------

15. Open Engineering Works

Kendy

van der Meer

SCALE

X 1 mm :4.00mm

X 1 max : 1.10m


SHEET:- 04

**EAST CENTRAL RAILWAY
SAMASTIPUR
DIVISION**

Drawing title as built drawing	Block section	Samastipur—Muktapur

QUAD CABLE ROUTE PLAN

DRAWN BY:-

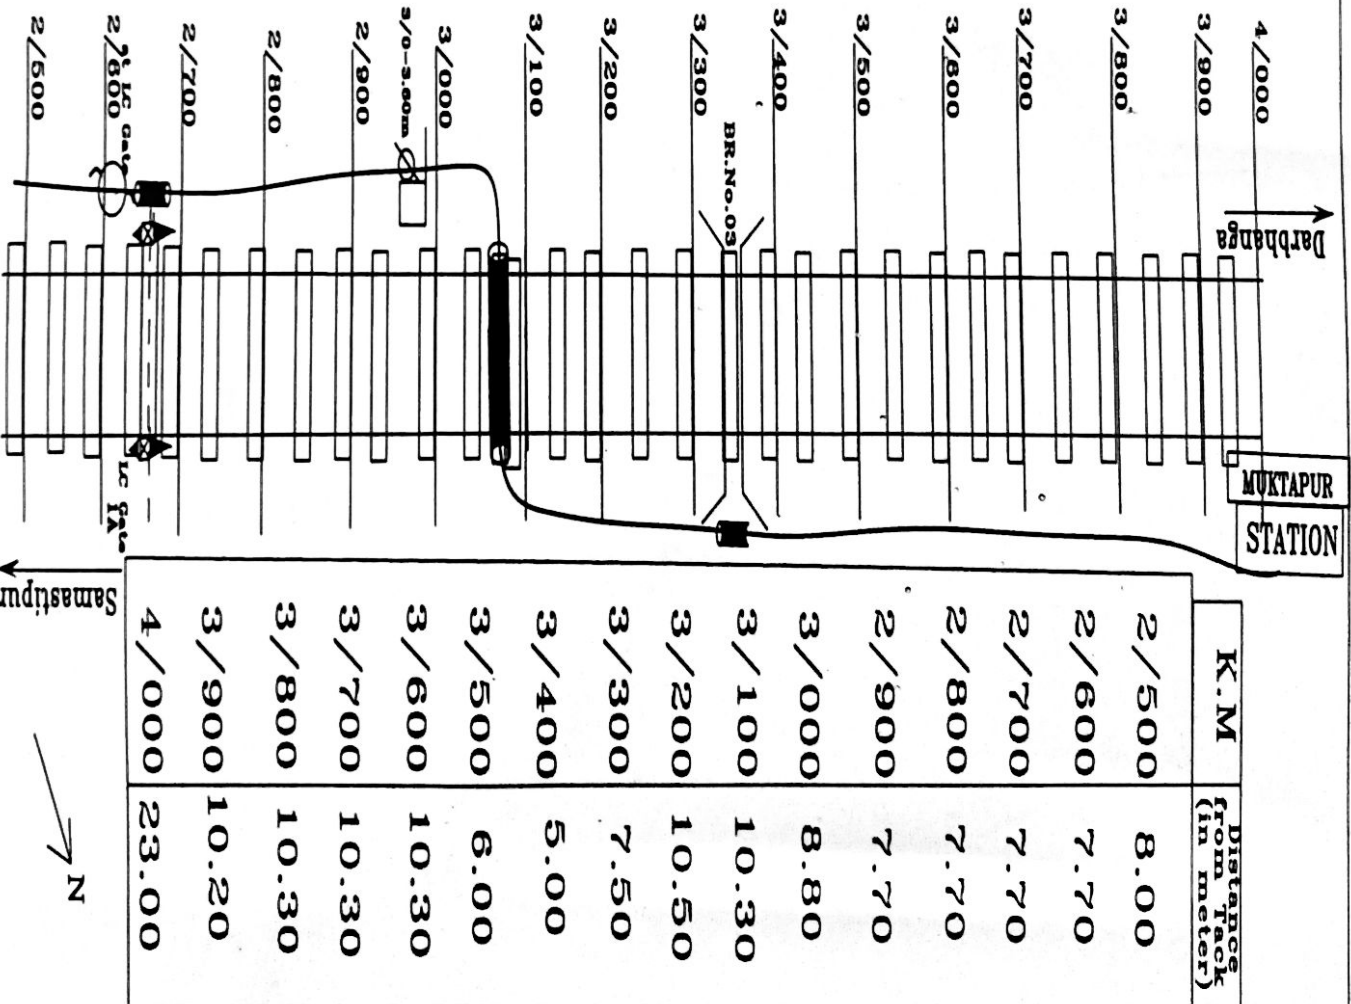

LEGEND

Railway Track	--	
Quad cable Route	--	
Station Building	--	<div>STATION</div>
Derivation joint:-	--	
Level Crossing	--	
Straight Through joint	--	
G.I. Pipe	--	
Culvert/ROB	--	
ERP	--	


CONTRACTOR	SRM/T/C/MPP	MASTR/PRO./HJP	BY.CITE/PRO./HJP
SCALE X 1 mm = 4.00m Y 1 mm = 1.10m			SHEET:- 05

EAST CENTRAL RAILWAY
SAMASTIPUR
DIVISION

Drawing title as built drawing
Block Section Muktapur-Kishanpur

QUAD CABLE ROUTE PLAN

DRAWN BY:-

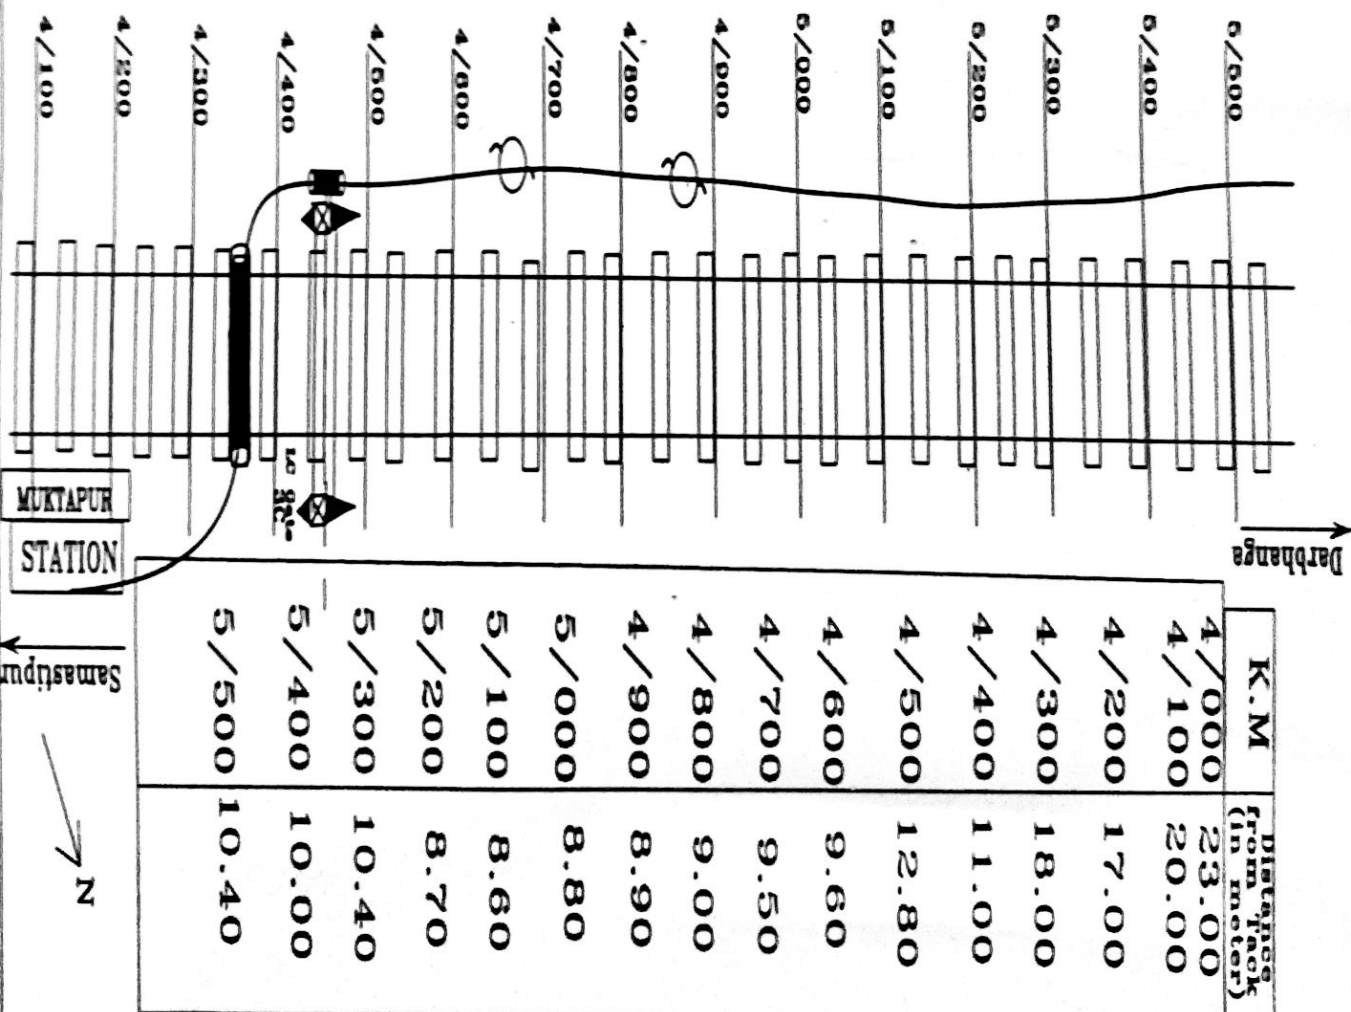


LEGEND

Railway Track	--	
Quad cable Route	--	
Station Building	--	<div>STATION</div>
Derivation joint:-		
Level Crossing	--	
Straight Through Joint	--	
G.I. Pipe	--	
Culvert/ROB	--	
ERP	--	

CONTRACTOR	SSE/T/C/MFP	ASTE/Pro./HJP	DY.CSTE/Pro./HJP
M/S. S. S. Engineering Works	Kishu		
Partner			
SCALE	SHEET:- 06		
X 1 mm : 4.00m			
Y 1 mm : 1.10m			

EAST CENTRAL RAILWAY
SAMASTIPUR
DIVISION

Drawing title as built drawing
Block section Muktapur-Kishanpur
QUAD CABLE ROUTE PLAN
DRAWN BY:-

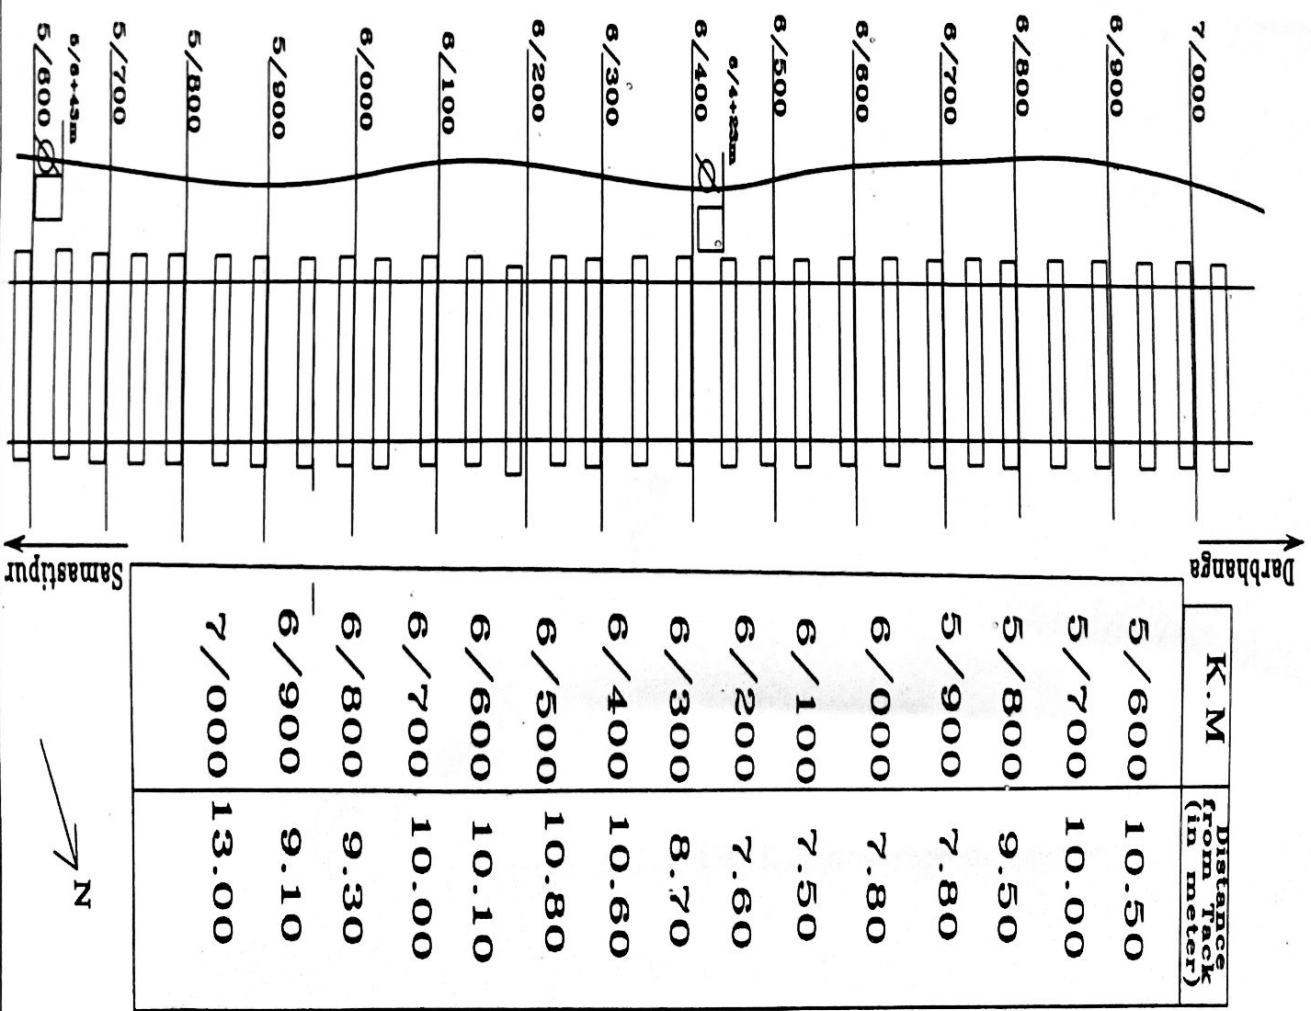

LEGEND

Railway Track	--	
Qua d cable Route	--	
Station Building	--	STATION
Derivation joint:--	--	
Level Crossing	--	
Straight Throug h joint	--	
G.I.Pipe	--	
Culvert/ROB	--	
ERP	--	

CONTRACTOR	SSE/T/C/MFP	ASTE/Pro./HJP	DY.CSTE/Pro./HJP
M/s Aenu Engineering Works <i>Aenu Engineering</i>	<i>Kishan</i>		
Partner			


SCALE
X 1 mm : 4.00m
Y 1 mm : 1.10m

EAST CENTRAL RAILWAY
SAMASTIPUR
DIVISION

Drawing title as built drawing
Block section Muktapur-Kishanpur

QUAD CABLE ROUTE PLAN

DRAWN BY:--

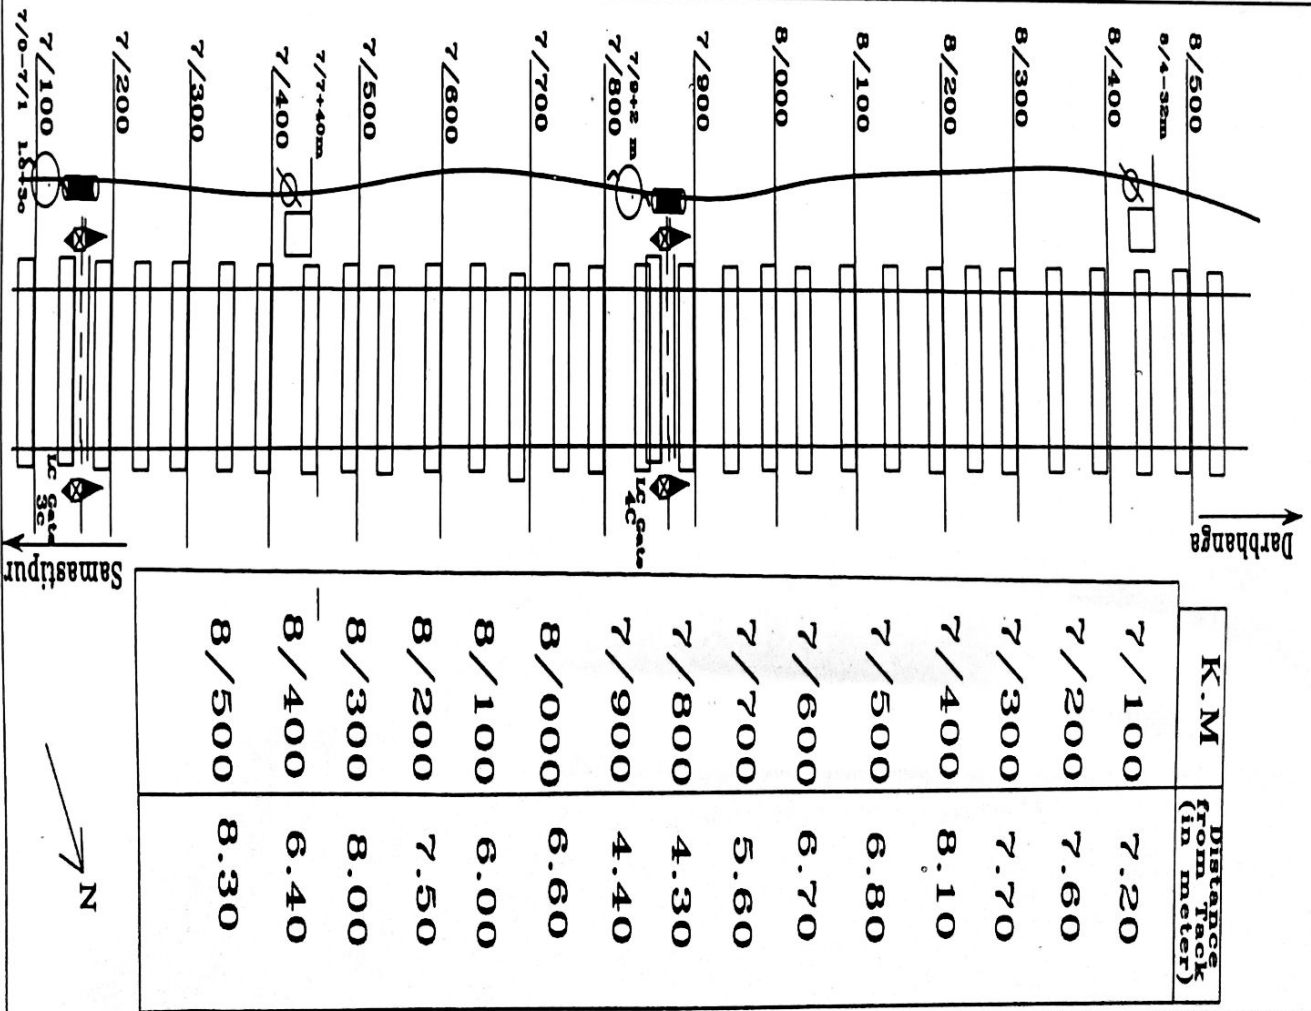

LEGEND

Railway Track	--	
Quad cable Route	--	~~~~~
Station Building	--	[STATION]
Derivation joint:--	--	Ø
Level Crossing	--	⬢-----⬢
Straight Through joint	--	⊙
G.I. Pipe	--	●
Culvert/ROB	--	⌢-----⌢
ERP	--	⌢-----⌢

CONTRACTOR	SEE/T/C/MFP	ASTR/PRO./HJP	BY.CSTE/PRO./HJP
	SEE/T/C/MFP	ASTR/PRO./HJP	BY.CSTE/PRO./HJP


SCALE
X 1 mm = 4.00m
Y 1 mm = 1.10m

EAST CENTRAL RAILWAY
SAMASTIPUR
DIVISION

Drawing title as built drawing
Block section Muktapur-Kishanpur

QUAD CABLE ROUTE PLAN


DRAWN BY:--

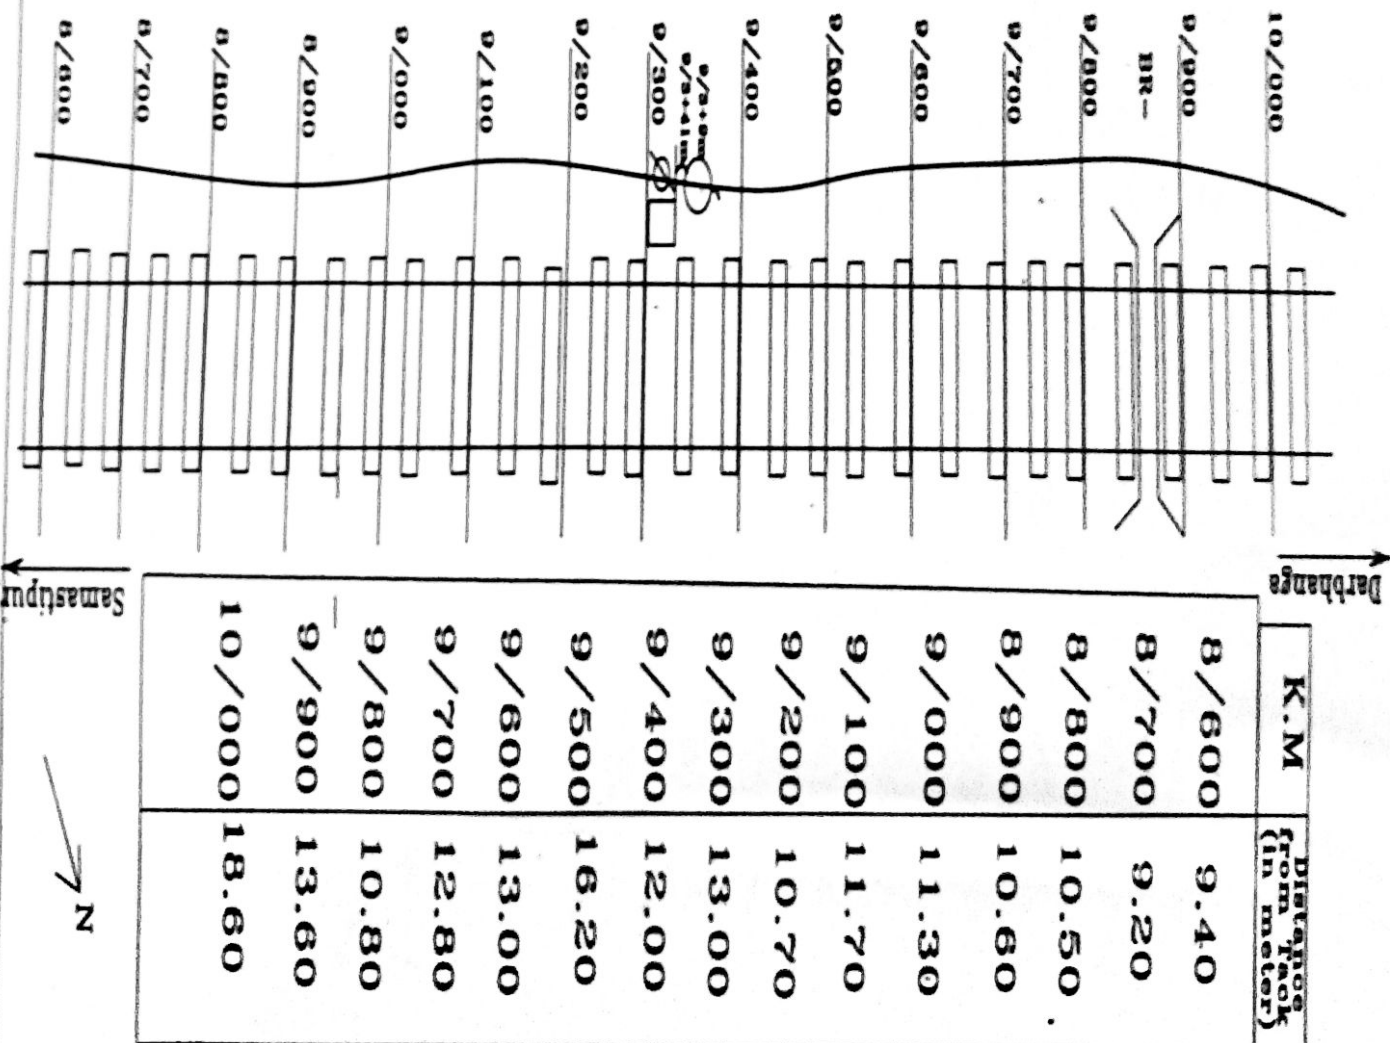

Samastipur

N

LEGEND

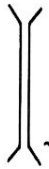Railway Track	--	
Quad cable Route	--	
Station Building	--	<div>STATION</div>
Derivation joint:--		
Level Crossing	--	
Straight Through joint	--	
G.I.Pipe	--	
Culvert/ROB	--	
ERP	--	

CONTRACTOR	SSE/T/C/MFP	ASTE/Pro./HJP	DY.CSTE/Pro./HJP
M/S.venu Engineering Works <i>Venu</i>	<i>Partner</i>		


SCALE	SHEET:-- 09
X 1 mm :4.00mm	
Y 1 mm :1.10mm	

EAST CENTRAL RAILWAY
SAMASTIPUR
DIVISION

Drawing title as built drawing
Block section Muktapur-Kishanpur

QUAD CABLE ROUTE PLAN

DRAWN BY:--

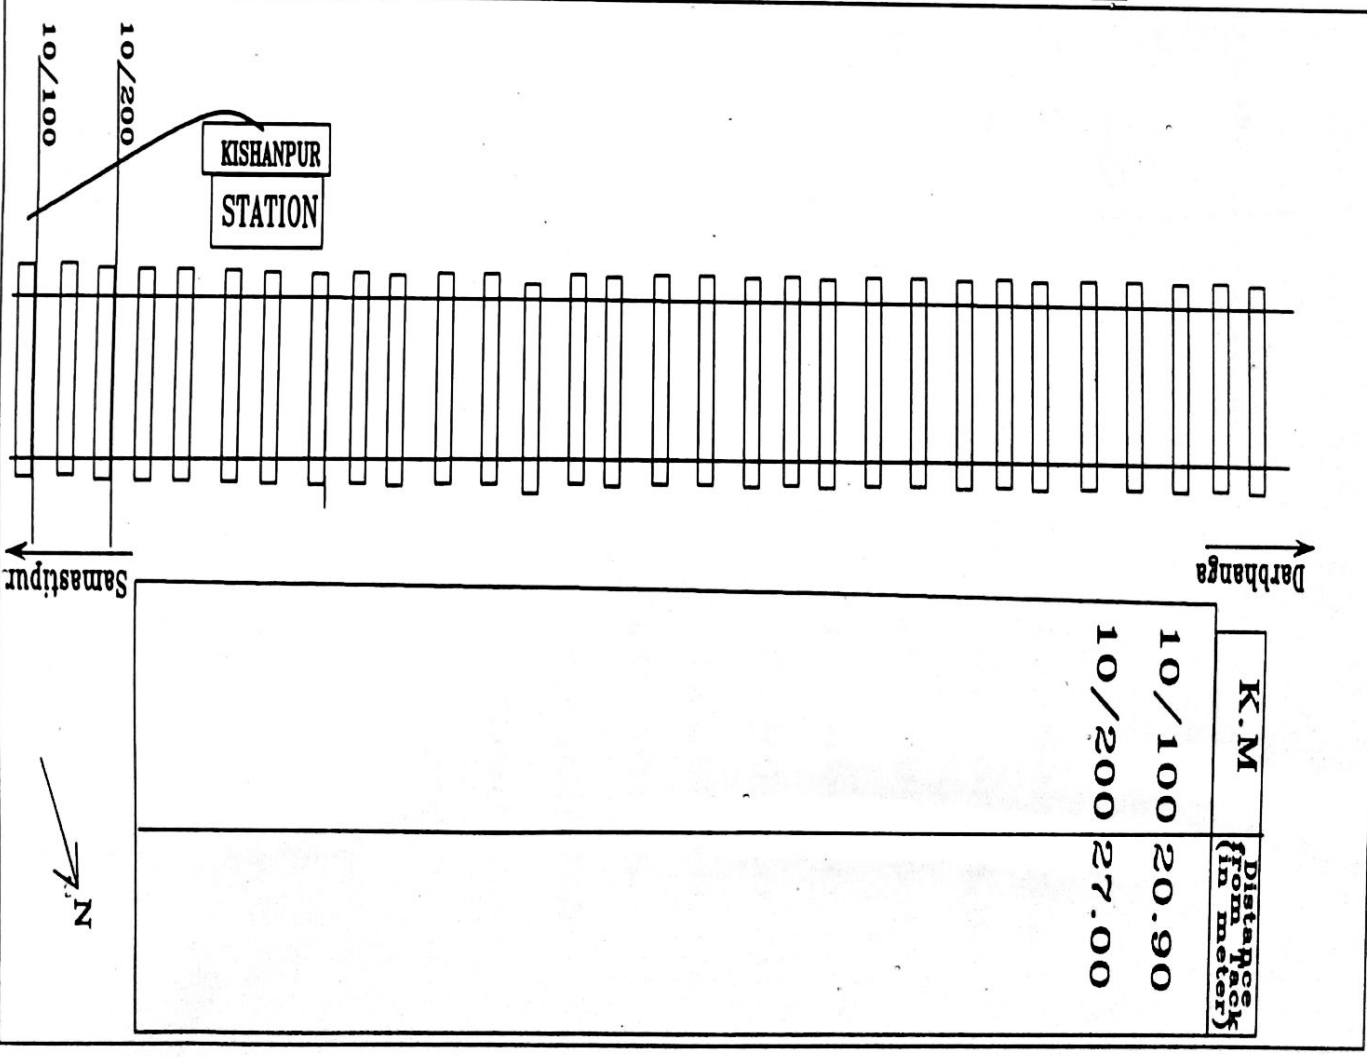

LEGEND

Railway Track

--



Qua d cable Route

--



Station Building

--



Derivation joint:-

.



Level Crossing

--



Straight Through joint

--



G.I.Pipe

--



Culvert/ROB

--



ERP

--



CONTRACTOR

USE/T/C/MFP

ASTK/Pro./HJP

DY.CSTE/Pro./HJP

M/s. PM Engineering Works

Amrith

Kisanpur

SCALE

X 1 mm : 4.00m
Y 1 mm : 1.10m

SHEET:- 10


EAST CENTRAL RAILWAY
SAMASTIPUR
DIVISION

Drawing title as built drawing

Block section Kishanpur-Rambhaddarpur

QUAD CABLE ROUTE PLAN

DRAWN BY:- Kishanpur-Rambhaddarpur

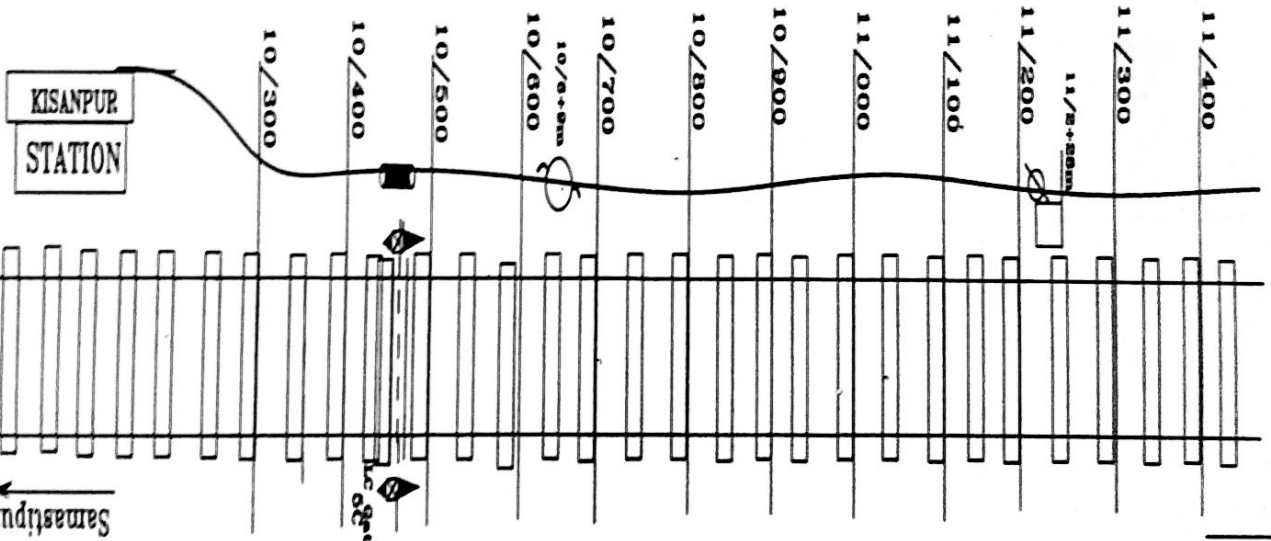

Derbanga

K.M	Distance from Track (in meter)
10/300	25.00
10/400	18.00
10/500	13.60
10/600	8.00
10/700	9.10
10/800	10.10
10/900	10.00
11/000	10.20
11/100	8.40
11/200	7.60
11/300	6.00
11/400	6.20

LEGEND

Railway Track

--



Quad cable Route

--



Station Building

--



Derivation joint:--

--



Level Crossing

--



Straight Through Joint

--



G.I. Pipe

--



Culvert/ROB

--



ERP

--



CONTRACTOR SSE/T/C/MFP ASTE/Pro./HJP DY.CSTE/Pro./HJP

M/S Sri Engineering Works

Krishna

Partners

SCALE

X 1 mm : 4.00m
Y 1 mm : 1.10m

SHEET:-- 11

EAST CENTRAL RAILWAY
SAMASTIPUR
DIVISION

Drawing title as built drawing
Block section Kishanpur-Rambhaddarpur

QUAD CABLE ROUTE PLAN


DRAWN BY:--

Darbhanga

K. M

Distance from Track (in meter)

11/500	6.80
11/600	7.00
11/700	8.70
11/800	7.80
11/900	5.80
12/000	5.70
12/100	6.40
12/200	7.40
12/300	7.00
12/400	6.40
12/500	6.00
12/600	11.20
12/700	11.00
12/800	11.40
12/900	9.30

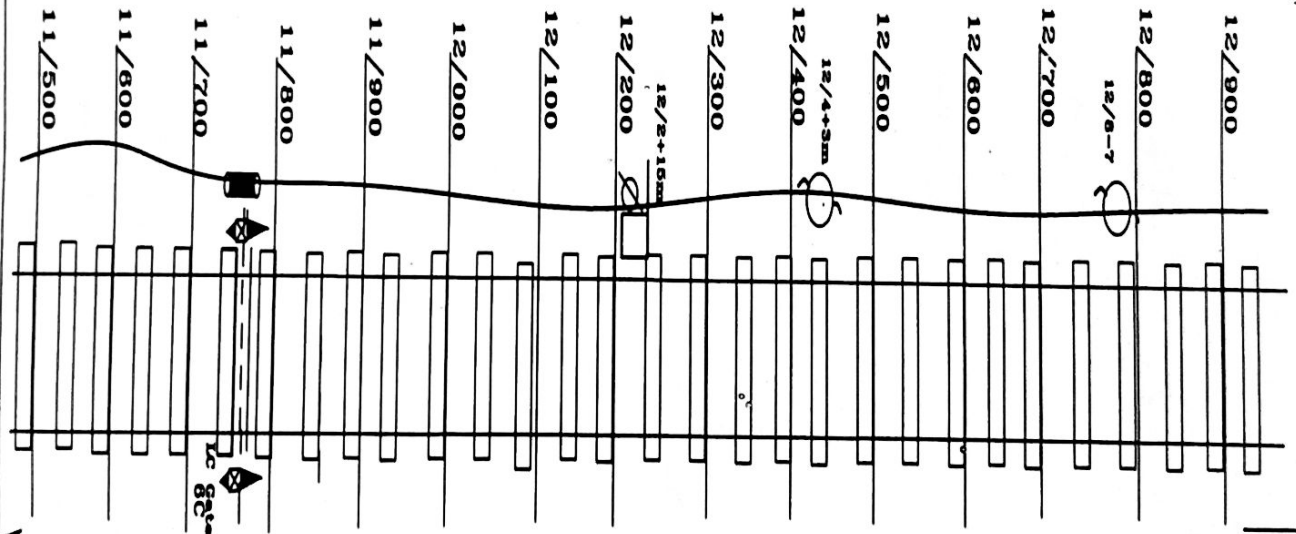

Samastipur



LEGEND

Railway Track	--	
Qua d cable Route	--	
Station Building	--	
Derivation joint:--	--	
Level Crossing	--	
Straight Throug h Joint	--	
G.I.Pipe	--	
Culvert/ROB	--	
ERP	--	

CONTRACTOR	SSE/T/C/MFP	ASTE/Pro./HJP	DY.CSTE/Pro./HJP
------------	-------------	---------------	------------------

M/s. <i>Engineering Works</i>	<i>Kindra</i>		
-------------------------------	---------------	--	--

SCALE	SHEET:- 1 2
X 1 mm : 4.00mm	
Y 1 mm : 1.10mm	


EAST CENTRAL RAILWAY
SAMASTIPUR
DIVISION

Drawing title as built drawing

Block section Kishanpur--Rambhaddarpur

QUAD CABLE ROUTE PLAN

DRAWN BY:-

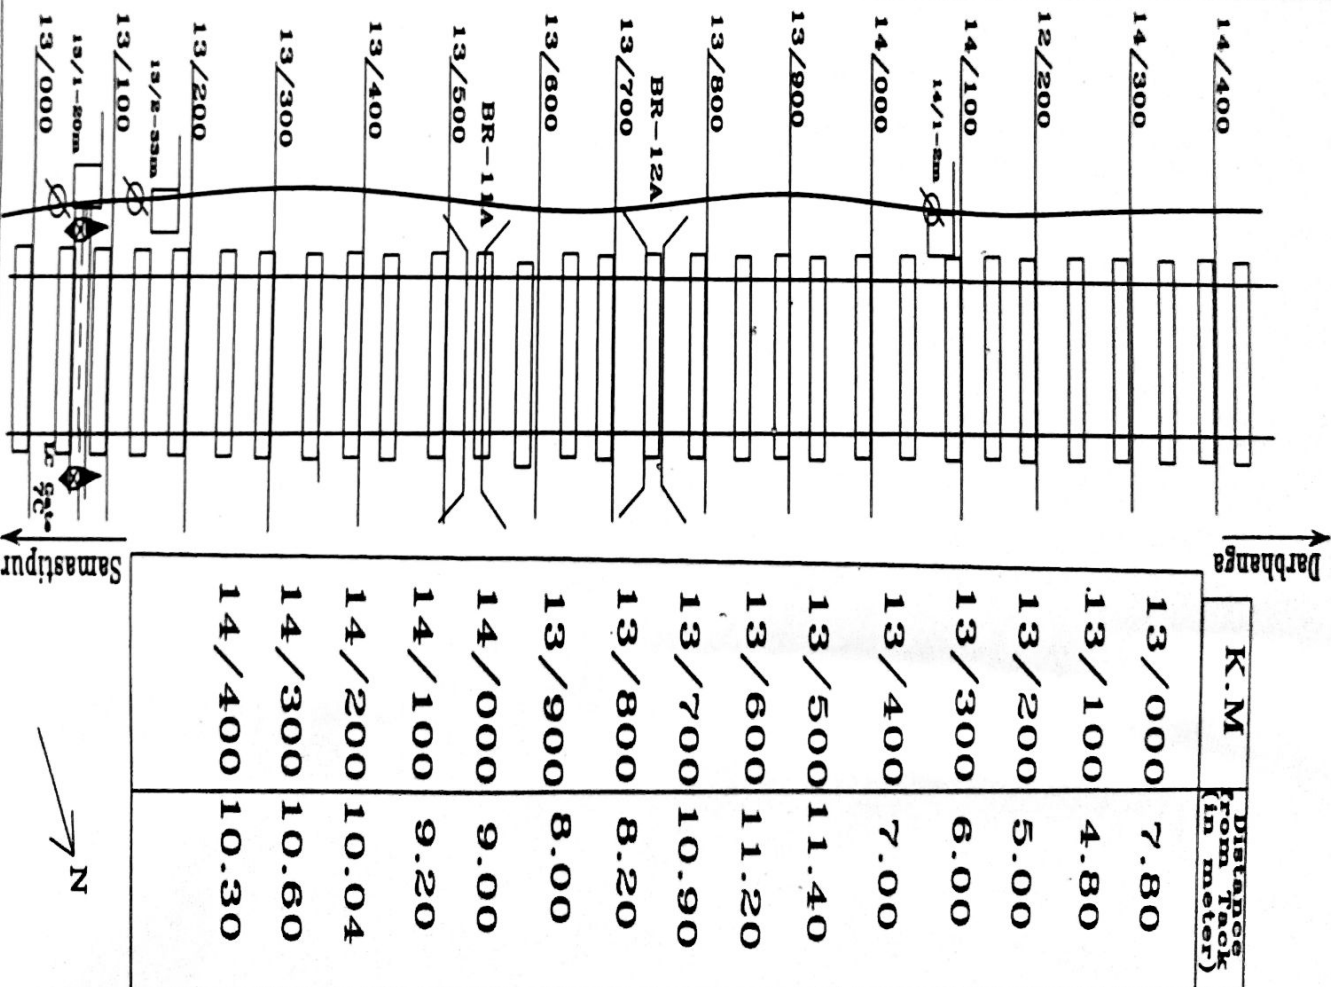

LEGEND

Railway Track	:-	
Qua d cable Route	:-	
Station Building	:-	
Derivation joint:-		
Level Crossing	:-	
Straight Through joint	:-	
G.I.Pipe	:-	
Culvert/ROB	:-	
ERP	:-	


CONTRACTOR	SSE/T/C/MFP	ASTE/Pro./HJP	DY.CSTE/Pro./HJP
			

SCALE	SHEET:- 13
X 1 mm : 4.00m	
Y 1 mm : 1.10m	

EAST CENTRAL RAILWAY
SAMASTIPUR
DIVISION

Drawing title as built drawing
Block section Kishanpur-Rambhaddarpur

QUAD CABLE ROUTE PLAN
DRAWN BY:-

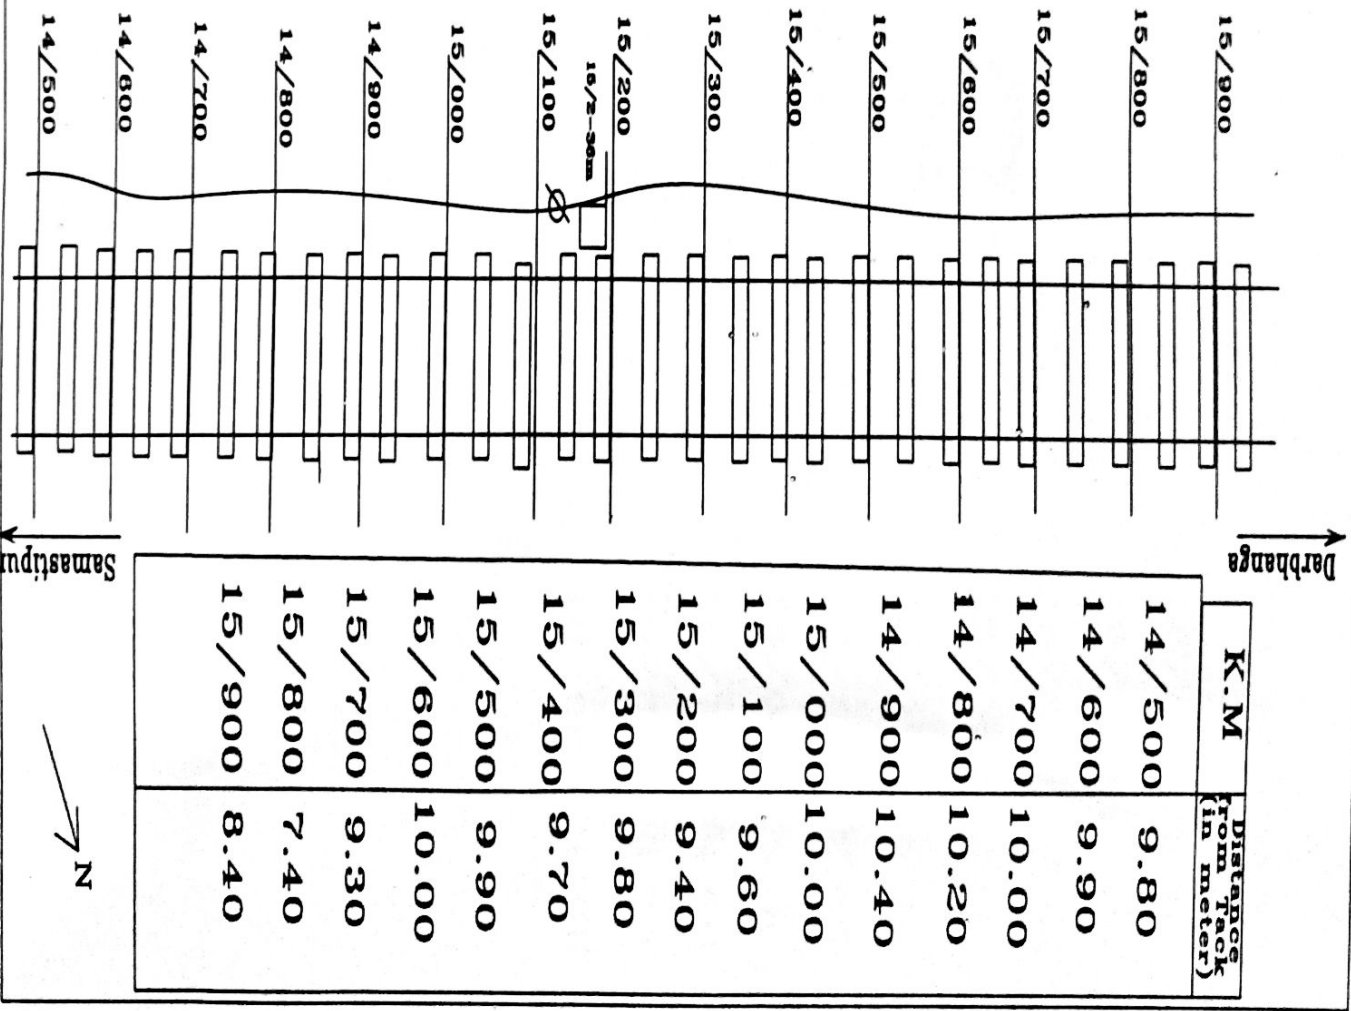

LEGEND

Railway Track

--



Qua d cable Route

--



Station Building

--



Derivation joint:--

--



Level Crossing

--



Straight Through joint

--



G.I. Pipe

--



Culvert/ROB

--



ERP

--



CONTRACTOR

SSR/T/C/MDP

ASTE/Pro./HJP

DY.CSTE/Pro./HJP

M/S. S. S. Engineering Works

Kishanpur

Kishanpur

SCALE

X 1 mm : 4.00m

Y 1 mm : 1.10m

SHEET:- 14


EAST CENTRAL RAILWAY
SAMASTIPUR
DIVISION

Drawing title as built drawing

Block section Kishanpur-Rambhaddarpur

QUAD CABLE ROUTE PLAN

DRAWN BY:- Kishanpur-Rambhaddarpur

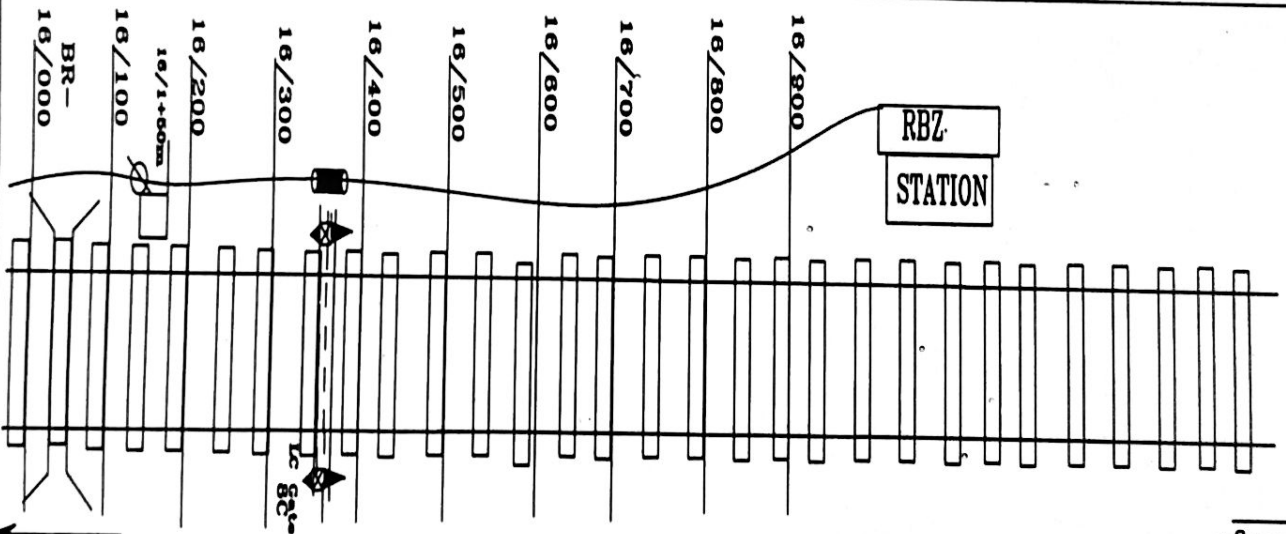

Derbanga

K.M

Distance from track (in meter)

16/000	7.90
16/100	12.00
16/200	11.40
16/300	9.70
16/400	15.80
16/500	13.90
16/600	13.00
16/700	14.00
16/800	26.00
16/900	26.00

Samastipur

N

LEGEND

Railway Track	--	
Qua d cable Route	--	
Station Building	--	STATION
Derivation joint:--	--	
Level Crossing	--	
Straight Thorough joint	--	
G.I.Pipe	--	
Culvert/ROB	--	
ERP	--	

CONTRACTOR	SSE/T/C/MFP	ASTE/Pro./HJP	DY.CSTE/Pro./HJP
------------	-------------	---------------	------------------

M/s. Engineering Works <i>Amrinder</i>	<i>Kishu</i>		
<i>Verma</i>	<i>Tanver</i>		


SCALE	SHEET:- 15
X 1 mm : 4.00m	
Y 1 mm : 1.10m	

EAST CENTRAL RAILWAY
SAMASTIPUR
DIVISION

Drawing title as built drawing
Block section Kisanpur-Rambhaddarpur

QUAD CABLE ROUTE PLAN

DRAWN BY:-

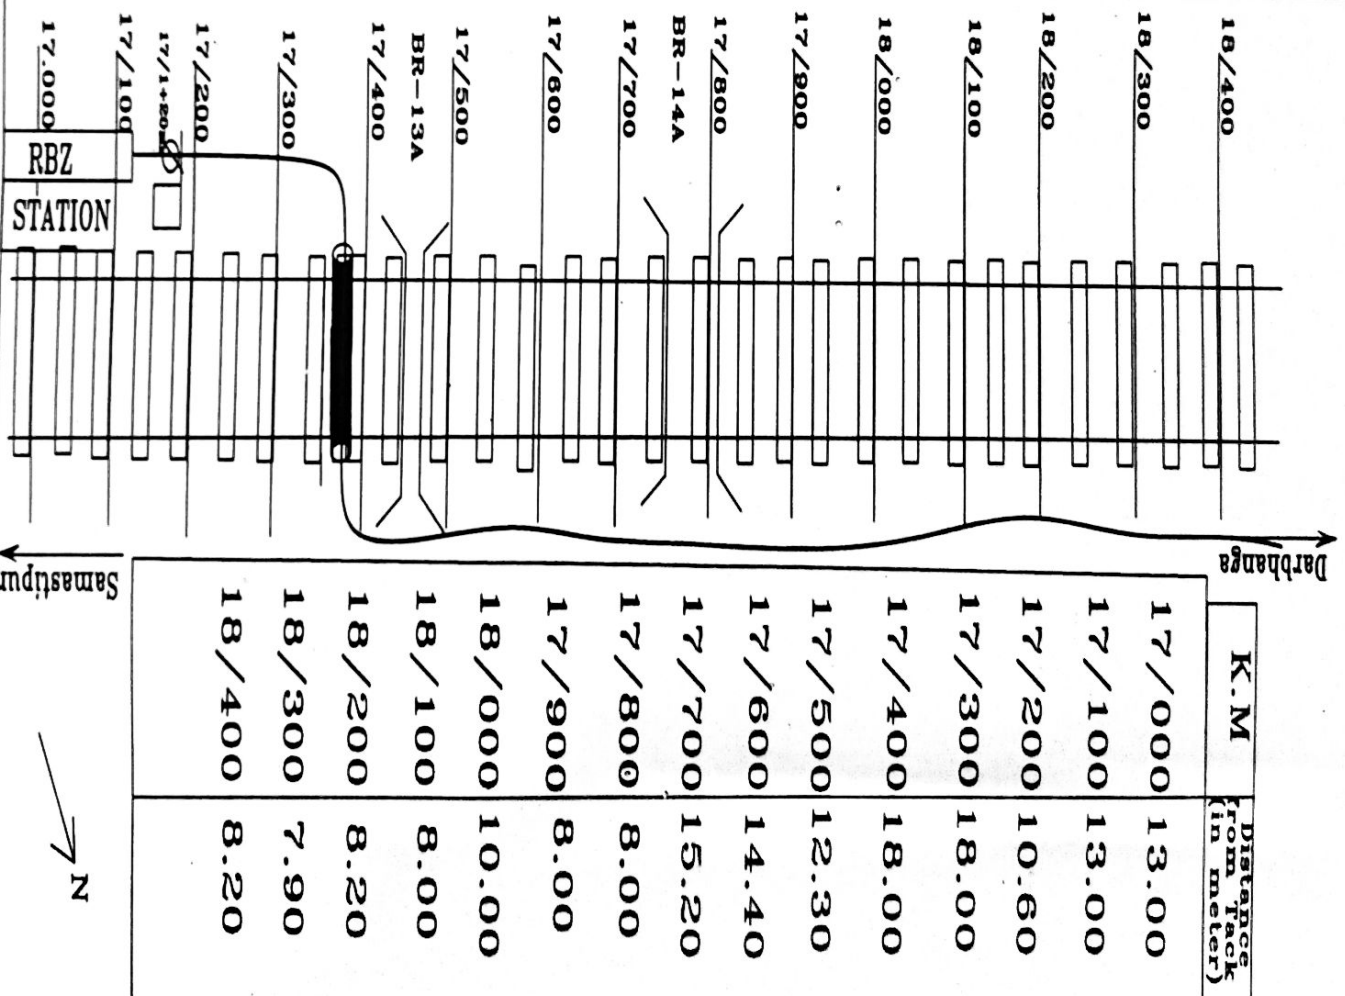

LEGEND

Railway Track	--	
Quad cable Route	--	
Station Building	--	STATION
Derivation joint:-	--	
Level Crossing	--	
Straight Through joint	--	
G.I.Pipe	--	
Culvert/ROB	--	
ERP	--	


CONTRACTOR	SSE/T/C/MFP	ASTE/Pro./HJP	DY.CSTE/Pro./HJP
<i>MS. S. Engineering Works</i>	<i>Amey</i>		
SCALE	SHEET:- 16		
X 1 mm : 4.00m			
Y 1 mm : 1.10m			

EAST CENTRAL RAILWAY
SAMASTIPUR
DIVISION

Drawing title as built drawing

QUAD CABLE ROUTE PLAN

DRAWN BY:-

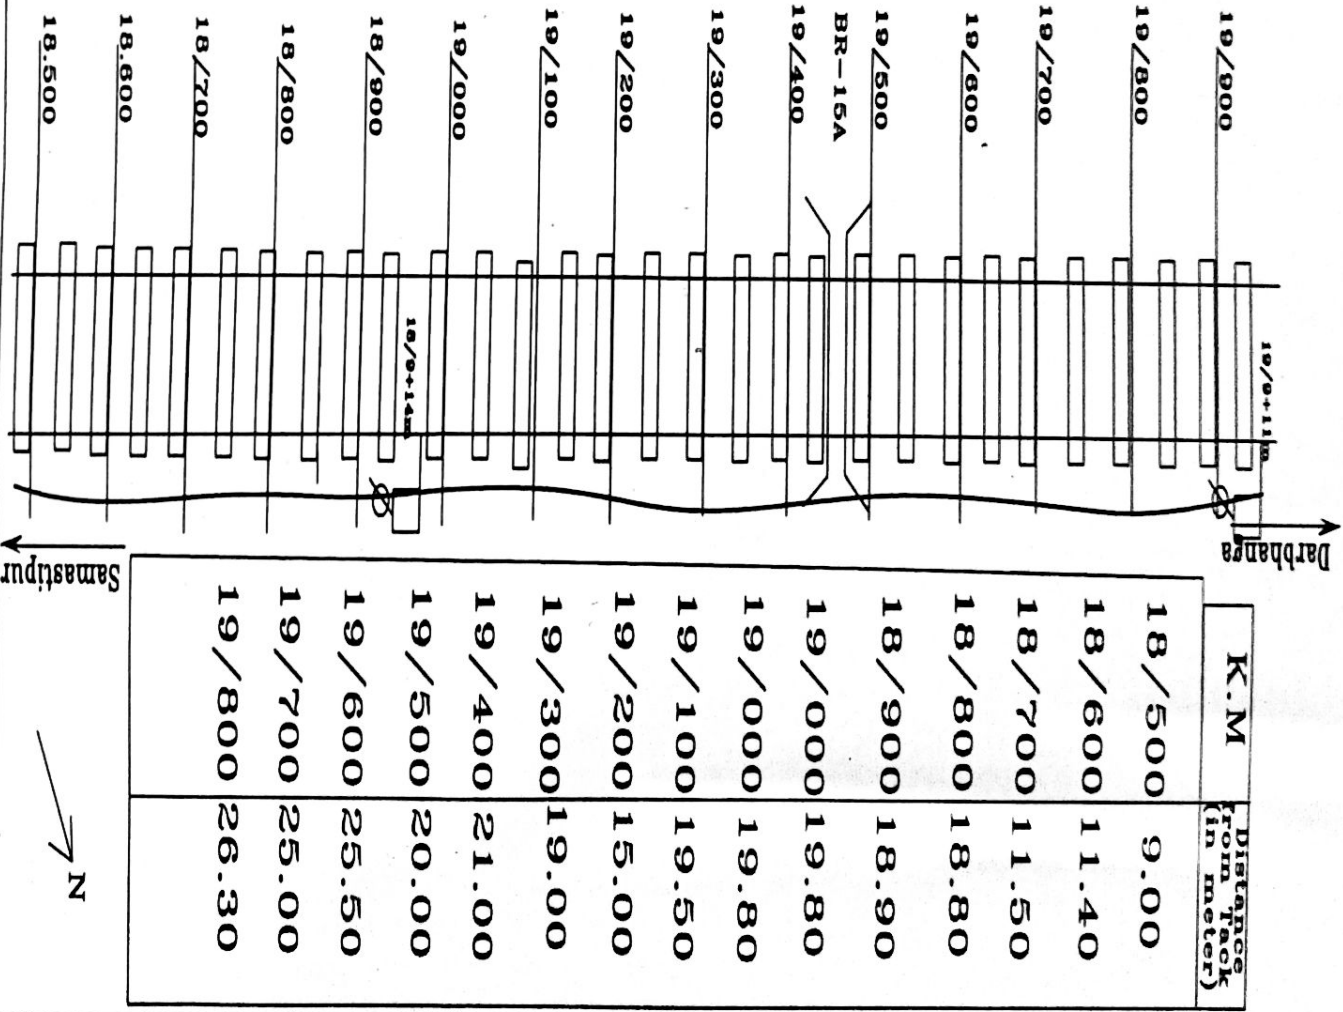

LEGEND

Railway Track

--



Qua d cable Route

--



Station Building

--



Derivation joint:--



Level Crossing

--



Straight Through joint

--



G.I.Pipe

--



Culvert/ROB

--



ERP

--



CONTRACTOR

SSE/T/C/MFP

ASTE/Pro./HJP

DY.CSTE/Pro./HJP

M/S. Engineering Works

Amol

Partner

SCALE

X 1 mm : 4.00m

Y 1 mm : 1.10m

SHEET:-- 17

EAST CENTRAL RAILWAY
SAMASTIPUR
DIVISION

Drawing title as built drawing

Block section Rambhaddarpur-Haiahat

QUAD CABLE ROUTE PLAN


DRAWN BY:--

Darbhanga

K.M

Distance from track (in meter)

20/000	21.00
20/100	20.80
20/200	20.90
20/300	20.00
20/400	21.00
20/500	17.00
20/600	15.00
20/700	16.20
20/800	16.00
20/900	18.00
21/000	17.50
21/100	17.20
21/200	17.80
21/300	18.00
21/400	22.00

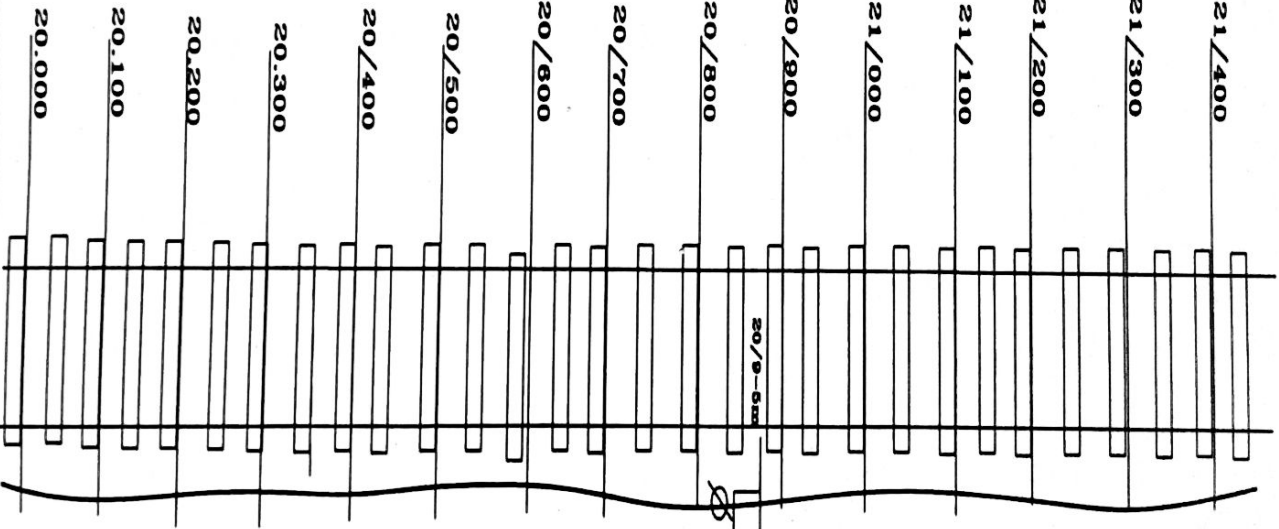

Samastipur

N


LEGEND

Railway Track	--	
Quad cable Route	--	
Station Building	--	<div>STATION</div>
Derivation joint:--	--	
Level Crossing	--	
Straight Through joint	--	
G.I. Pipe	--	
Culvert/ROB	--	
ERP	--	

CONTRACTOR	SSE/T/C/MFP	ASTE/Pro./HJP	DY.CSTE/Pro./HJP
M/s. Engineering Works	<i>Kush</i>		
Verma Partner			
SCALE	X 1 mm : 4.00m Y 1 mm : 1.10m	SHEET:- 18	

EAST CENTRAL RAILWAY SAMASTIPUR DIVISION

Drawing title as built drawing
Block section Rambhaddarpur-Haiaerhat
QUAD CABLE ROUTE PLAN
DRAWN BY:-

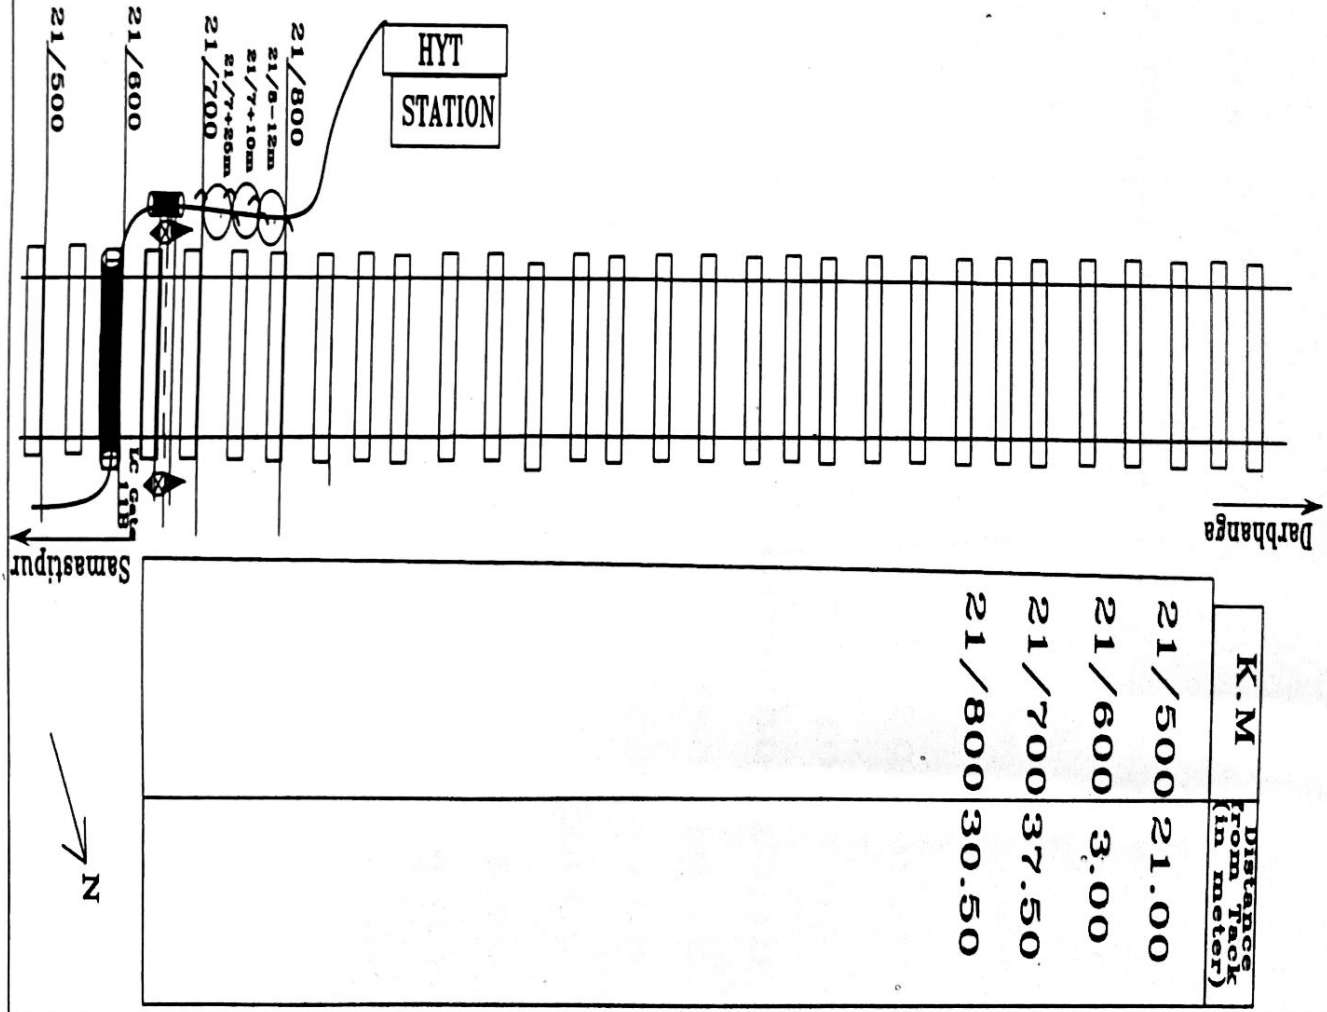

LEGEND

Railway Track

11



Quadrant Cable Route

11



Station Building

11

STATION

Derivation joint:—



Level Crossing

1



Straight Through Joint

i



G.I. Pipe

1



Culvert/ROB

1



ERP

1



CONTRACTOR	NSR/T/C/MFP	ASTR/PRO./HJP	DY.CSTR/PRO./HJP
------------	-------------	---------------	------------------

Mrs. J. H. Edwards

Kindly

Partner

SCALES

X	1	num	: 4.0000
Y	1	num	: 1.1000

SHEET: - 19


EAST CENTRAL RAILWAY

**SAMASTIPUR
DIVISION**

Drawing title as built drawing

QUAD CABLE ROUTE PLAN

DRAWN BY:--

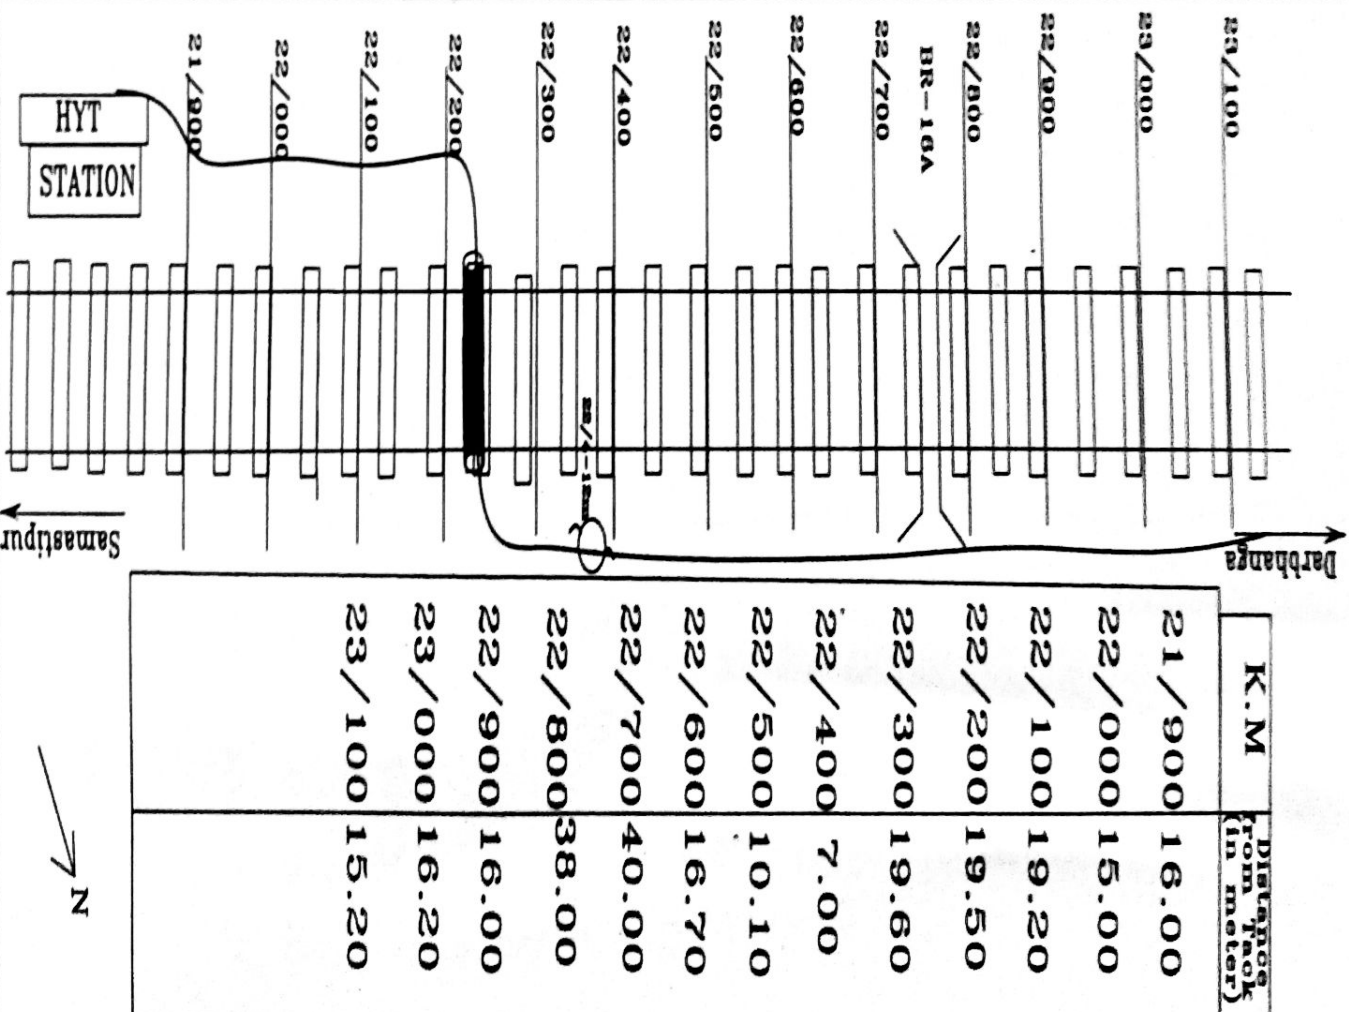

LEGEND

Railway Track	==	
Quad cable Route	==	
Station Building	==	STATION
Derivation joint:-	==	
Level Crossing	==	
Straight Through joint	==	
G.I. Pipe	==	
Culvert/ROB	==	
ERP	==	

CONTRACTOR	SSE/T/C/MFP	ASTE/Pro./HJP	DY.CSTE/Pro./HJP
------------	-------------	---------------	------------------

M/s. J. Engineering Works Jodhpur	Kishu		
--------------------------------------	-------	--	--


SCALE X 1 mm : 4.00m Y 1 mm : 1.10m	SHEET:- 20
---	------------

EAST CENTRAL RAILWAY
SAMASTIPUR
DIVISION

Drawing title as built drawing
Block section Haighat-Thalwara

QUAD CABLE ROUTE PLAN

DRAWN BY:-

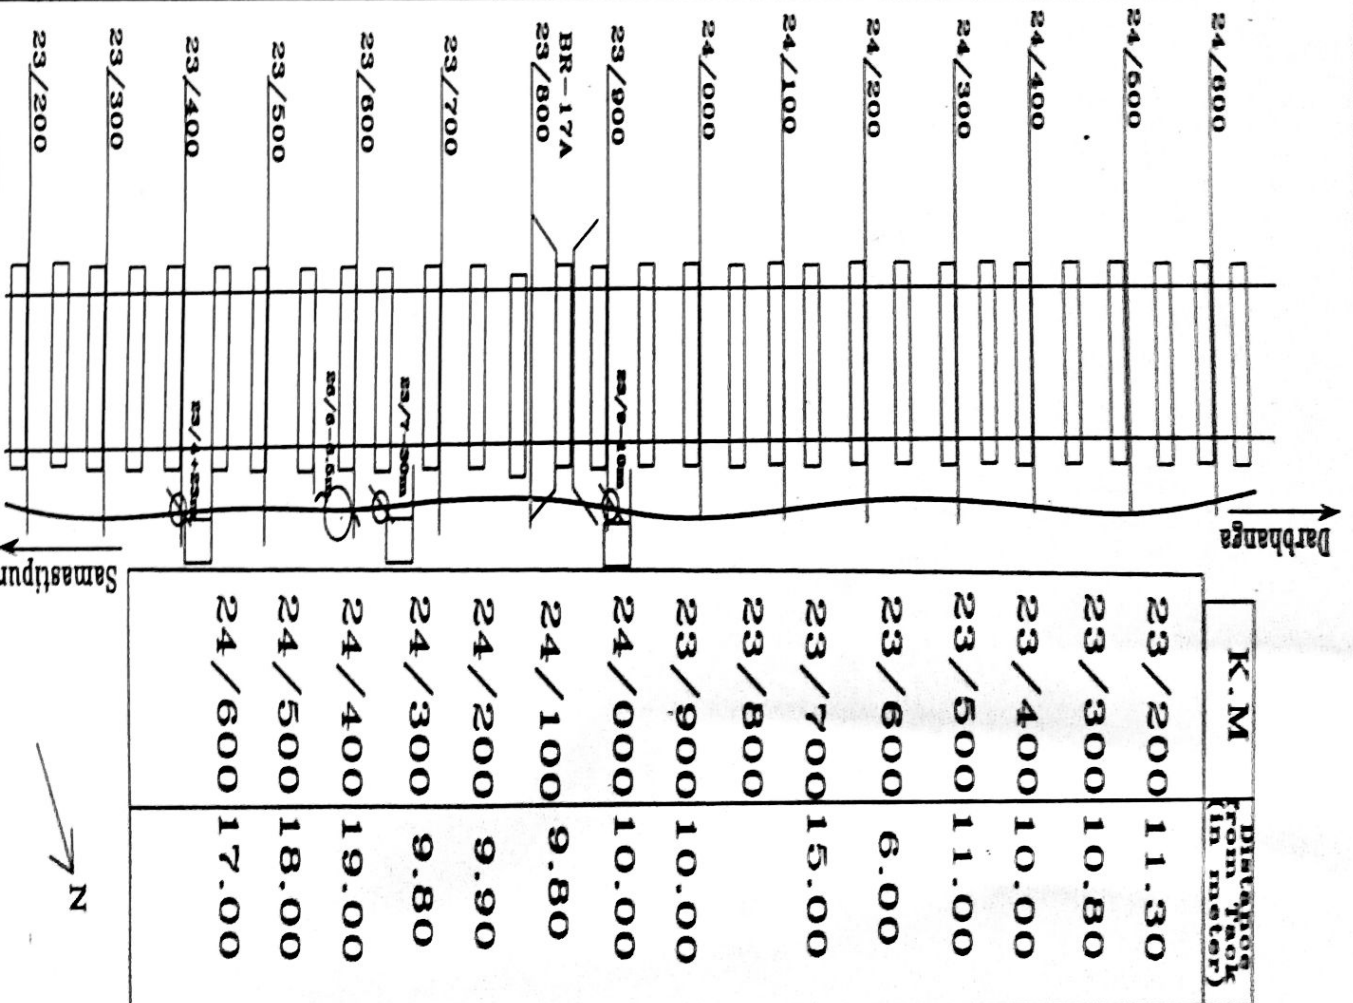

LEGEND

Railway Track	--	
Quad cable Route	--	
Station Building	--	<div>STATION</div>
Derivation joint:--	--	
Level Crossing	--	
Straight Through joint	--	
G.I. Pipe	--	
Culvert/ROB	--	
ERP	--	

CONTRACTOR	HSR/T/C/MTP	ASTR/PRO./HJP	DY.CSTE/PRO./HJP
M/S. SRI Engineering Works <i>Arbuj</i> <i>Partner</i>	<i>Kruph</i>		


SCALE
X 1 mm : 4.00m
Y 1 mm : 1.10m
SHEET:- 21

EAST CENTRAL RAILWAY
SAMASTIPUR
DIVISION


Drawing title as built drawing
Block section Halaqhat-Thalwara

QUAD CABLE ROUTE PLAN

DRAWN BY:-

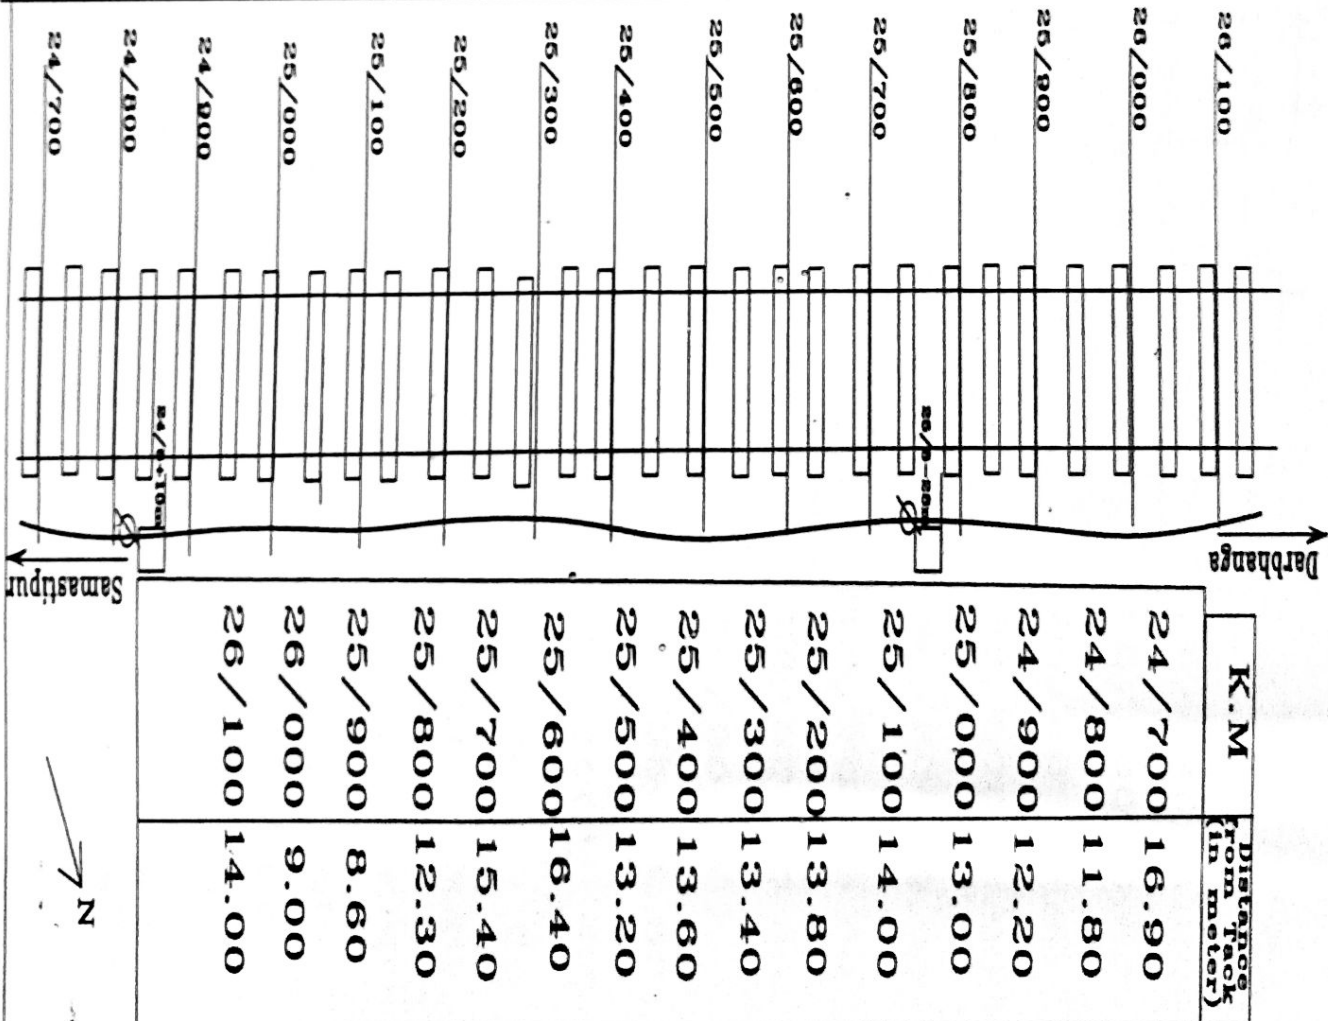

LEGEND

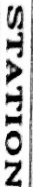Railway Track	::-	
Qua d cable Route	::-	
Station Building	::-	
Derivation joint:-		
Level Crossing	::-	
Straight Through Joint	::-	
G.I.Pipe	::-	
Culvert/ROB	::-	
ERP	::-	

CONTRACTOR	SSE/T/C/MFP	ASTE/Pro./HJP	DY.CSTE/Pro./HJP
------------	-------------	---------------	------------------


SCALE	X 1 mm : 4.00m Y 1 mm : 1.10m	SHEET:- 22
-------	----------------------------------	------------

EAST CENTRAL RAILWAY
SAMASTIPUR
DIVISION

Drawing title as built drawing
Block section Haighat-Thalwara

QUAD CABLE ROUTE PLAN

DRAWN BY:-

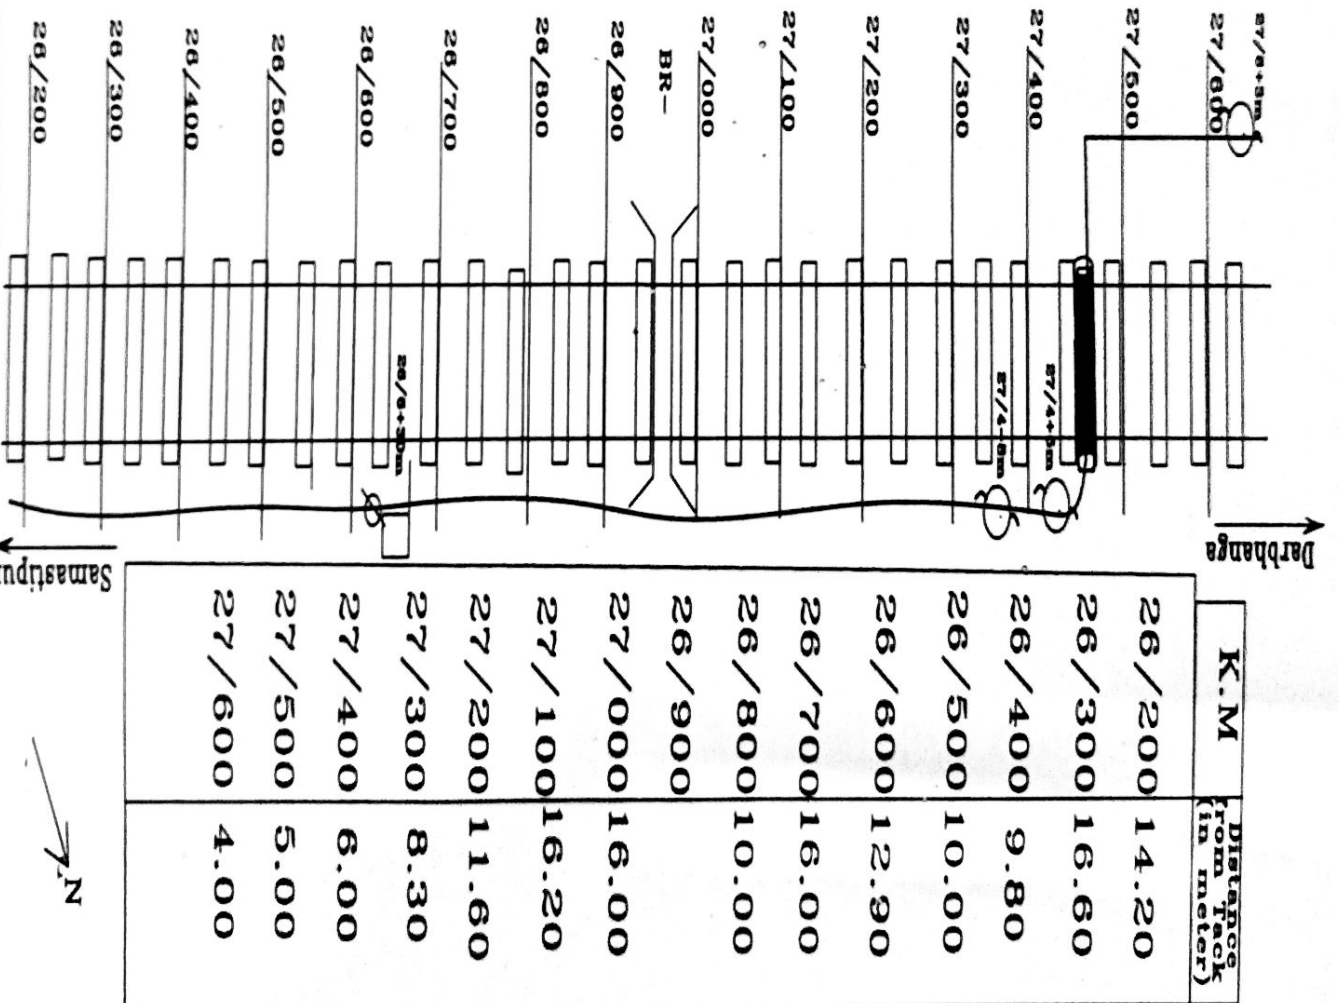

N

LEGEND

Railway Track	--	
Qua d cable Route	--	
Station Building	--	
Derivation joint:--		
Level Crossing	--	
Straight Through joint	--	
G.I.Pipe	--	
Culvert/ROB	--	
ERP	--	

CONTRACTOR	SSE/T/C/MPP	ASTE/Pro./HJP	DY.CSTE/Pro./HJP
------------	-------------	---------------	------------------

			
---	---	--	--


SCALE		SHEET:-23
X 1 mm :4.00mm		
X 1 mm :1.10mm		

EAST CENTRAL RAILWAY
SAMASTIPUR
DIVISION

Drawing title as built drawing
Block section Haighat-Thalwara

QUAD CABLE ROUTE PLAN

DRAWN BY:-

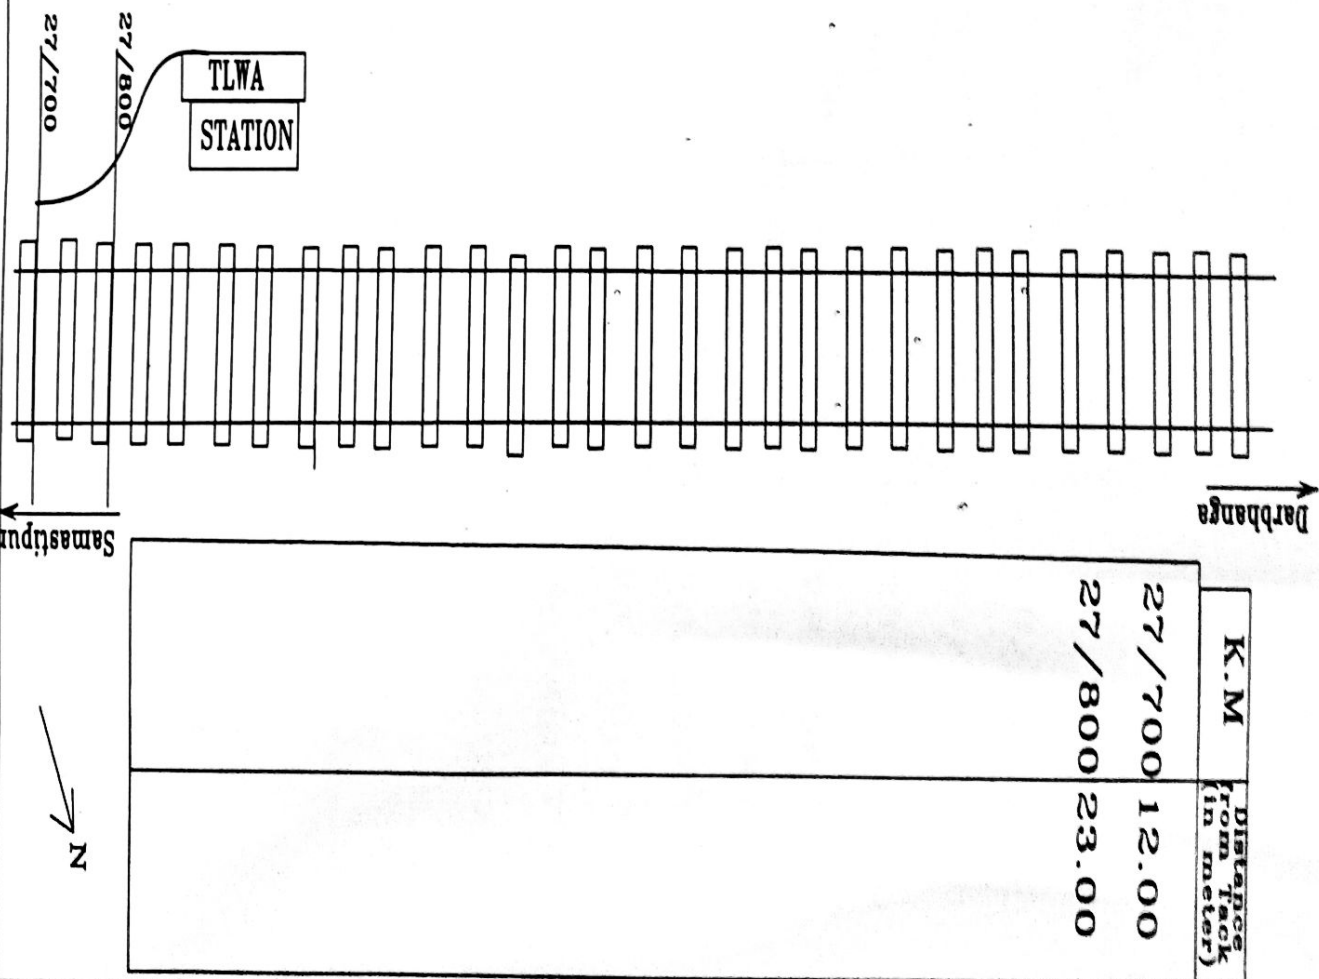

LEGEND

Railway Track	--	
Qua d cable Route	--	
Station Building	--	
Derivation joint:--	--	
Level Crossing	--	
Straight Through Joint	--	
G.I.Pipe	--	
Culvert/ROB	--	
ERP	--	

CONTRACTOR	SSE/T/C/MFP	ASTE/Pro./HJP	DY.CSTE/Pro./HJP
------------	-------------	---------------	------------------

Ms. Senu Engineering Works

Arjun

Mr. Patil


SCALE	SHEET:- 24
X 1 mm : 4.00m	
Y 1 mm : 1.10m	

EAST CENTRAL RAILWAY
SAMASTIPUR
DIVISION

Drawing title as built drawing
Block section Thalwara-LSI

QUAD CABLE ROUTE PLAN

DRAWN BY:-

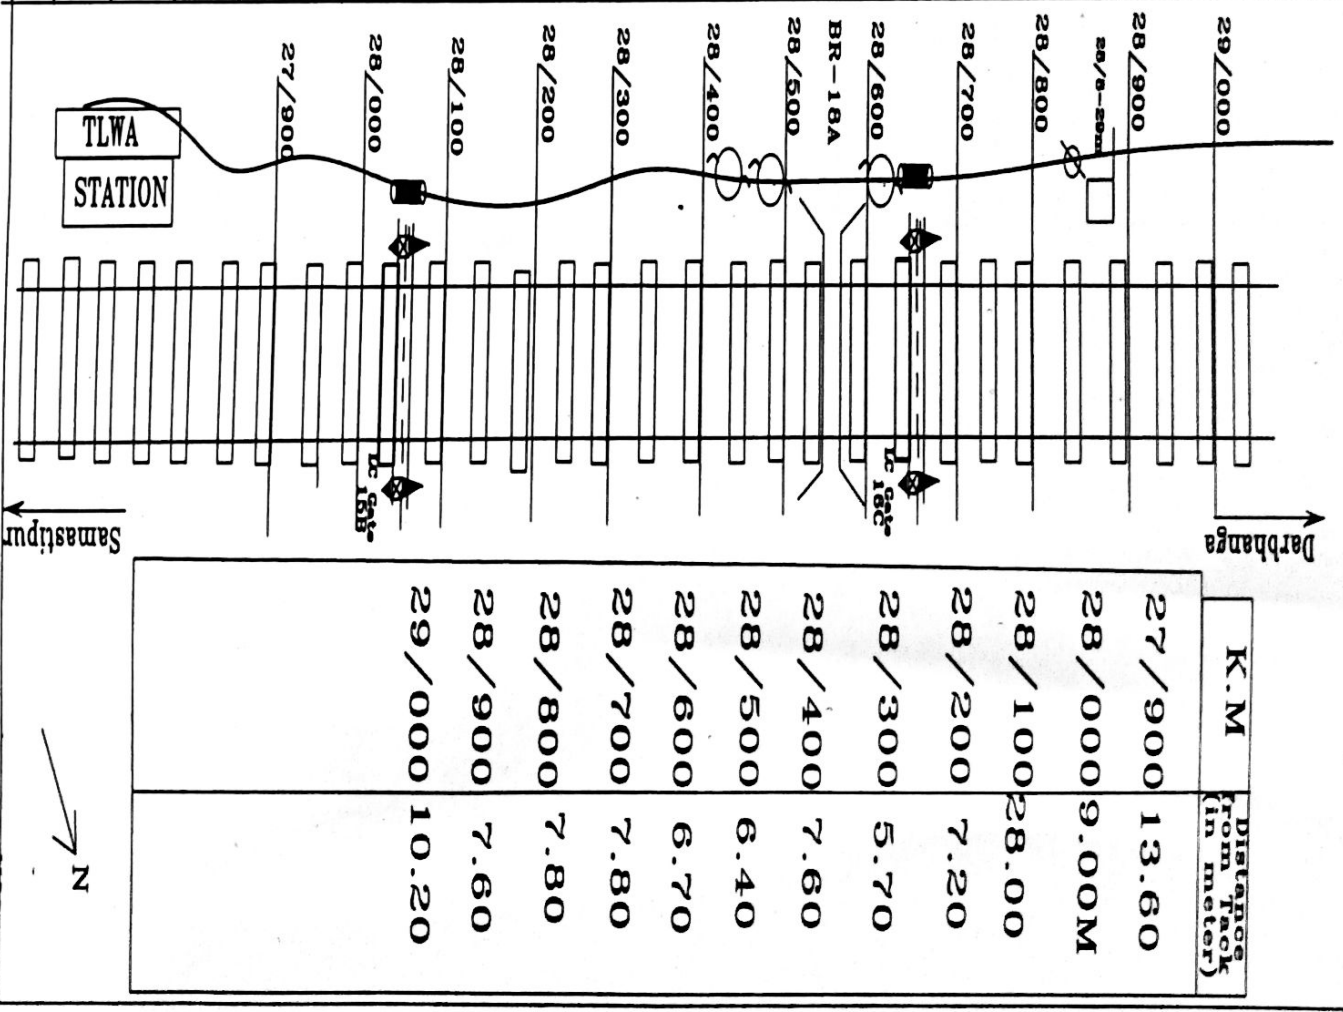

LEGEND

Railway Track	--	
Quad cable Route	--	
Station Building	--	
Derivation joint:-	--	
Level Crossing	--	
Straight Through joint	--	
G.I. Pipe	--	
Culvert/ROB	--	
ERP	--	

CONTRACTOR	SSE/T/C/MFP	ASTE/Pro./HJP	DY.CSTE/Pro./HJP
------------	-------------	---------------	------------------


SCALE	X 1 mm : 4.00mm Y 1 mm : 1.10mm	SHEET:-25
-------	------------------------------------	-----------

EAST CENTRAL RAILWAY
SAMASTIPUR
DIVISION

Drawing title as built drawing
Block section Thalwara-LSI

QUAD CABLE ROUTE PLAN

DRAWN BY:-

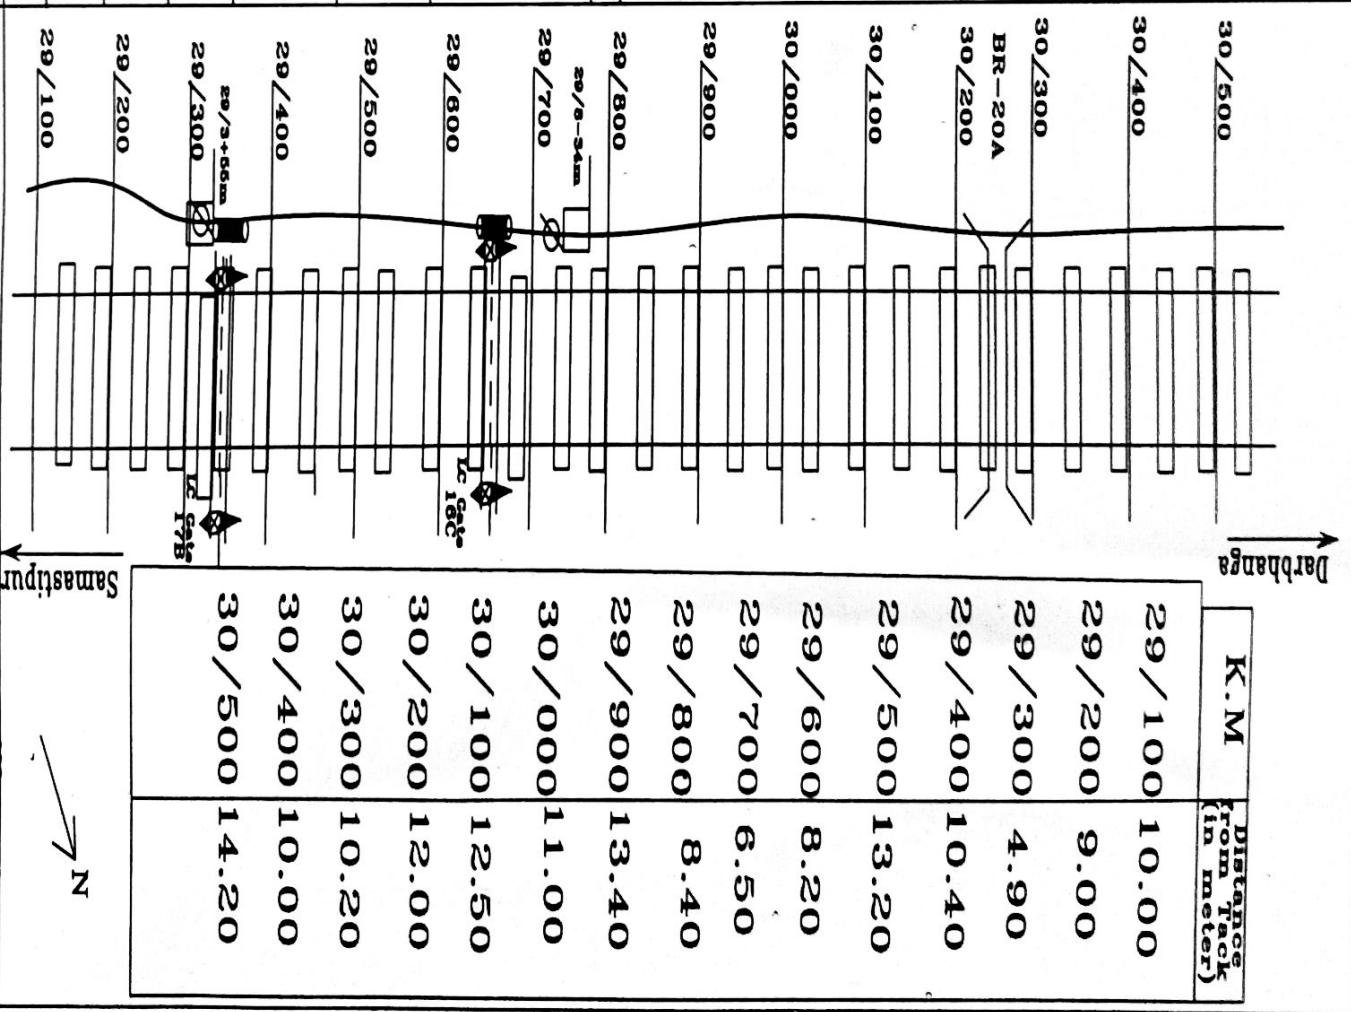

Darbhanga

Samastipur



LEGEND

Railway Track

--



Quaid cable Route

--



Station Building

--



Derivation joint:-

--



Level Crossing

--



Straight Through joint

--



G.I.Pipe

--



Culvert/ROB

--



ERP

--



CONTRACTOR

SSE/T/C/MET

ASTE/Pro./BJP

DY.CSTE/Pro./BJP

13/5/2010 Engineering Wd'rs

Arshad

Verma Partner

SCALE

X 1 mm = 4.00m
Y 1 mm = 1.10m


SHEET:- 26

EAST CENTRAL RAILWAY
SAMASTIPUR
DIVISION


Drawing title as built drawing
Block section Thalwara-LSI

QUAD CABLE ROUTE PLAN

DRAWN BY:-

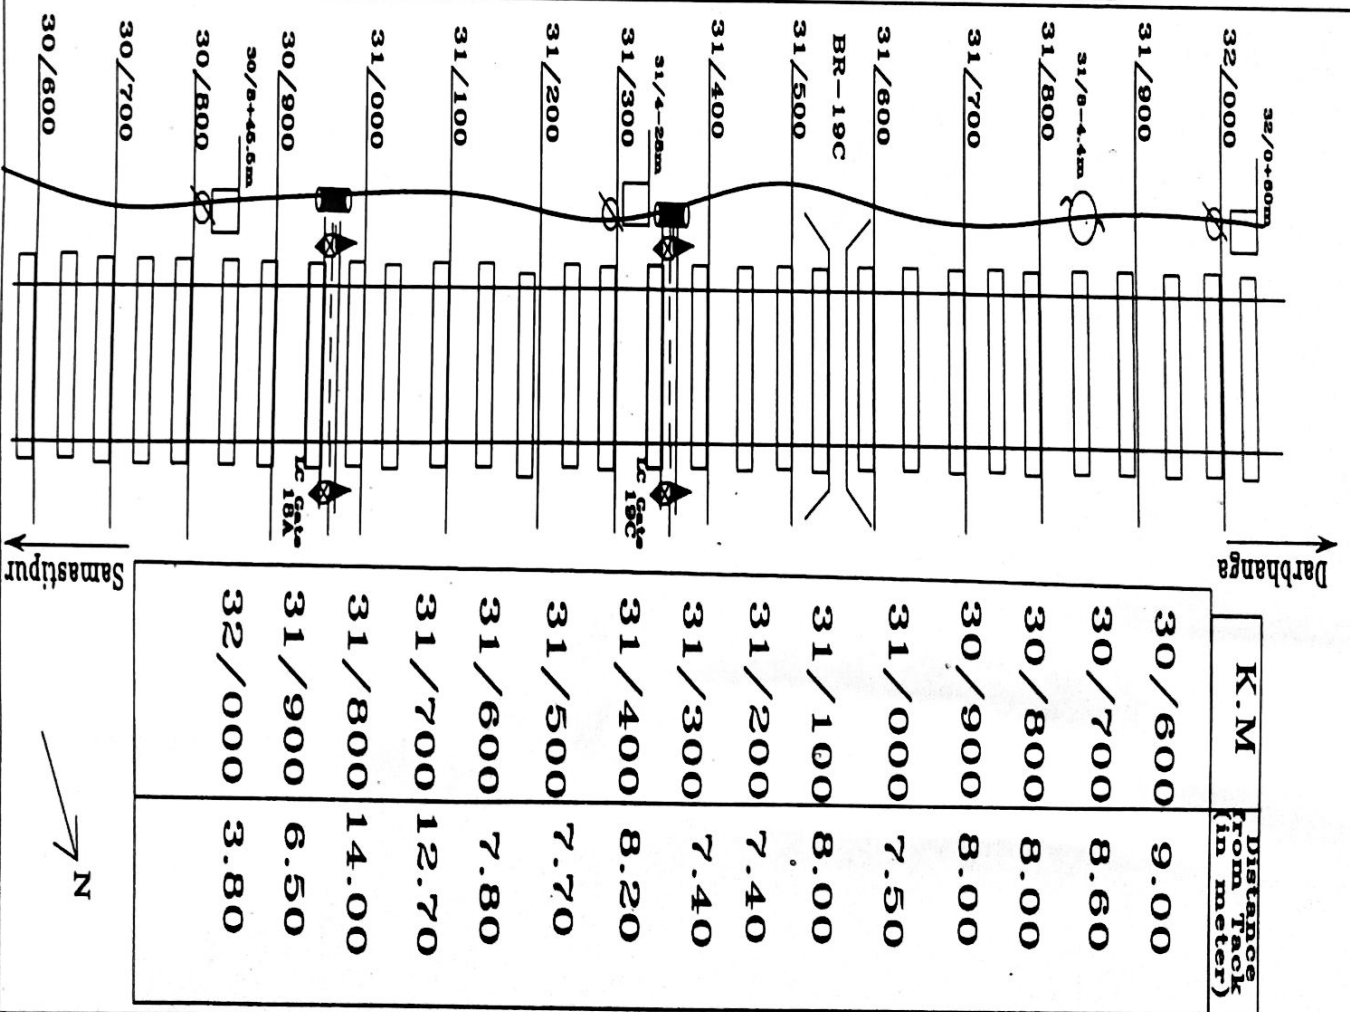

LEGEND

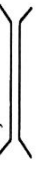Railway Track	--	
Quad cable Route	--	
Station Building	--	<div>STATION</div>
Derivation joint:--		
Level Crossing	--	
Straight Through Joint	--	
G.I. Pipe	--	
Culvert/ROB	--	
ERP	--	


CONTRACTOR	SSE/T/C/MFP	ASTE/Pro./HJP	DY.CSTE/Pro./HJP
M/S. <i>em Engineering Works</i>	<i>Amrith</i>		
<i>Partner</i>			
SCALE	SHEET:--27		
X 1 mm :4.00mm			
Y 1 mm :1.10mm			

EAST CENTRAL RAILWAY
SAMASTIPUR
DIVISION

Drawing title as built drawing
Block section Thalwara-LSI


QUAD CABLE ROUTE PLAN

DRAWN BY:--

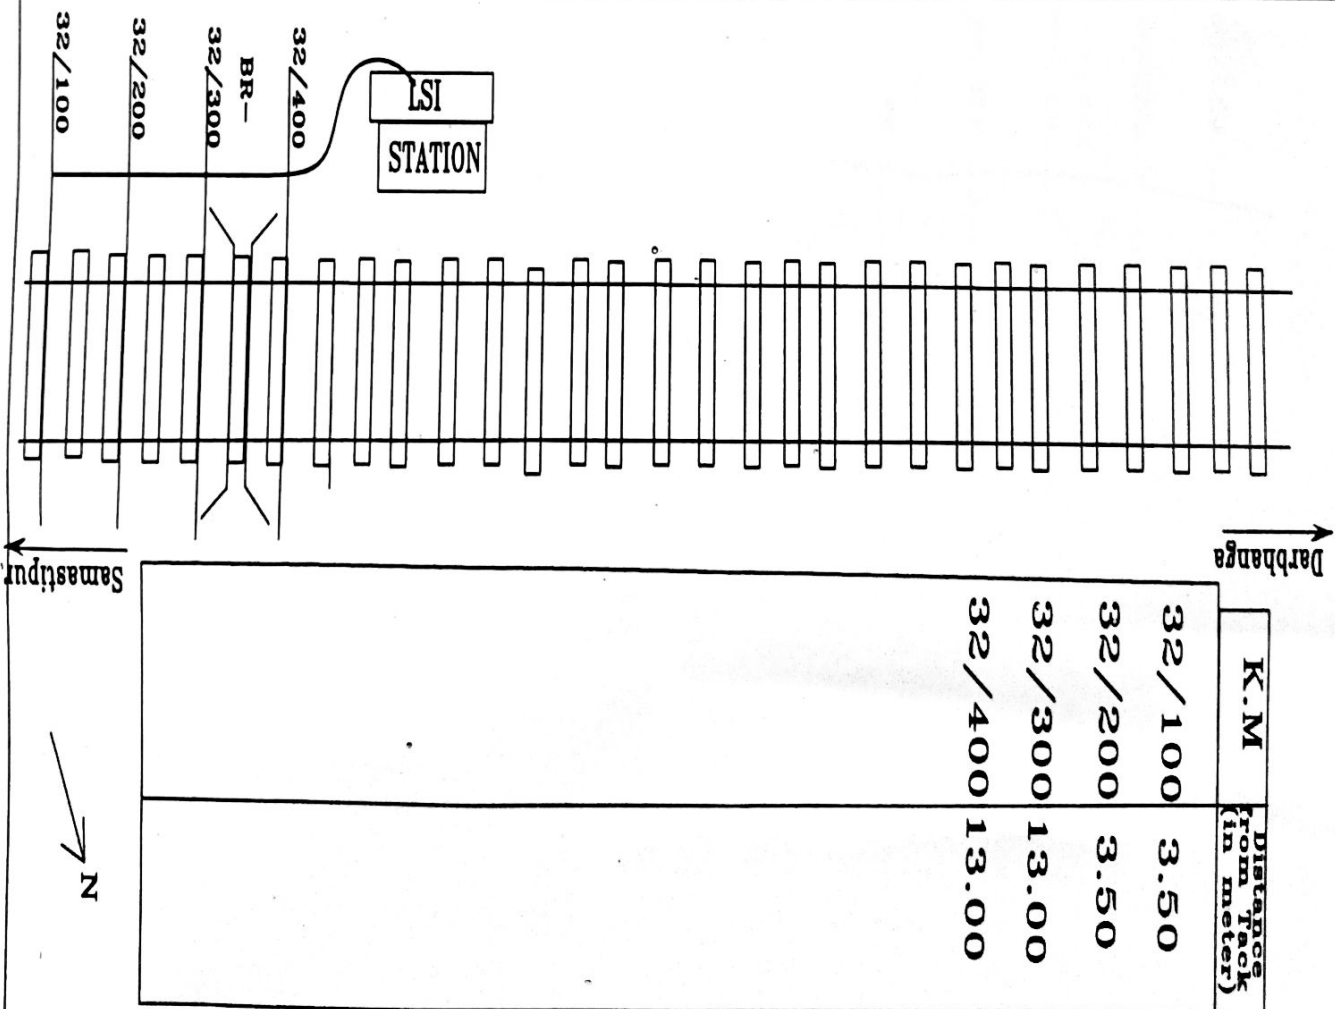


LEGEND

Rialway Track	:-	
qua d cable Route	:-	
Station Building	:-	<div>STATION</div>
Derivation joint:-		
Level Crossing	:-	
Straight Through joint	:-	
G.I.Pipe	:-	
Culvert/ROB	:-	
ERP	:-	
CONTRACTOR	SSR/T/C/MFP	ASTR/Pro./HJP
SSR Engineering Works 		
SSR 		
SCALE		SHEET:-28
X 1 mm = 4.00m		
Y 1 mm = 1.10m		
EAST CENTRAL RAILWAY		
SAMASTIPUR		
DIVISION		
Drawing title as built drawing		
Block section LSI-DBG		
QUAD CABLE ROUTE PLAN		
DRAWN BY:-		

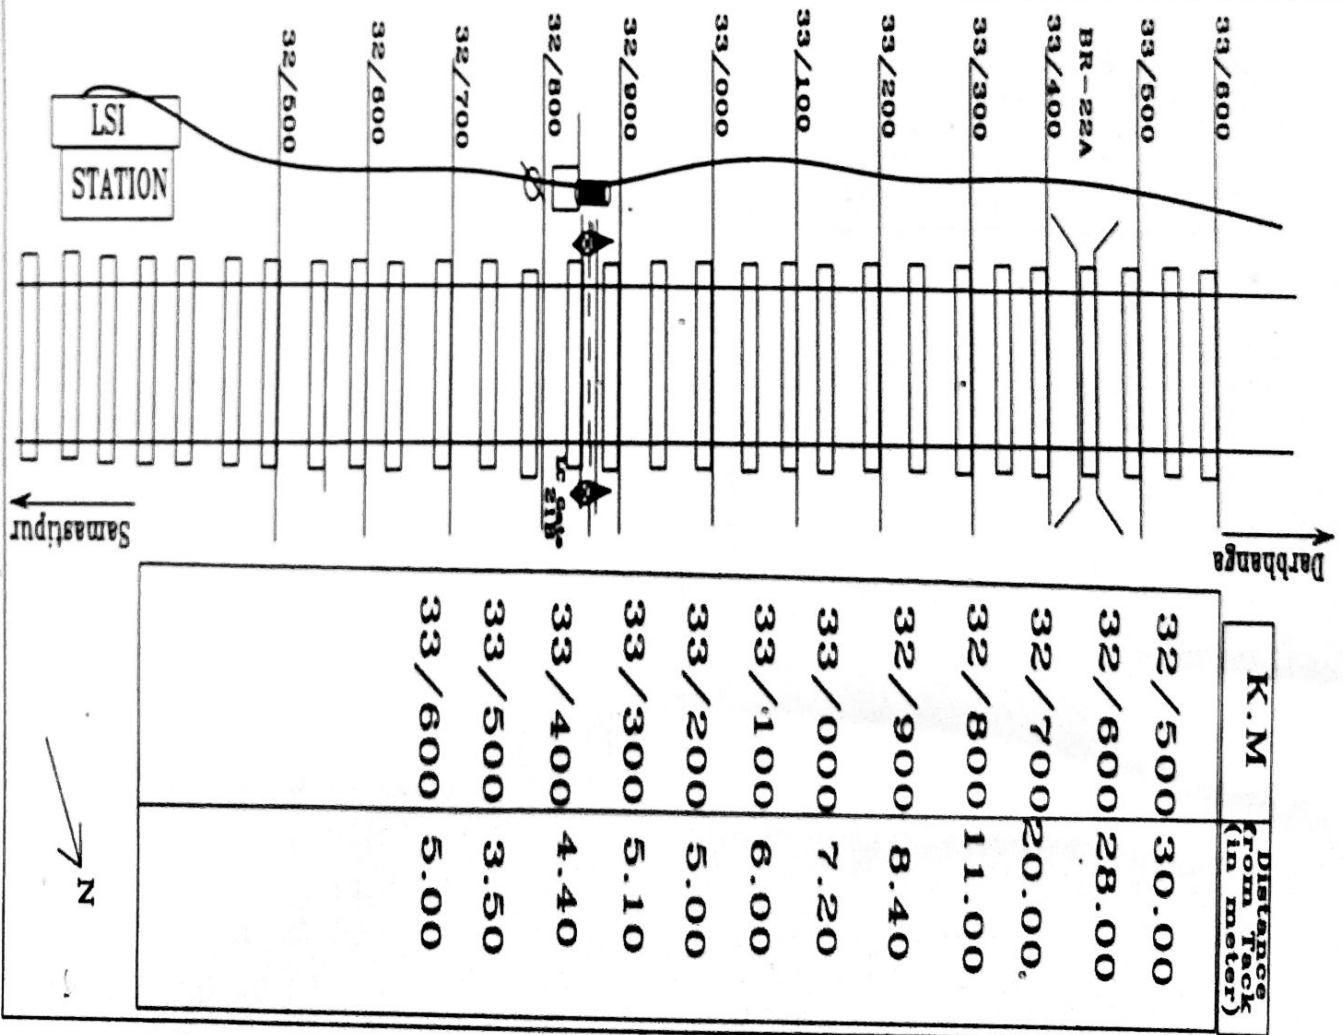

LEGEND

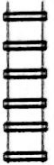Railway Track	--	
Quad cable Route	--	
Station Building	--	<div>STATION</div> 
Derivation joint:-		
Level Crossing	--	
Straight Through joint	--	
G.I.Pipe	--	
Culvert/ROB	--	
ERP	--	

CONTRACTOR SSE/T/C/MPP ASTE/Pro./HJP DY.CSTE/Pro./HJP

M/s.venu Engineering Works

Arbit

Venu Partner

Arbit

SHEET:-29


SCALE
X 1 mm :4.00m
Y 1 mm :1.10m

EAST CENTRAL RAILWAY
SAMASTIPUR
DIVISION

Drawing title as built drawing
Block section ISI-DBG

QUAD CABLE ROUTE PLAN


DRAWN BY:-

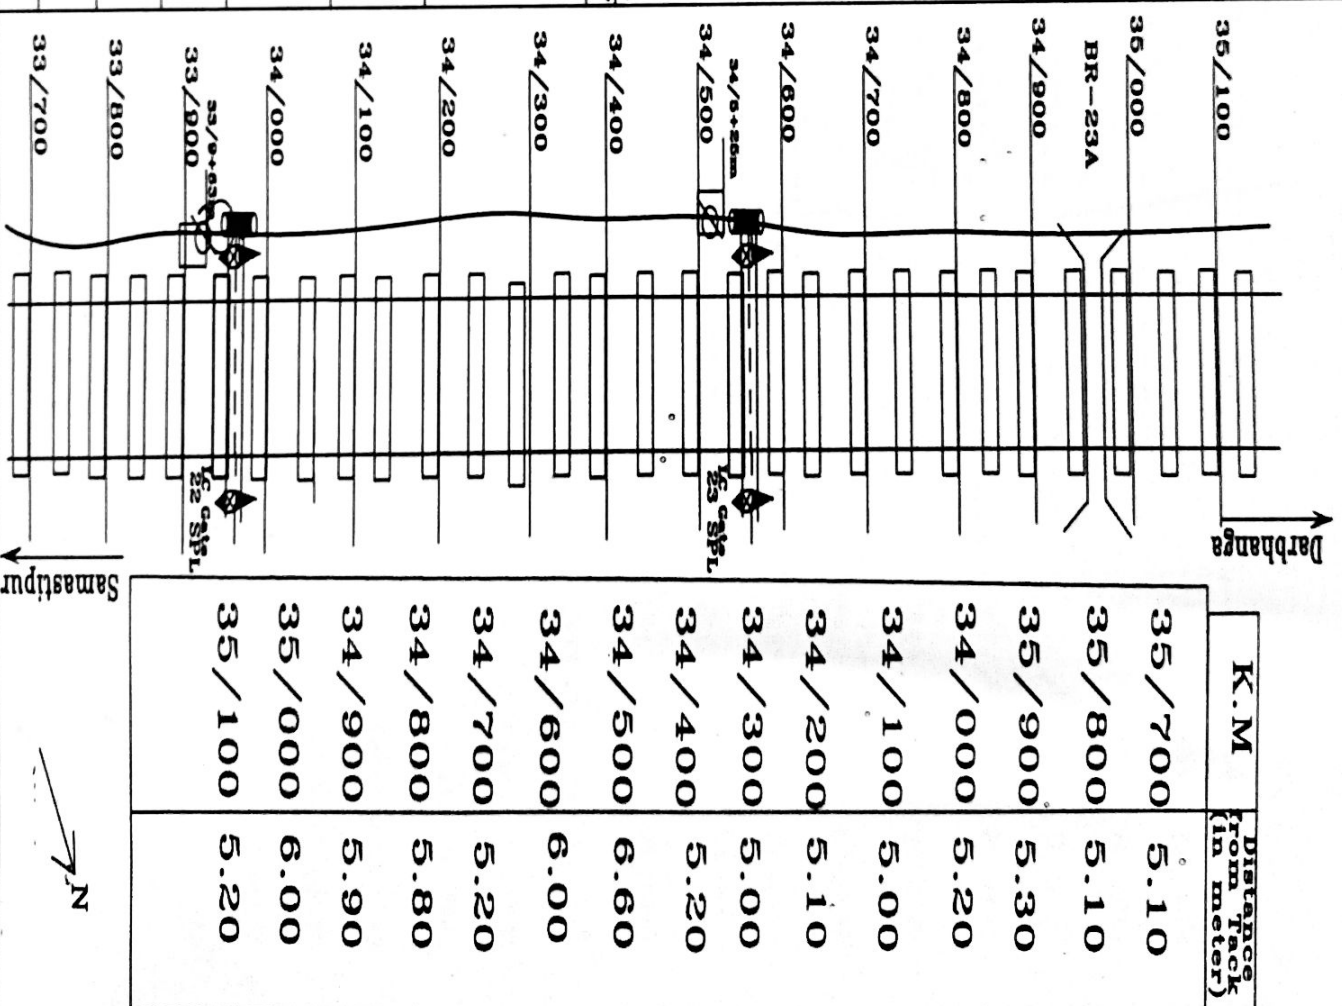

K.M	Distance from Track (in meter)
-----	--------------------------------

35/700	5.10
35/800	5.10
35/900	5.30
34/000	5.20
34/100	5.00
34/200	5.10
34/300	5.00
34/400	5.20
34/500	6.60
34/600	6.00
34/700	5.20
34/800	5.80
34/900	5.90
35/000	6.00
35/100	5.20

Samastipur

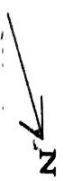

LEGEND

Railway Track	--	
Quad cable Route	--	
Station Building	--	<div>STATION</div> 
Derivation joint:--	--	
Level Crossing	--	
Straight Through joint	--	
G.I. Pipe	--	
Culvert/ROB	--	
ERP	--	

CONTRACTOR	SSE/T/C/MFP	ASTE/PRO./HJP	DY.CSTE/PRO./HJP
------------	-------------	---------------	------------------

M/s. Anu Engineering Works <i>Anu Engineering Works</i>	<i>Anu</i>		
<i>Vandana</i>			


SCALE		SHEET:- 30
X 1 mm = 4.00m		
Y 1 mm = 1.10m		

EAST CENTRAL RAILWAY
SAMASTIPUR
DIVISION

Drawing title as built drawing
Block section ISI-DBG


QUAD CABLE ROUTE PLAN

DRAWN BY:-

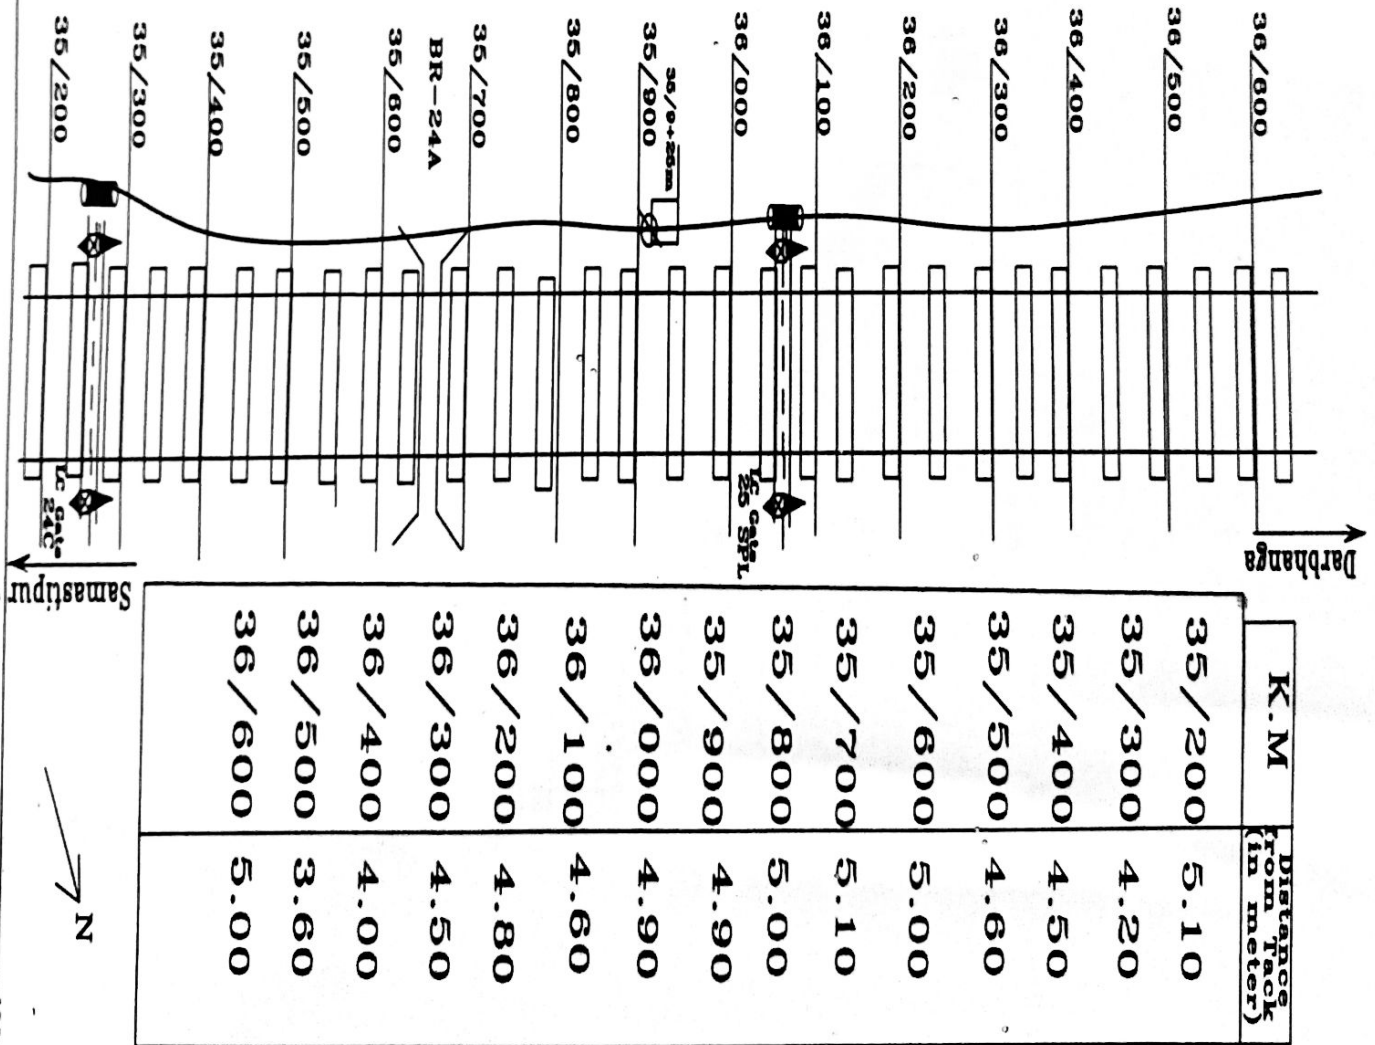

LEGEND

Rialway Track	--		
qua d cable Route	--		
Station Building	--	<div>STATION</div>	
Derivation joint:--	--		
Level Crossing	--		
Straight Throug h joint	--		
G.I.Pipe	--		
Culvert/ROB	--		
ERP	--		
CONTRACTOR	SSE/T/C/MFP	ASTE/Pro./HJP	DY.CSTE/Pro./HJP
Jeta Engineering Works			
Partner			
SCALE	SHEET:-- 31		
X 1 mm :4.00m			
Y 1 mm :1.10m			
EAST CENTRAL RAILWAY			
SAMASTIPUR			
DIVISION			
Drawing title as built drawing			
Block section LSI-DBG			
QUAD CABLE ROUTE PLAN			
DRAWN BY:--			

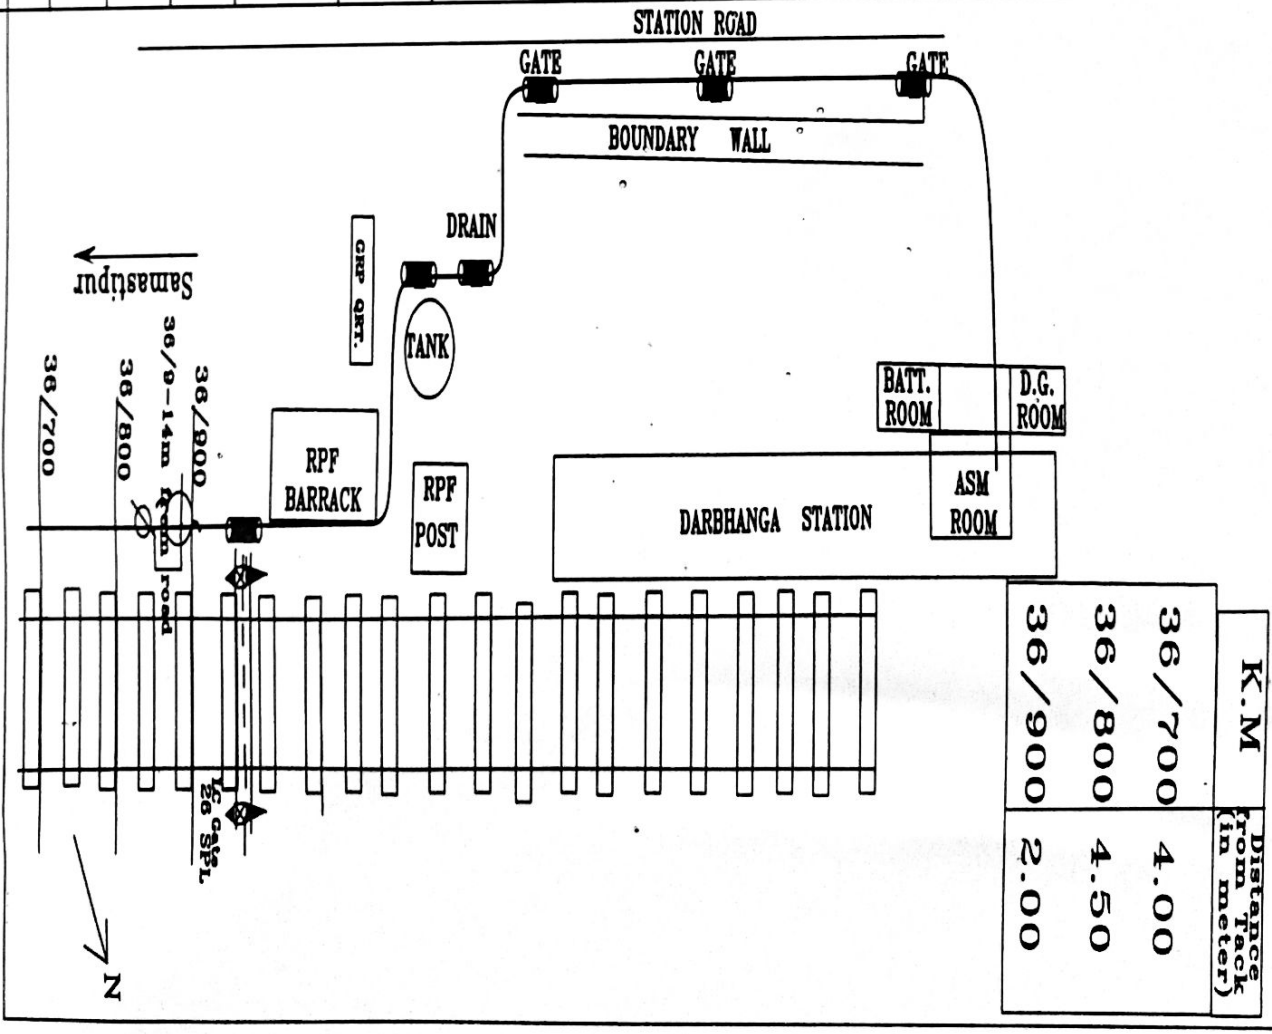

K.M	Distance from track (in meter)
36/700	4.00
36/800	4.50
36/900	2.00