


1. OFC CABLE
2. 4 QUAD CABLE
3. OFC JOINT
4. 4 Q. 2T JOINT
5. 4 Q. ST. JOINT
6. RCC PIPE
7. GI PIPE
8. E S P
9. ROAD
10. CULVART
11. CABIN

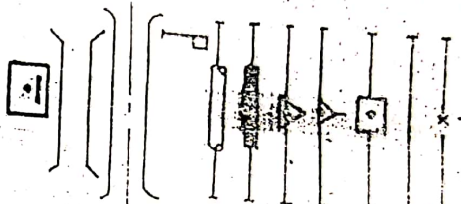

RAILWAY ELECTRIFICATION PROJECT
DANAPUR


AS BUILT DRAWING


NOTE

1. ALL DIMENTION ARE TAKEN FROM CENTER OF THE TRACK.
2. ALL DIMENTION ARE IN MTS.


TELECOM CABLE ROUTE PLAN OF
RAGHUNATHPUR TO BANHI
SECTION

SE / SSE / RE / DNR	ASTE / RE / DNR	DY. CSTE / RE / DNR	DRAWN BY 	CHECKED BY 	SCALE = 1" = 100'	NO OF SHEET 1 OF 6
			SUPREME TELECOMMUNICATIONS LTD DRG NO.- STL / CORE / 301 / 97 / 15 DATE -			

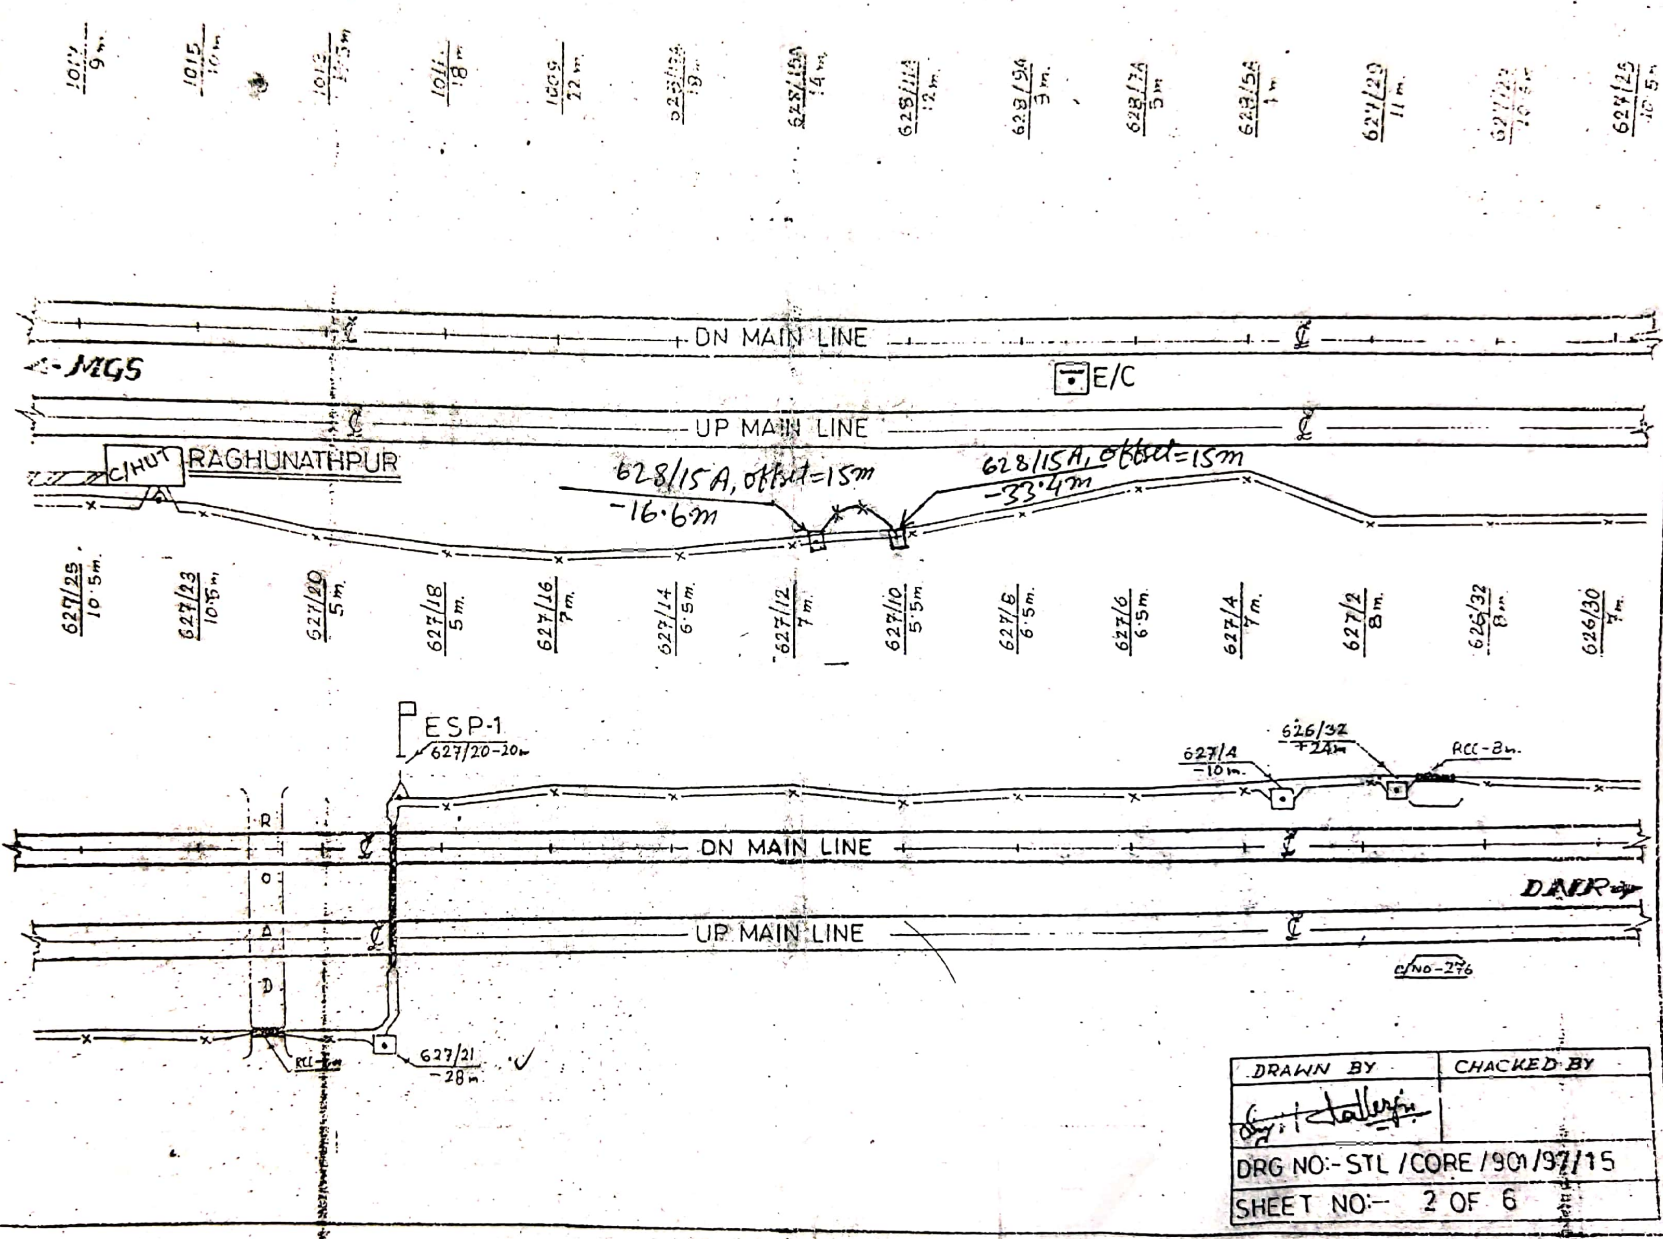


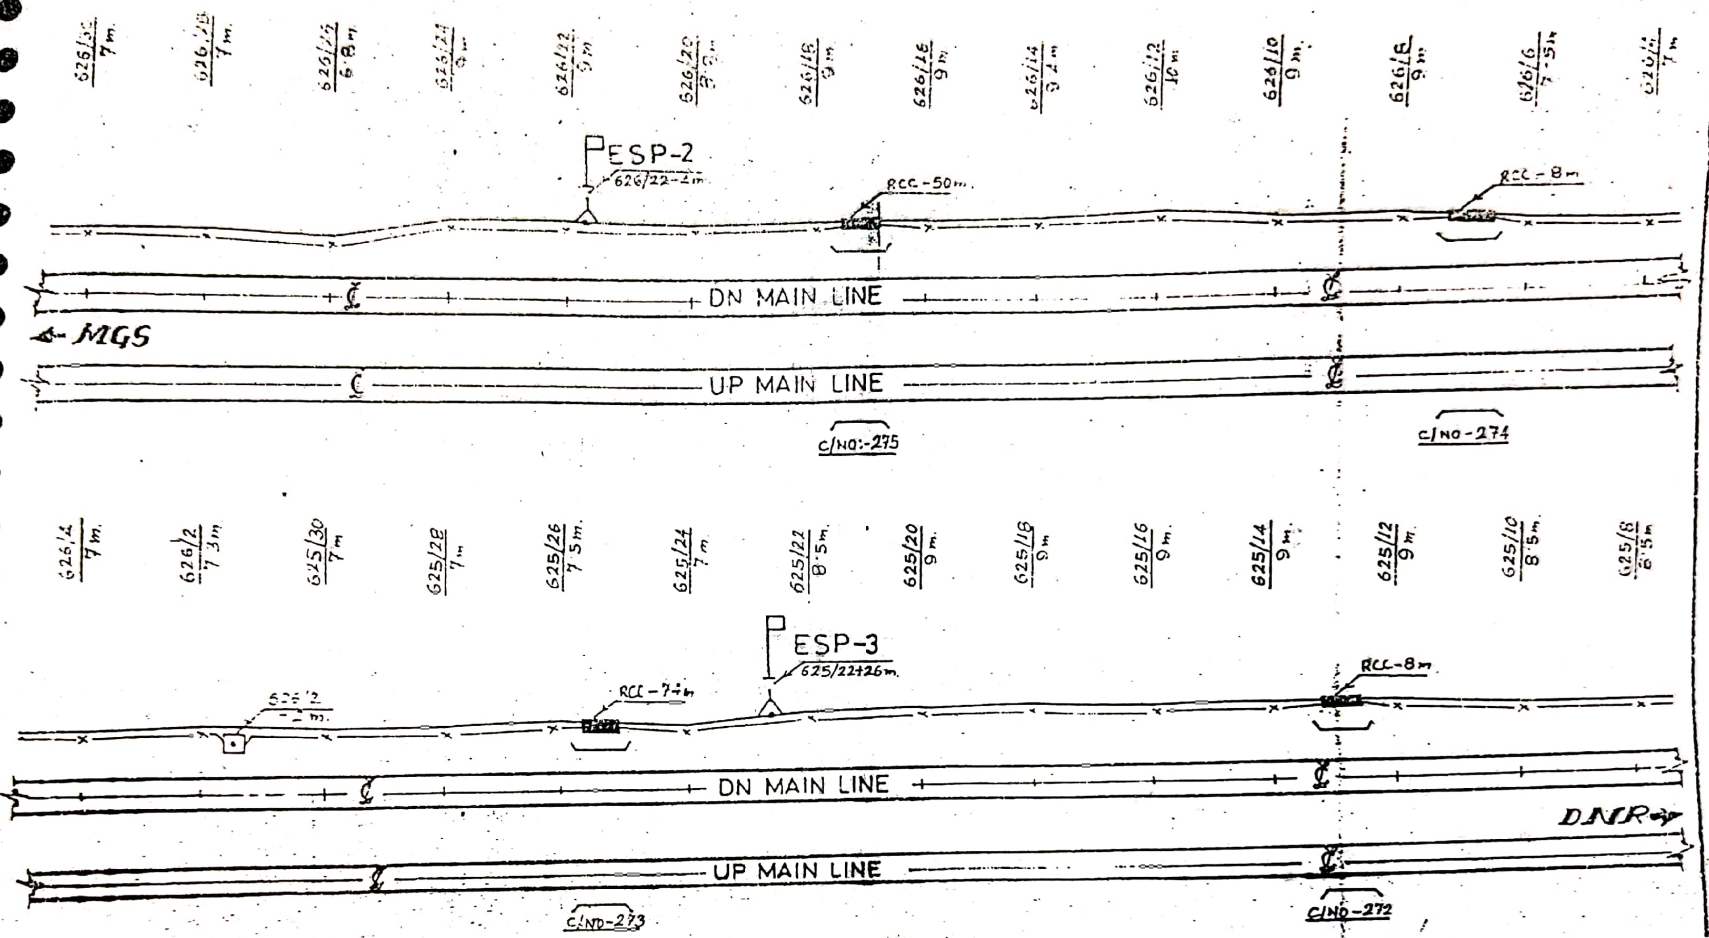

DRAWN BY	CHECKED BY
<i>[Signature]</i>	
DRG NO:- STL / CORE / 901/97/15	
SHEET NO:- 3 OF 6	

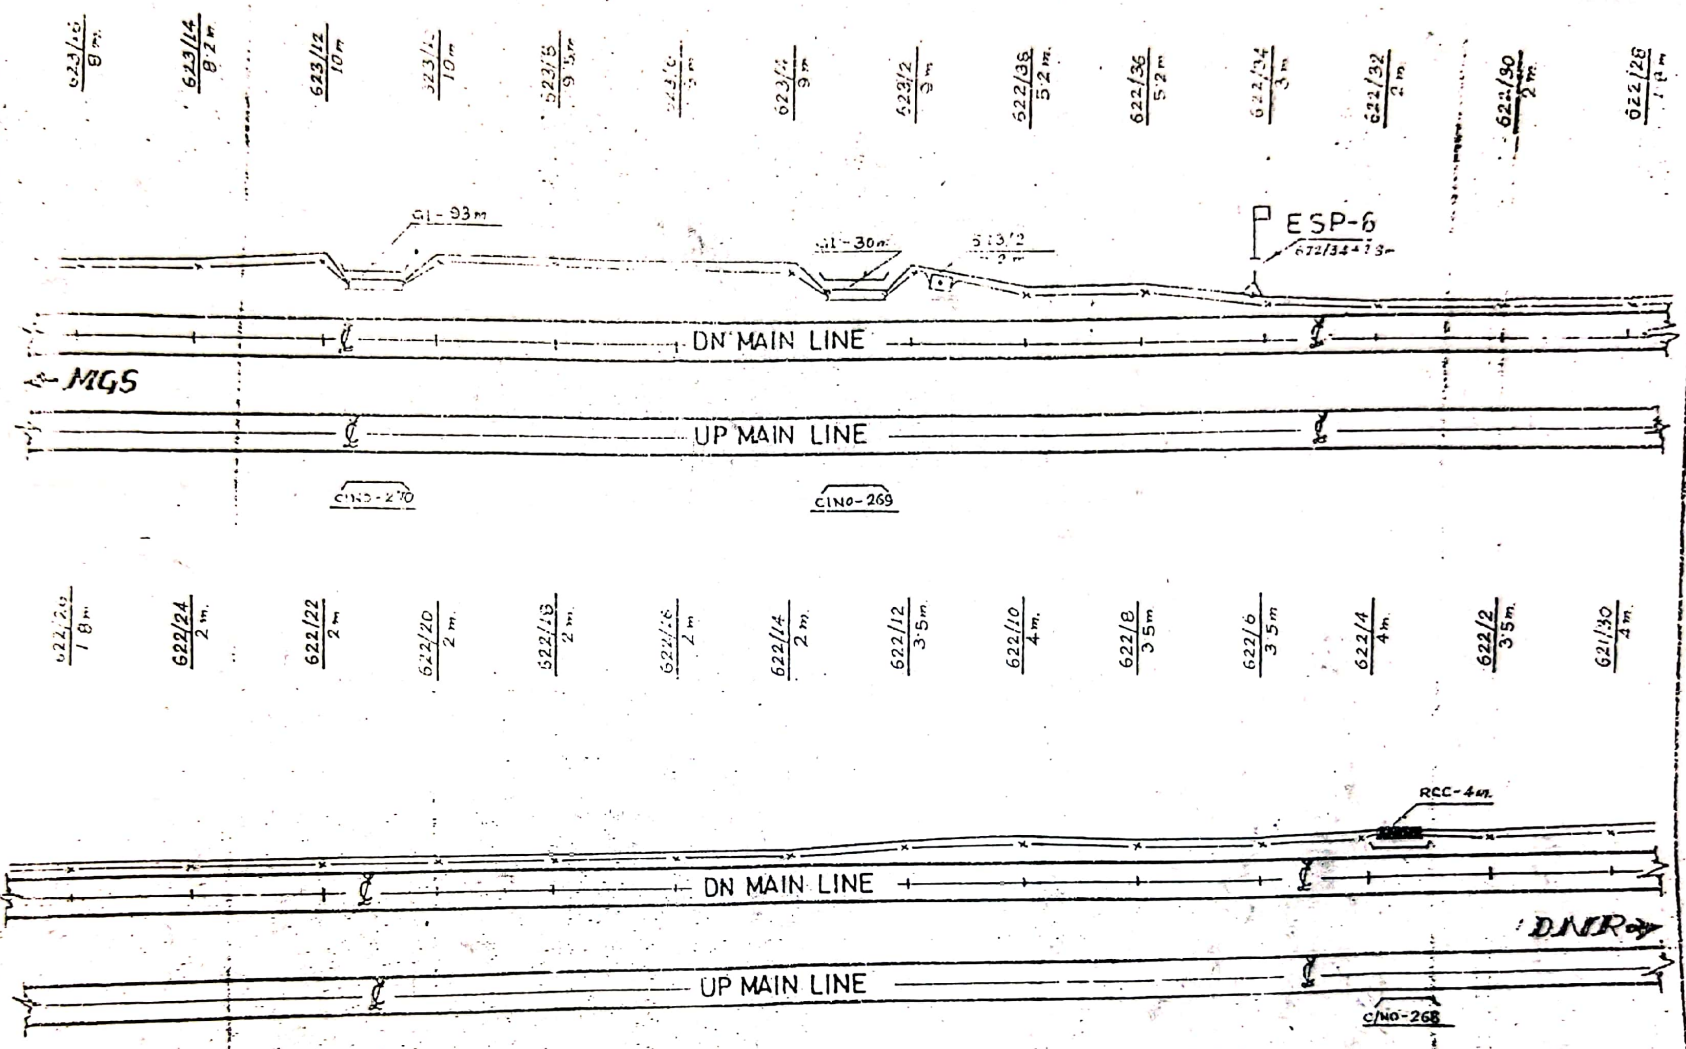

DRAWN BY:	CHECKED BY:
<i>[Signature]</i>	<i>[Signature]</i>
D/G NO-STL / COR-901/97/15	
SHEET NO- 5 OF 6	

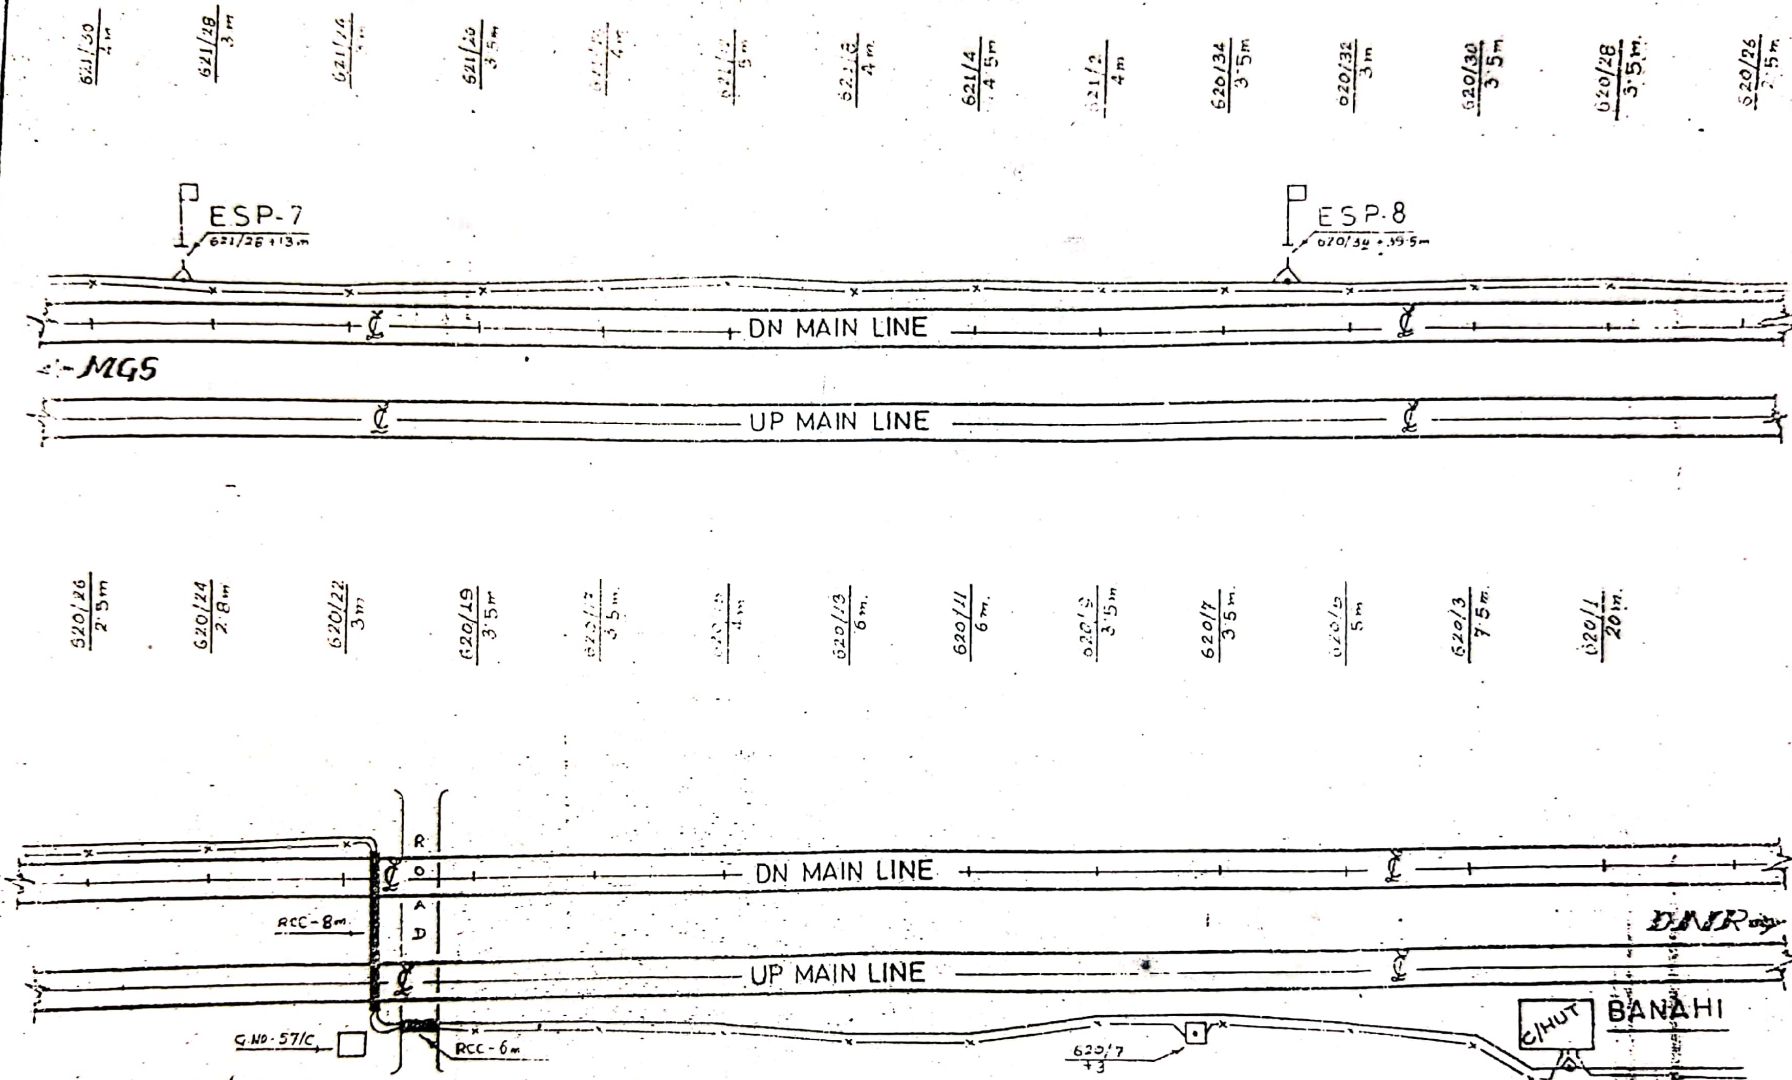

DRAWN BY	CHECKED BY
<i>[Signature]</i>	
DRG NO-STL / CORE / 501/97/15	
SHEET NO-- 6 OF 5	