

LEGEND

1. OFC CABLE	— x —
2. 4 QUAD CABLE	— — — —
3. OFC JOINT	— [] —
4. 4 Q. 2T JOINT	— [] —
5. 4 Q. ST. JOINT	— [] —
6. RCC PIPE	— [] —
7. GI PIPE	— [] —
8. E S P	— [] —
9. ROAD	— [] —
10. CULVART	— [] —
11. CABIN	— [] —

RAILWAY ELECTRIFICATION PROJECT DANAPUR

AS BUILT DRAWING

NOTE

1. ALL DIMENTION ARE TAKEN FROM CENTER OF THE TRACK.
2. ALL DIMENTION ARE IN MTS.

152


TELECOM CABLE ROUTE PLAN OF KARISATH TO ARA SECTION

DRAWN BY	CHACKED BY	SCALE	NO OF SHEET
<i>[Signature]</i>		≠ Not To Scale	1 OF 7

SUPREME
TELECOMMUNICATIONS LTD

DRG NO:-
STL / CORE / 301/57 / 18
DATE :-

SE / SSE / RE / DNR	ASTE / RE / DNR	DY. CSTE / RE / DNR

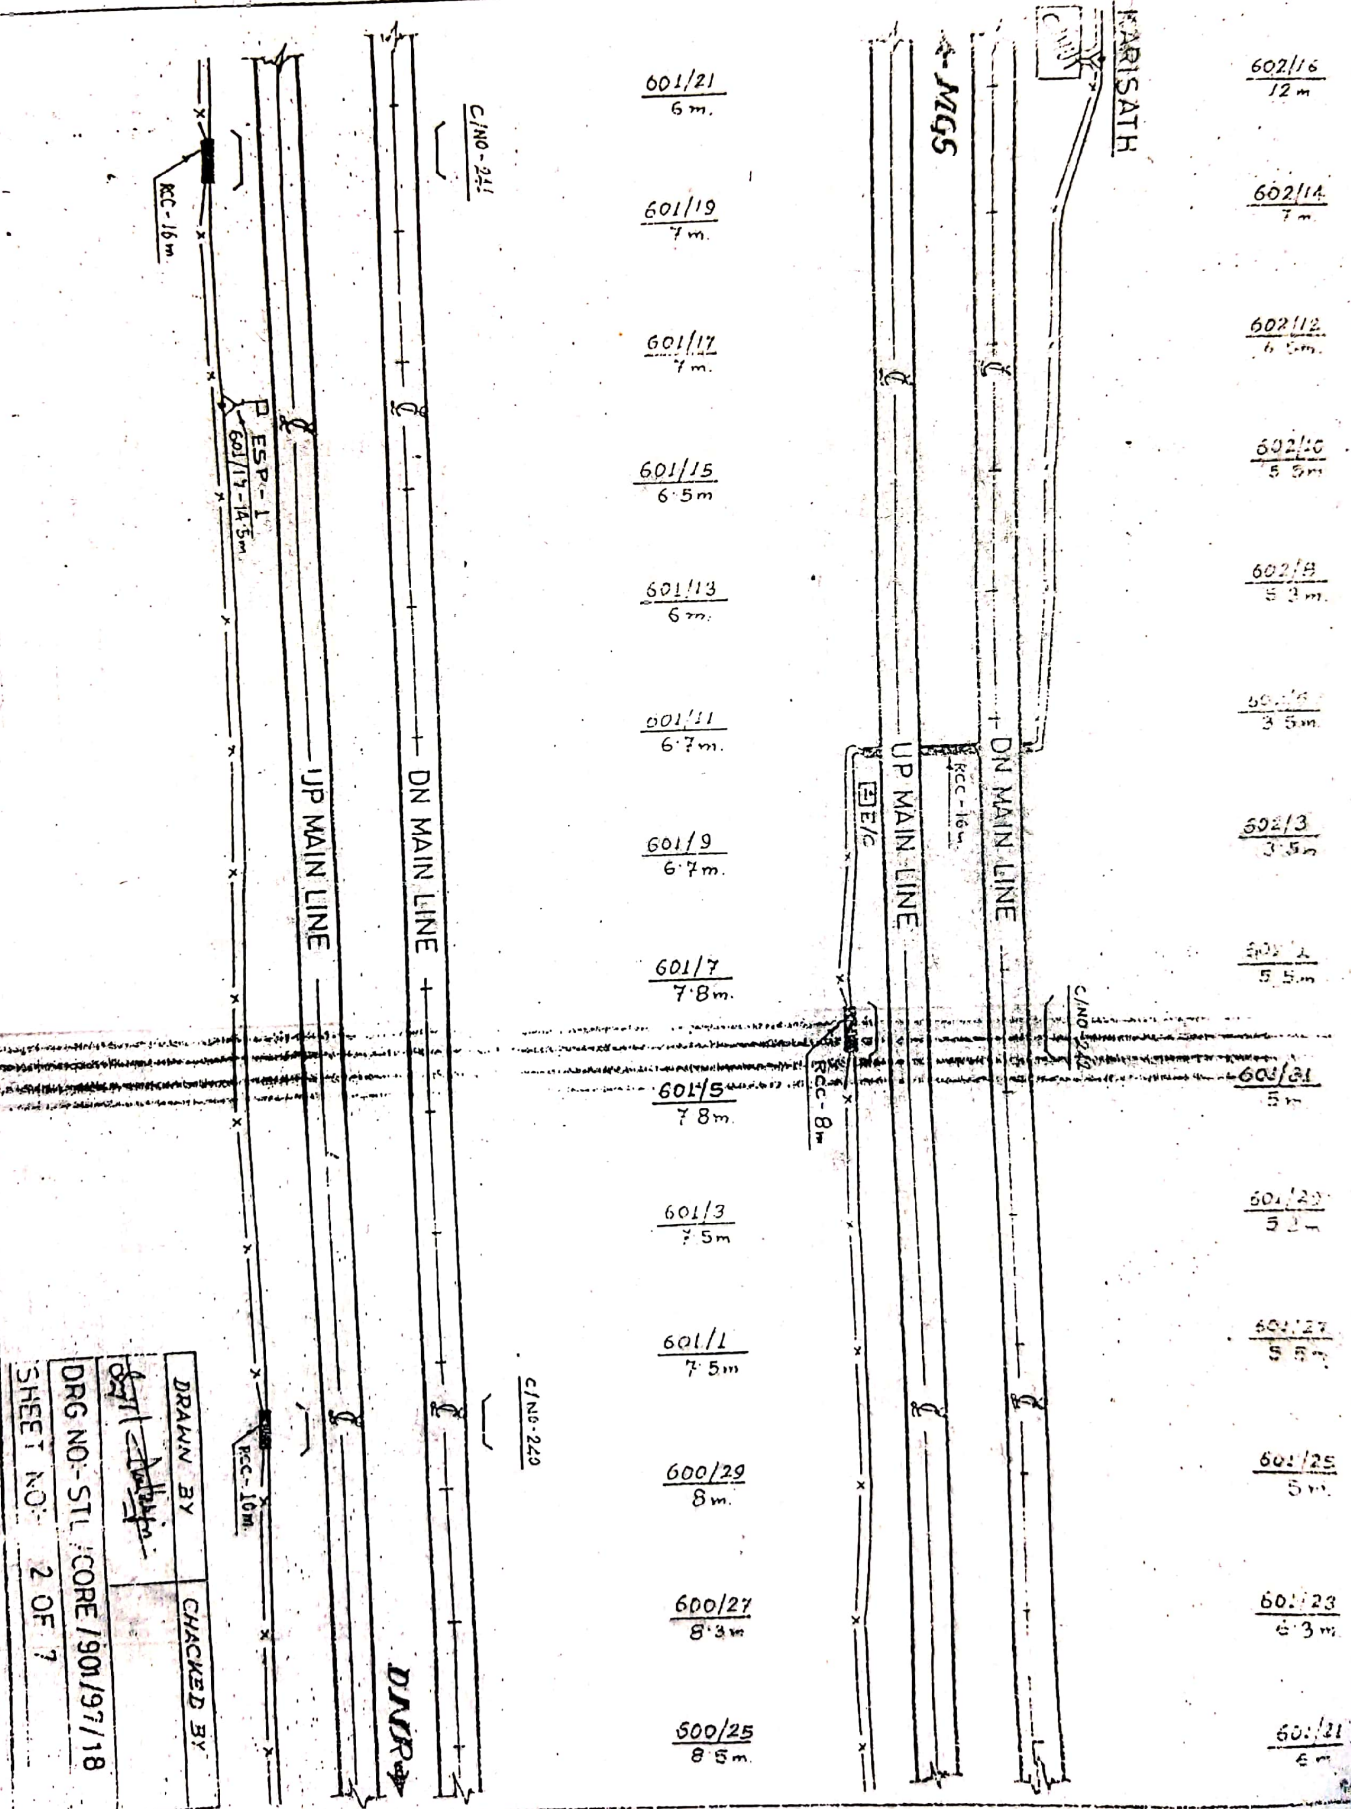

600/25
8.3m.

600/23
8.2m.

600/21
8m.

600/19
8m.

600/17
8.2m.

600/15
8.5m.

600/13
8.5m.

600/11
9m.

600/9
9m.

600/7
9.5m.

600/5
9.5m.

600/3
9.1m.

600/1
9m.

599/31
9m.

← MG5

ESP-2

UP MAIN LINE

DN MAIN LINE

C/NO-239

600/5
-26.5m

599/31
9m.

599/29
8.7m.

599/27
8m.

599/25
9.5m.

599/23
9m.

599/21
9m.

599/19
8m.

599/17
8m.

599/15
8m.

599/13
4.5m.

599/11
3m.

599/9
1.5m.

599/7
5m.

599/5
6m.

C/NO-238

C/NO-237

C/NO-236

DNR

UP MAIN LINE

DN MAIN LINE

ESP-3

RCC-40m.

RCC-50m.

QI-88m.


DRAWN BY

CHECKED BY


DRG NO: STL / CORE / 901 / 97 / 18

SHEET NO: 3 OF 7



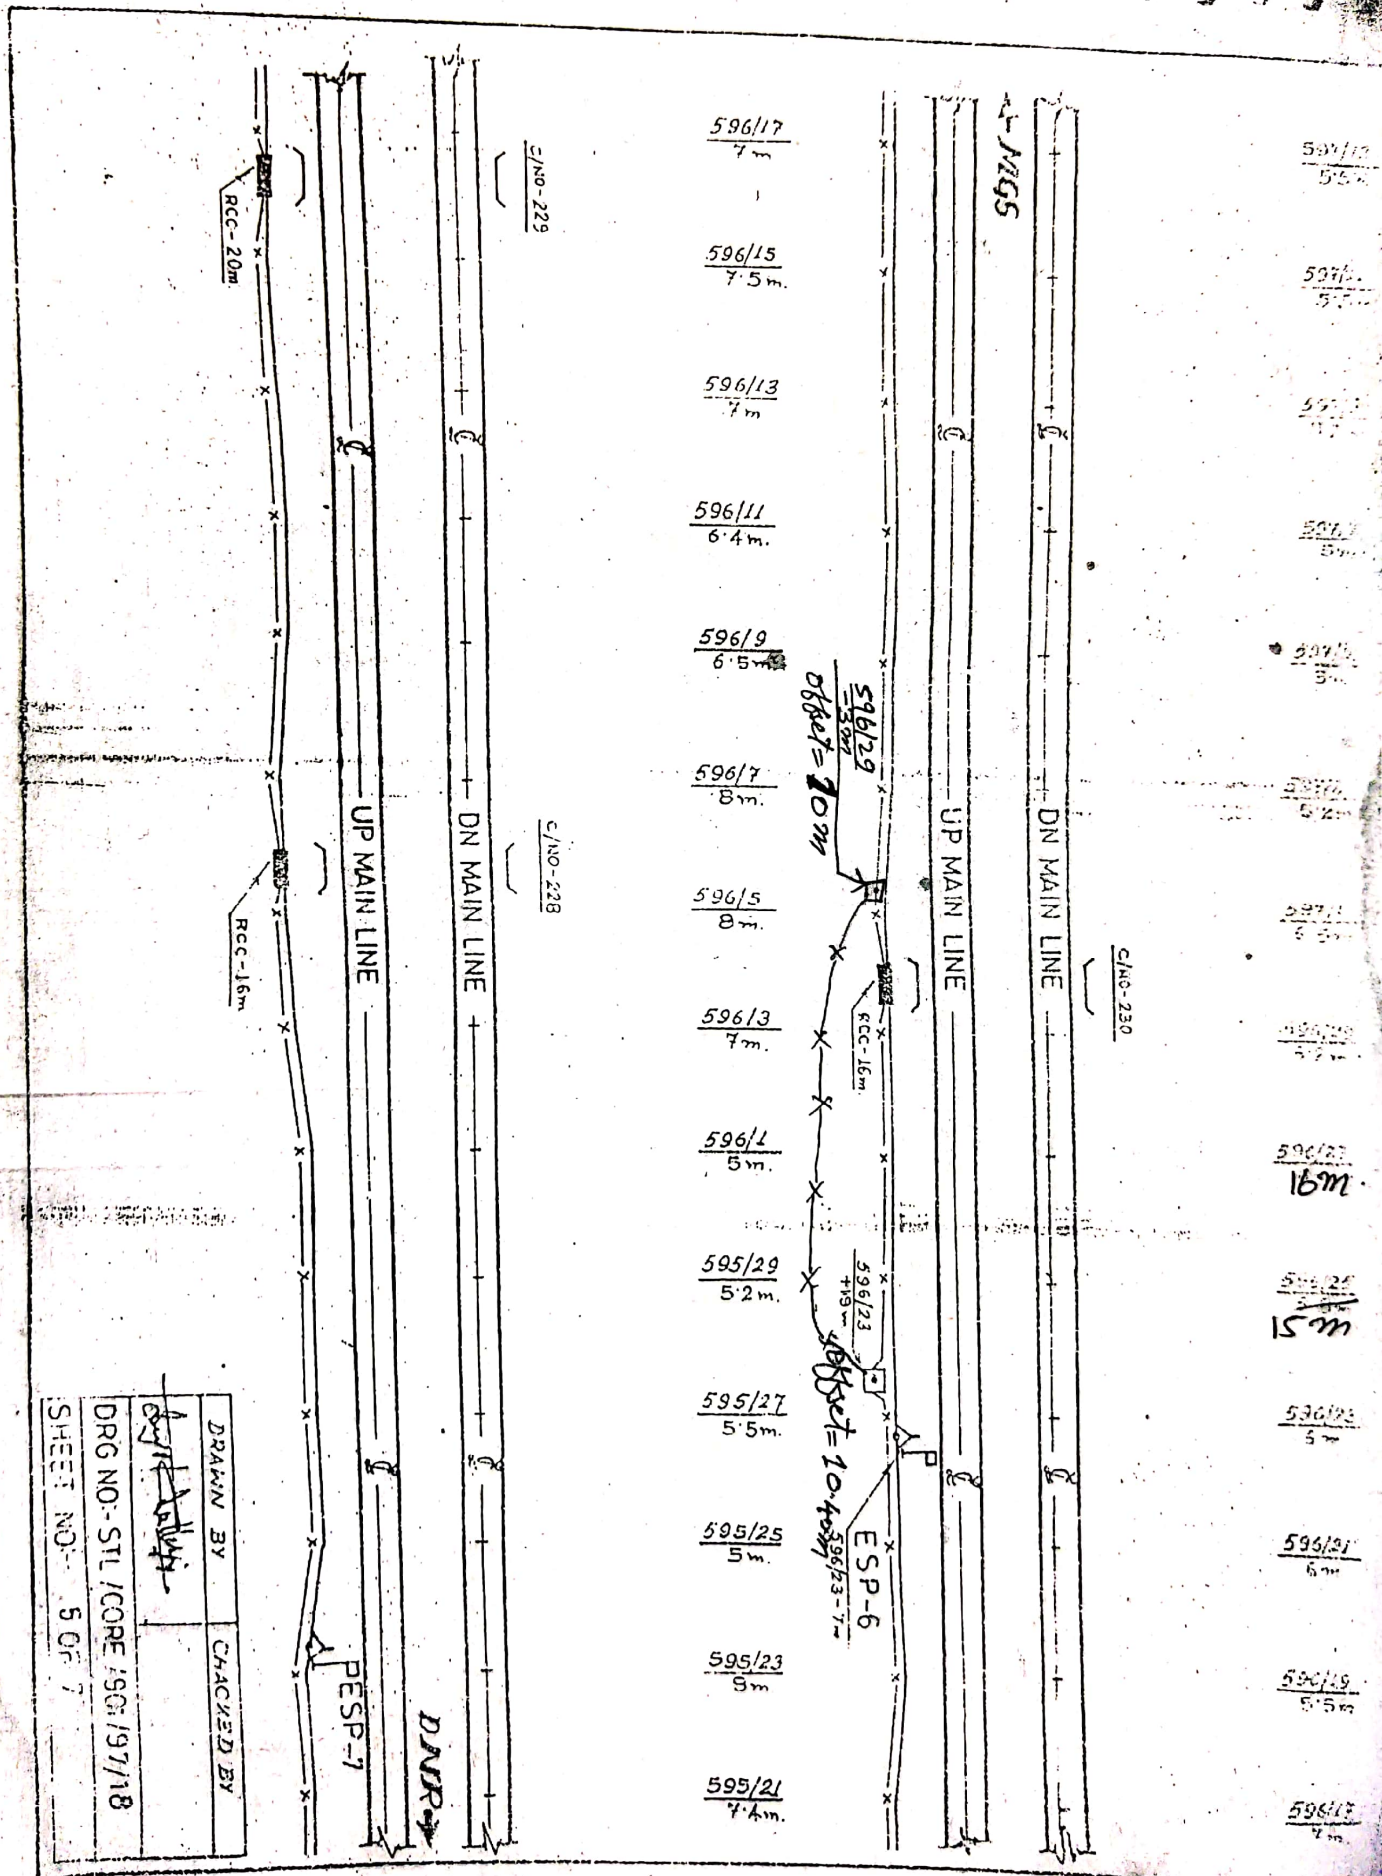

DRAWN BY	CHECKED BY
<i>[Signature]</i>	
DRG NO: STL / CORE / 301 / 97 / 18	
CUTTING NO: 6 OF 7	

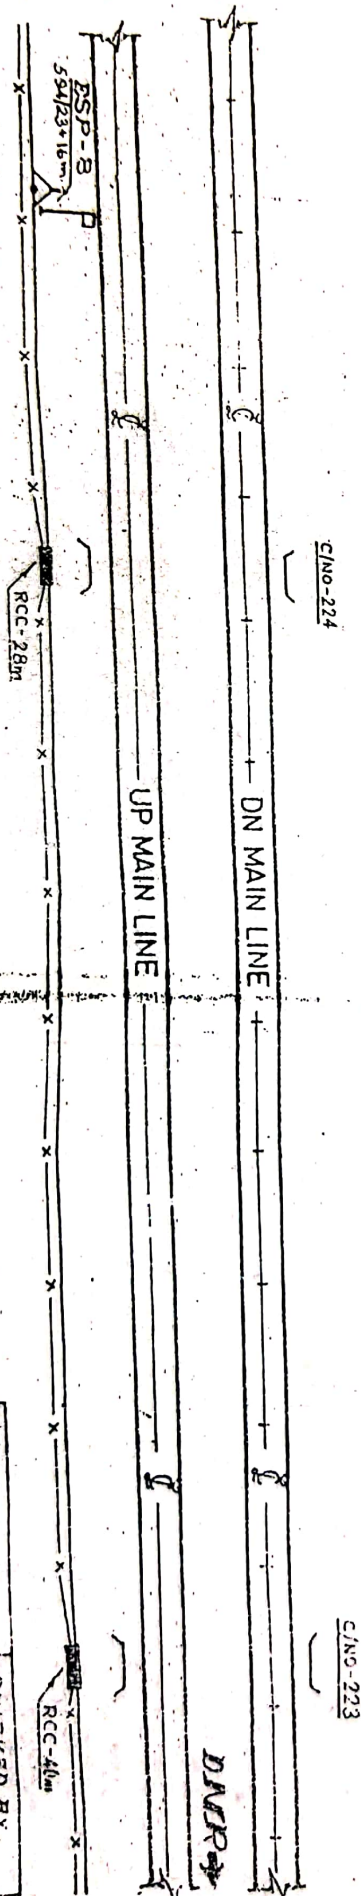

594/25
8.5m

594/23
8.7m

594/21
9m

594/19
8.3m

594/17
8.3m

594/15
8.3m

594/13
8.2m

594/11
8.5m

594/9
9.2m


594/7
9m

594/5
9.1m

594/3
9m

594/1
8.6m

593/37
8.5m

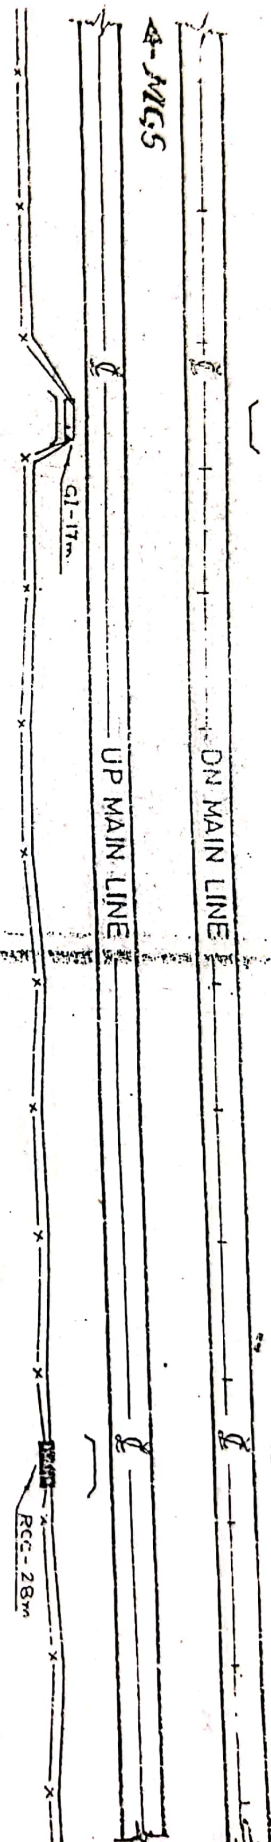

595/21
7.4m

595/19
7.2m

595/17
7.5m

595/15
7.5m

595/13
7.5m

595/11
7.2m

595/9
8.3m

595/7
7.6m

595/5
8.1m

595/3
8m

595/1
8.8m

594/29
8.5m

594/27
7.8m

594/25
8.5m



593/37
8.5m.

593/35
8m

593/33
7m.

593/31
7.6m.

593/29
8m.

593/27
8m.

593/25
7.3m.

593/23
7m.

593/21
5.5m.

593/19
4m.

593/17
3m.

593/15
2.2m.

593/13
2m.

593/9
4m.

← MGS

ESP-9 P
593/31-20m
593/33
+10m.

UP MAIN LINE

DN MAIN LINE

RCC-10m.

G.NO-49/B

593/7
3m.

593/6
1.5m.

593/4
1.5m.

593/2
1.5m.

592/40
1m.

592/38
1.5m.

592/36
5m.

592/36
+2.2m.

STN
BLDG.

ARA
C/HUT

RCC-12m.

UP MAIN LINE

DN MAIN LINE

DWR

DRAWN BY

CHECKED BY

DRG NO-STL / CORE / 901/97/18

SHEET NO:- 7 OF 7

