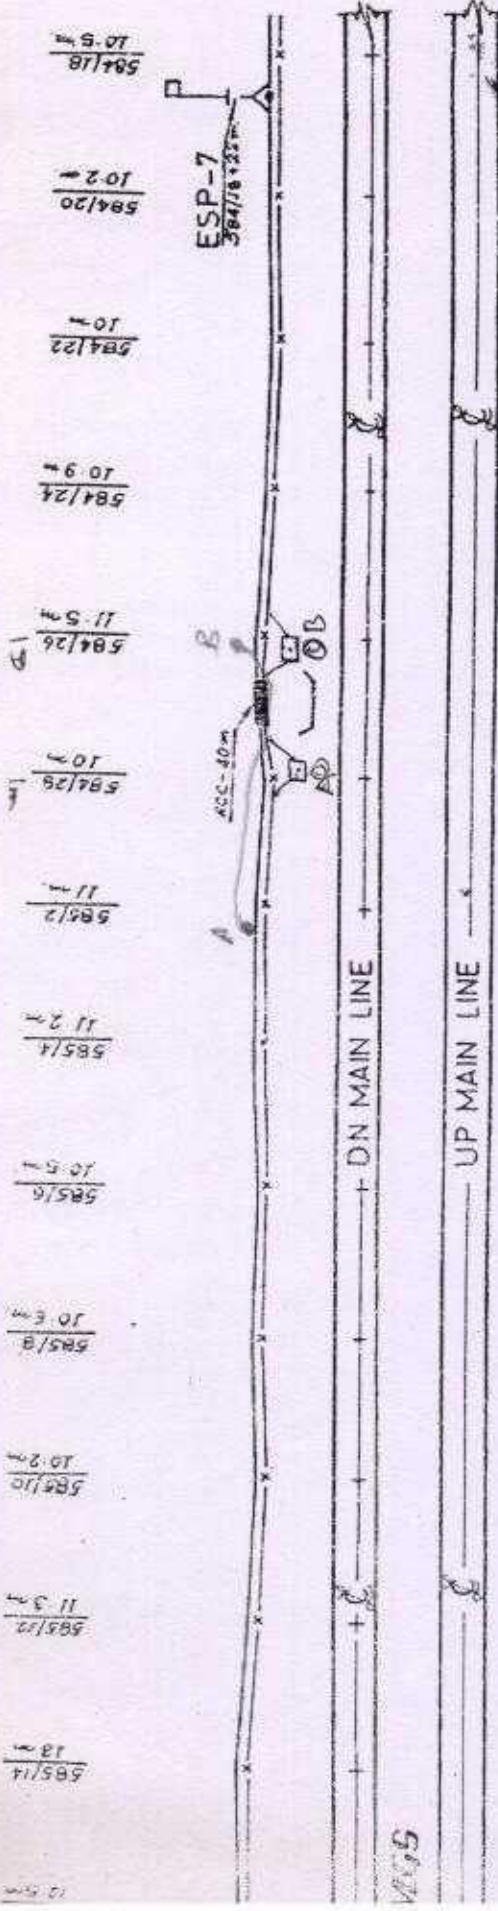
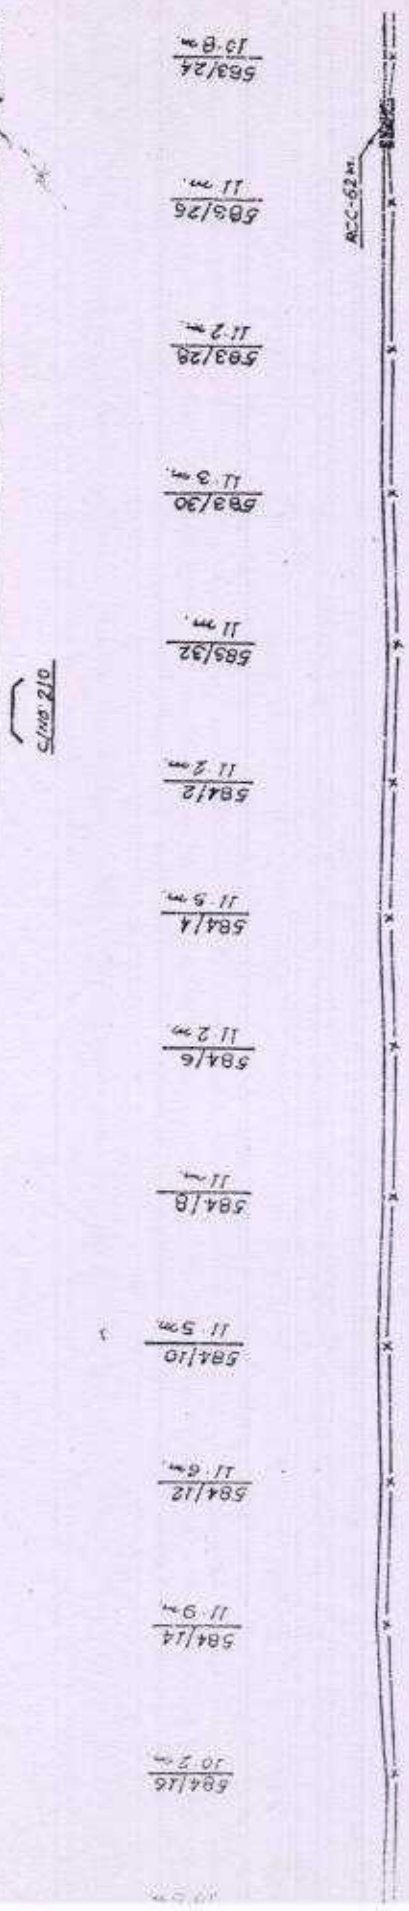



DRAWN BY <i>Shalini</i>	CHECKED BY <i>A. V. S. S. S.</i>
DRG NO:- STL / CORE / 901/97/19	
SHEET NO:- 6 OF 7	

① 08/05/2012 ② 27/05/13
A - 584/26 + 27.5 X 2.5
B - 584/28 + 27.5 X 2.5

③ (585/27.4) 13
④ (584/26 + 27.1) 3

RAILWAY ELECTRIFICATION PROJECT DANAPUR

AS BUILT DRAWING

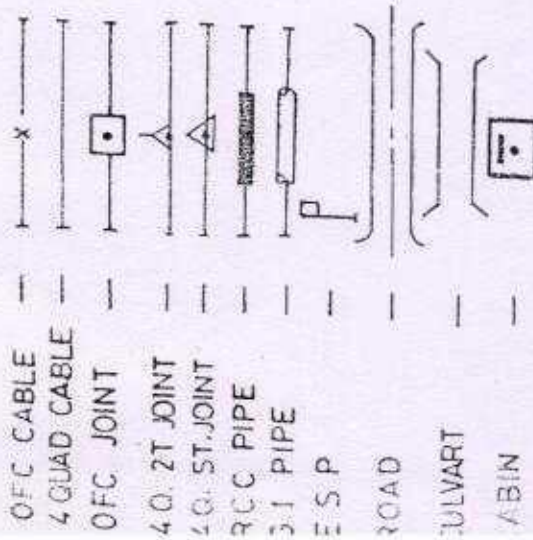

ALL DIMENTION ARE TAKEN FROM CENTER OF THE TRACK.


ALL DIMENTION ARE IN MTS.

TELECOM CABLE ROUTE PLAN OF KULHARIA TO B/HUT/C SECTION

DRAWN BY	CHACKED BY	SCALE	NO OF SHEET
<i>[Signature]</i>	<i>[Signature]</i>	Not To Scale	1 OF 5

SUPREME TELECOMMUNICATIONS LTD	DRG NO:-
	STL / CORE / 901/97/20
	DATE :-

/RE/DNR	ASTE /RE/DNR	DY. CSTE/RE/DNR

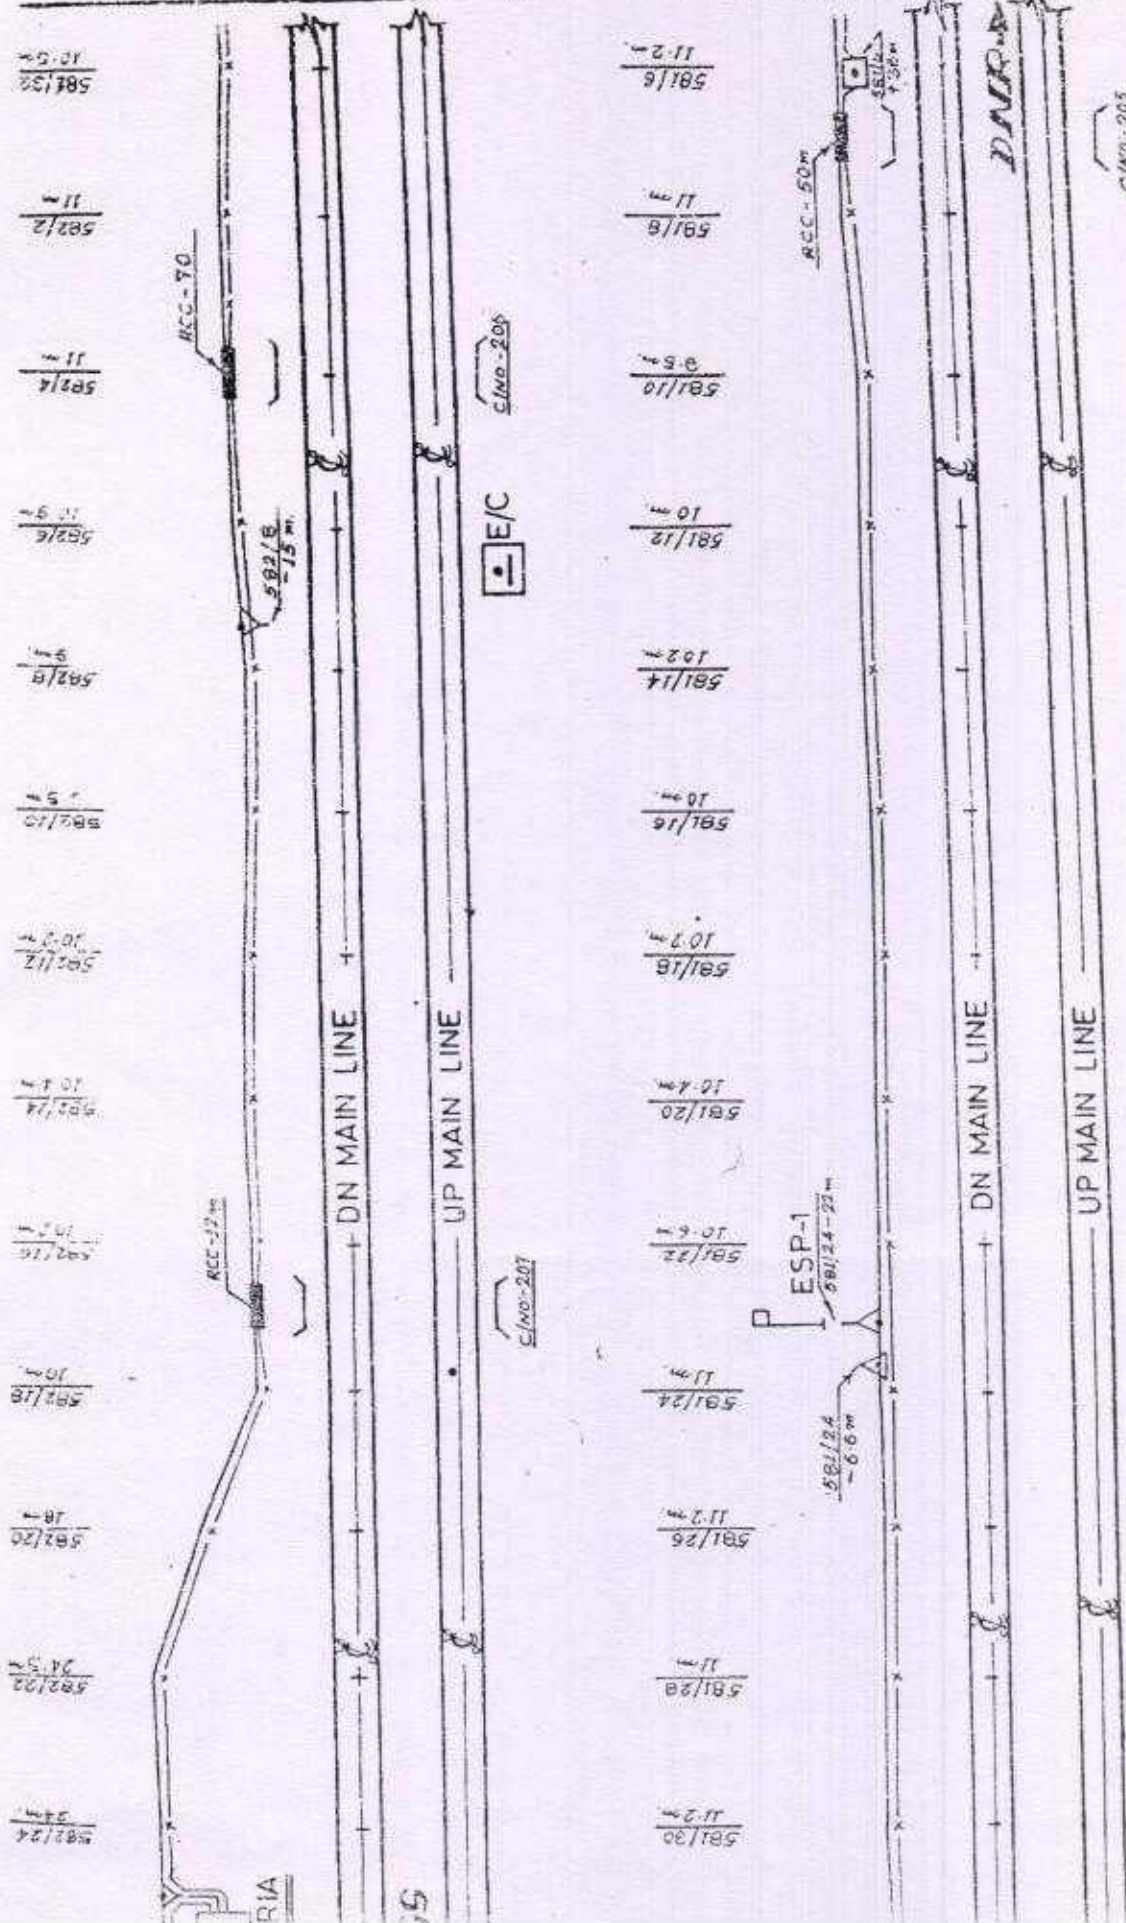

DRAWN BY	CHECKED BY
<i>(Signature)</i>	<i>(Signature)</i>
DRG NO:-STL / CORE / 901/97/ 20	
SHEET NO:- 2 OF 5	


DRAWN BY	CHECKED BY
<i>Chatterjee</i>	<i>A. K. Das</i>
DRG NO-STL / CORE / 901/97/20	
SHEET NO:- 3 OF 5	

DNR

C/NO-202

C/NO-203

A - 579/36 = 24.6X 24.5D
B - 579/36 = 31-20X 24.6D

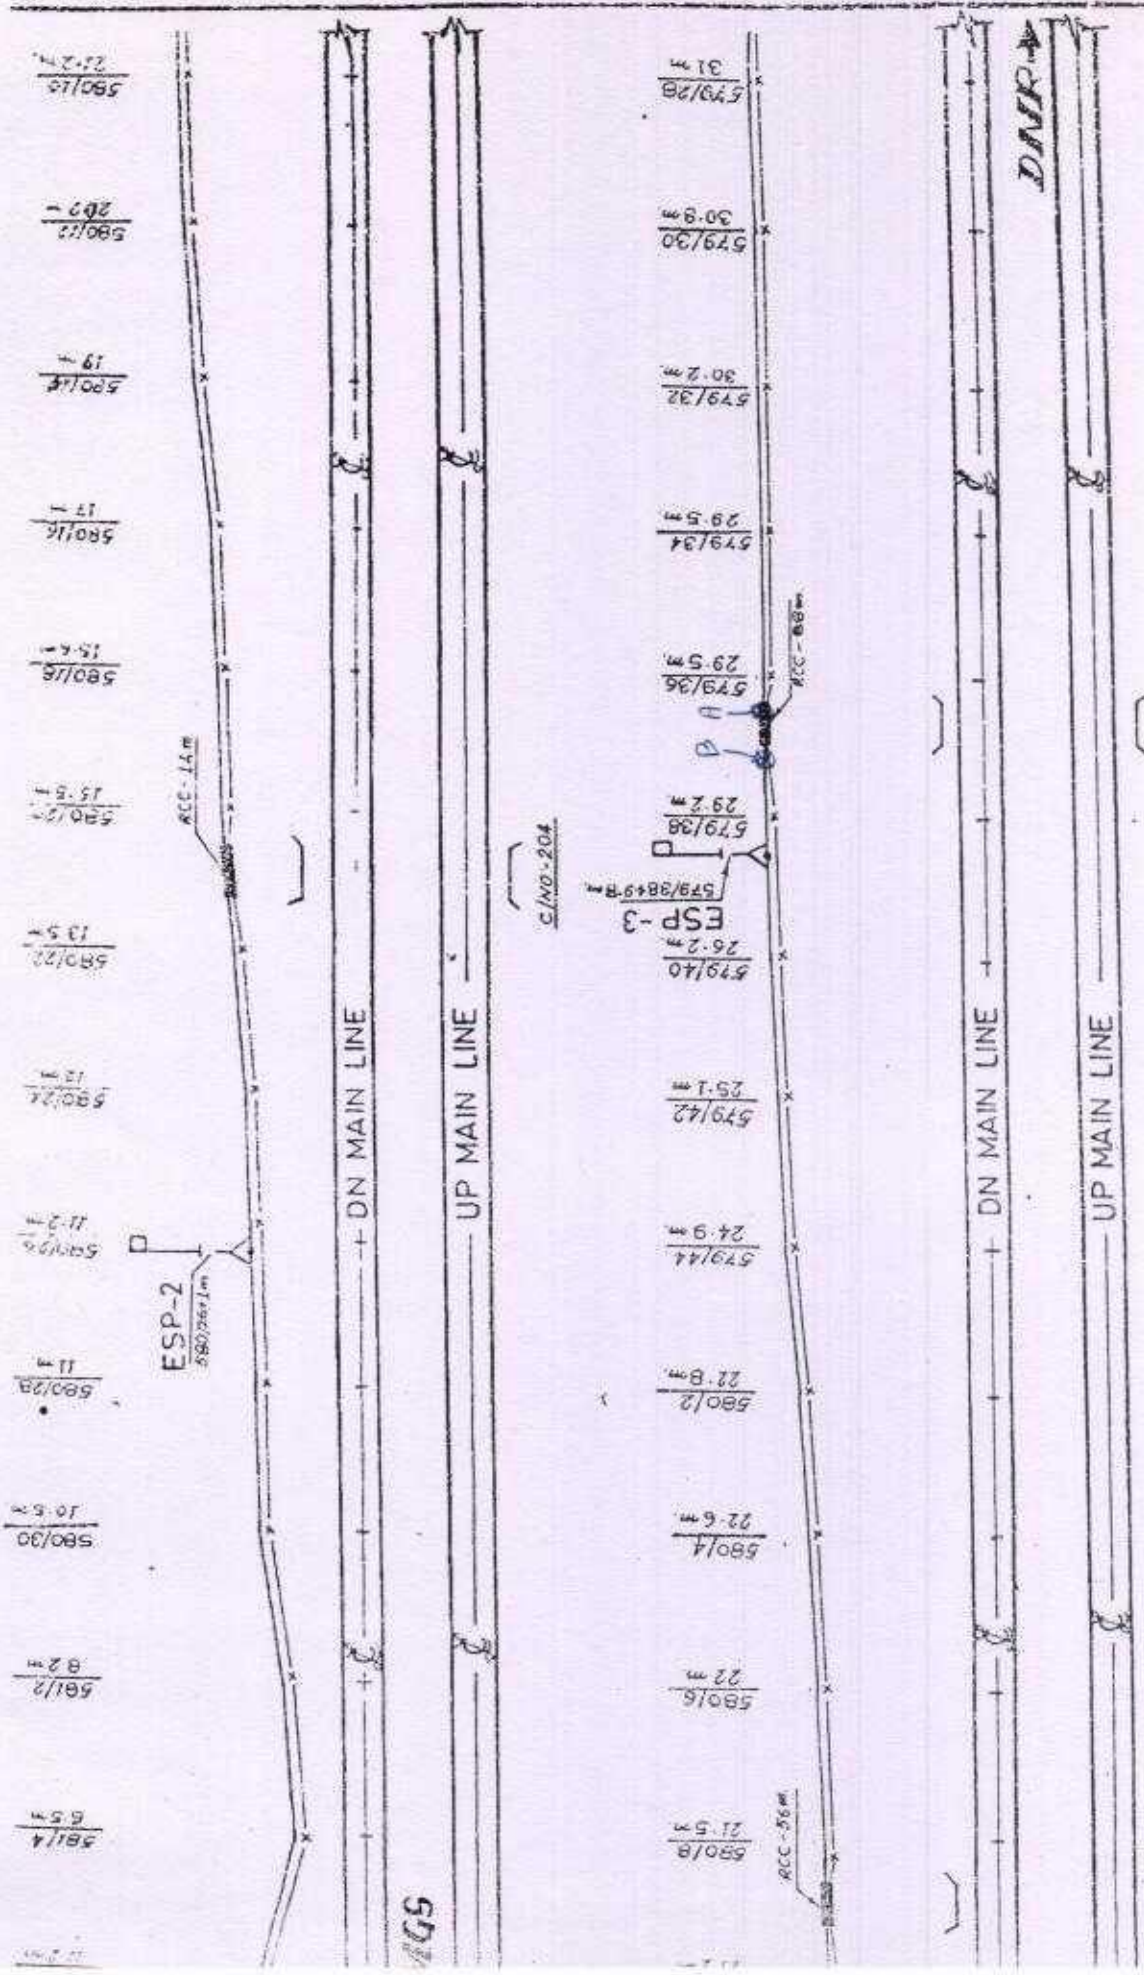

576/8
14.5m

576/10
3m

576/12
15.3m

576/14
15m


576/16
16.2m

576/18
14.2m

576/20
12.5m

576/22
4m

576/24
2.5m

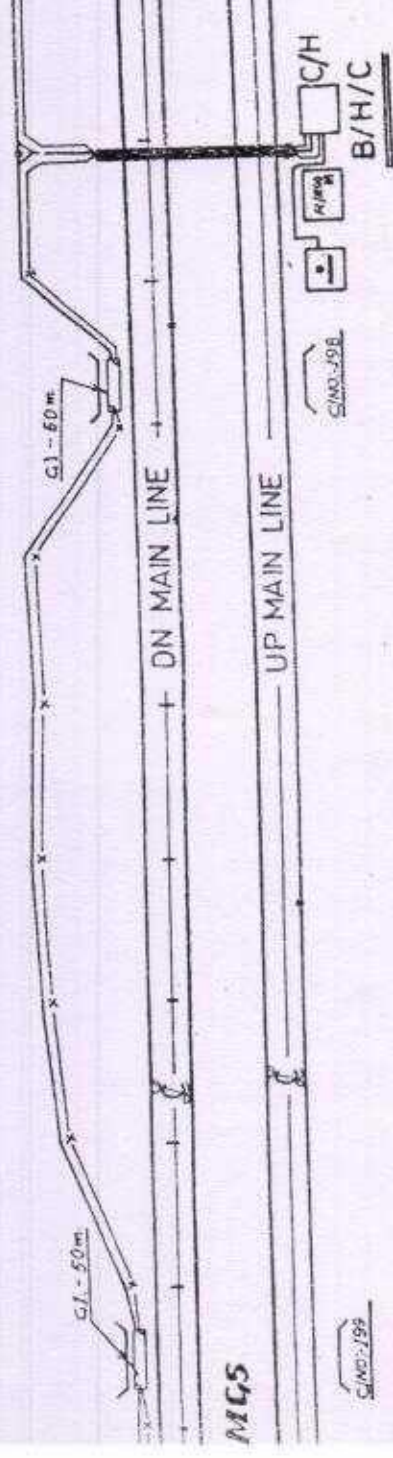


DNR

MGS

DRAWN BY	CHECKED BY
<i>Shalby</i>	<i>Ne. ash</i>
DRG NO:-STL / CORE / 901/97/20	
SHEET NO:- 5 OF 5	

RAILWAY ELECTRIFICATION PROJECT DANAPUR

AS BUILT DRAWING

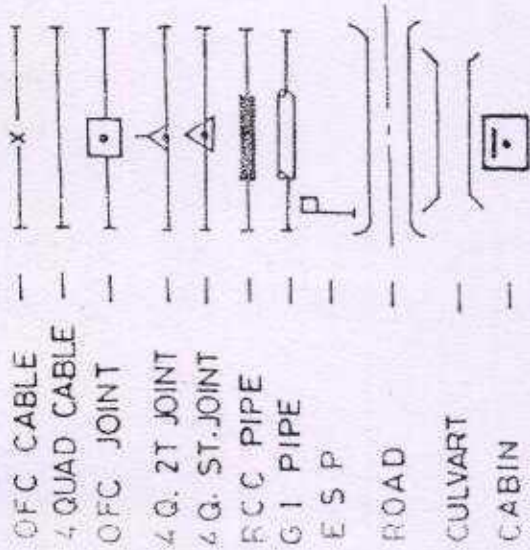

NOTE

ALL DIMENTION ARE TAKEN FROM
CENTER OF THE TRACK.

ALL DIMENTION ARE IN MTS.

TELECOM CABLE ROUTE PLAN OF


B/HUT/C TO BIHTA

SECTION

DRAWN BY	CHACKED BY	SCALE	NO OF SHEET
<i>S. J. Datta</i>	<i>N. C. Ash</i>	$\neq$ Not To Scale	1 OF 5


	SUPREME TELECOMMUNICATIONS LTD	DRG NO:--
		STL / CORE / 901/97/21
		DATE :--

'SSE/RE/DNR	ASTE/RE/DNR	DY.CSTE/RE/DNR

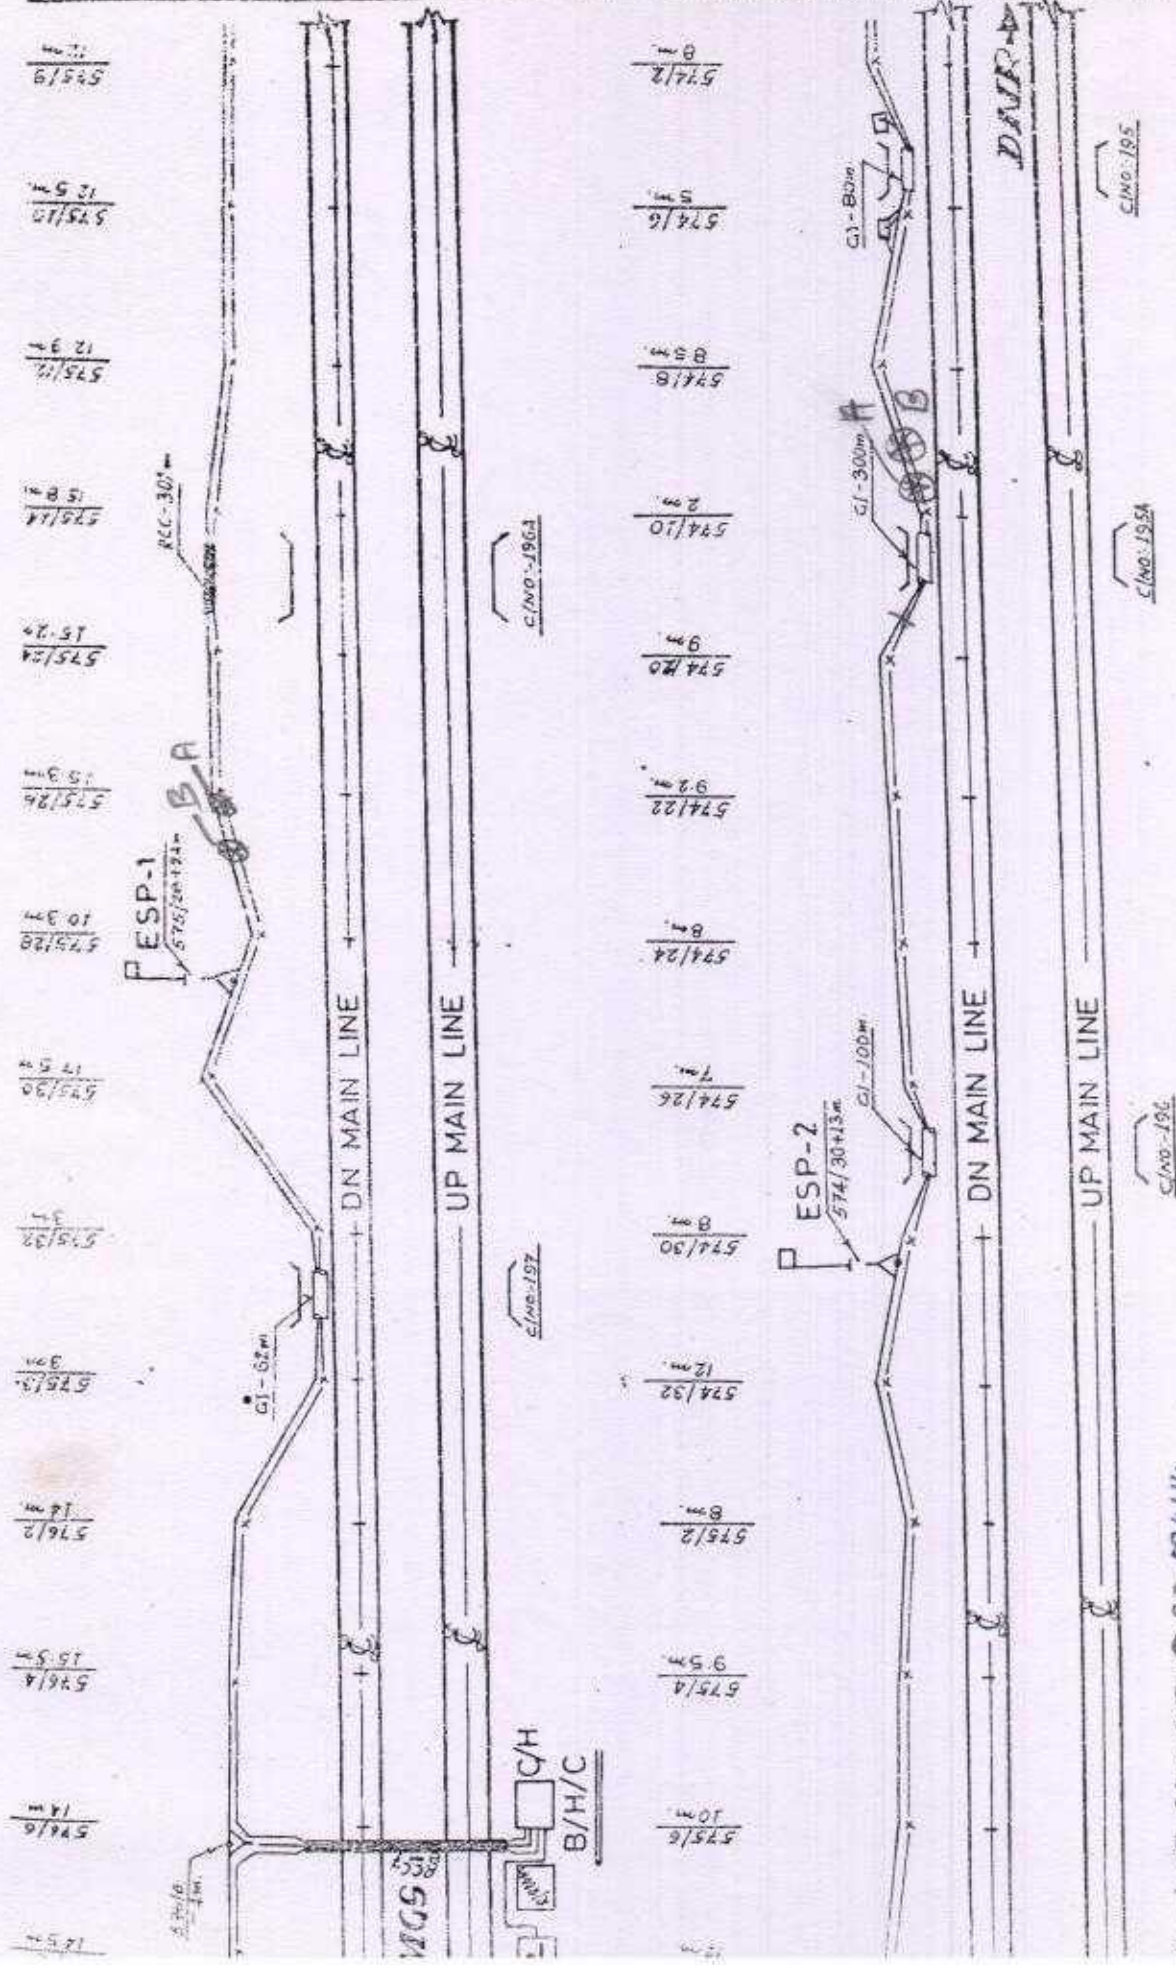

DRAWN BY	CHECKED BY
DRG NO:-STL / CORE / 901/97/21	
SHEET NO:- 2 OF 5	

10 - 27.50m EOT 18.30 574114
 A - 29.80 EOT 18.30 574114
 9 - 575126 - 11.20 X 12.30 - 12.40 X 13.30
 3 - 575126 - 12.40 X 13.30 - 13.40 X 14.30

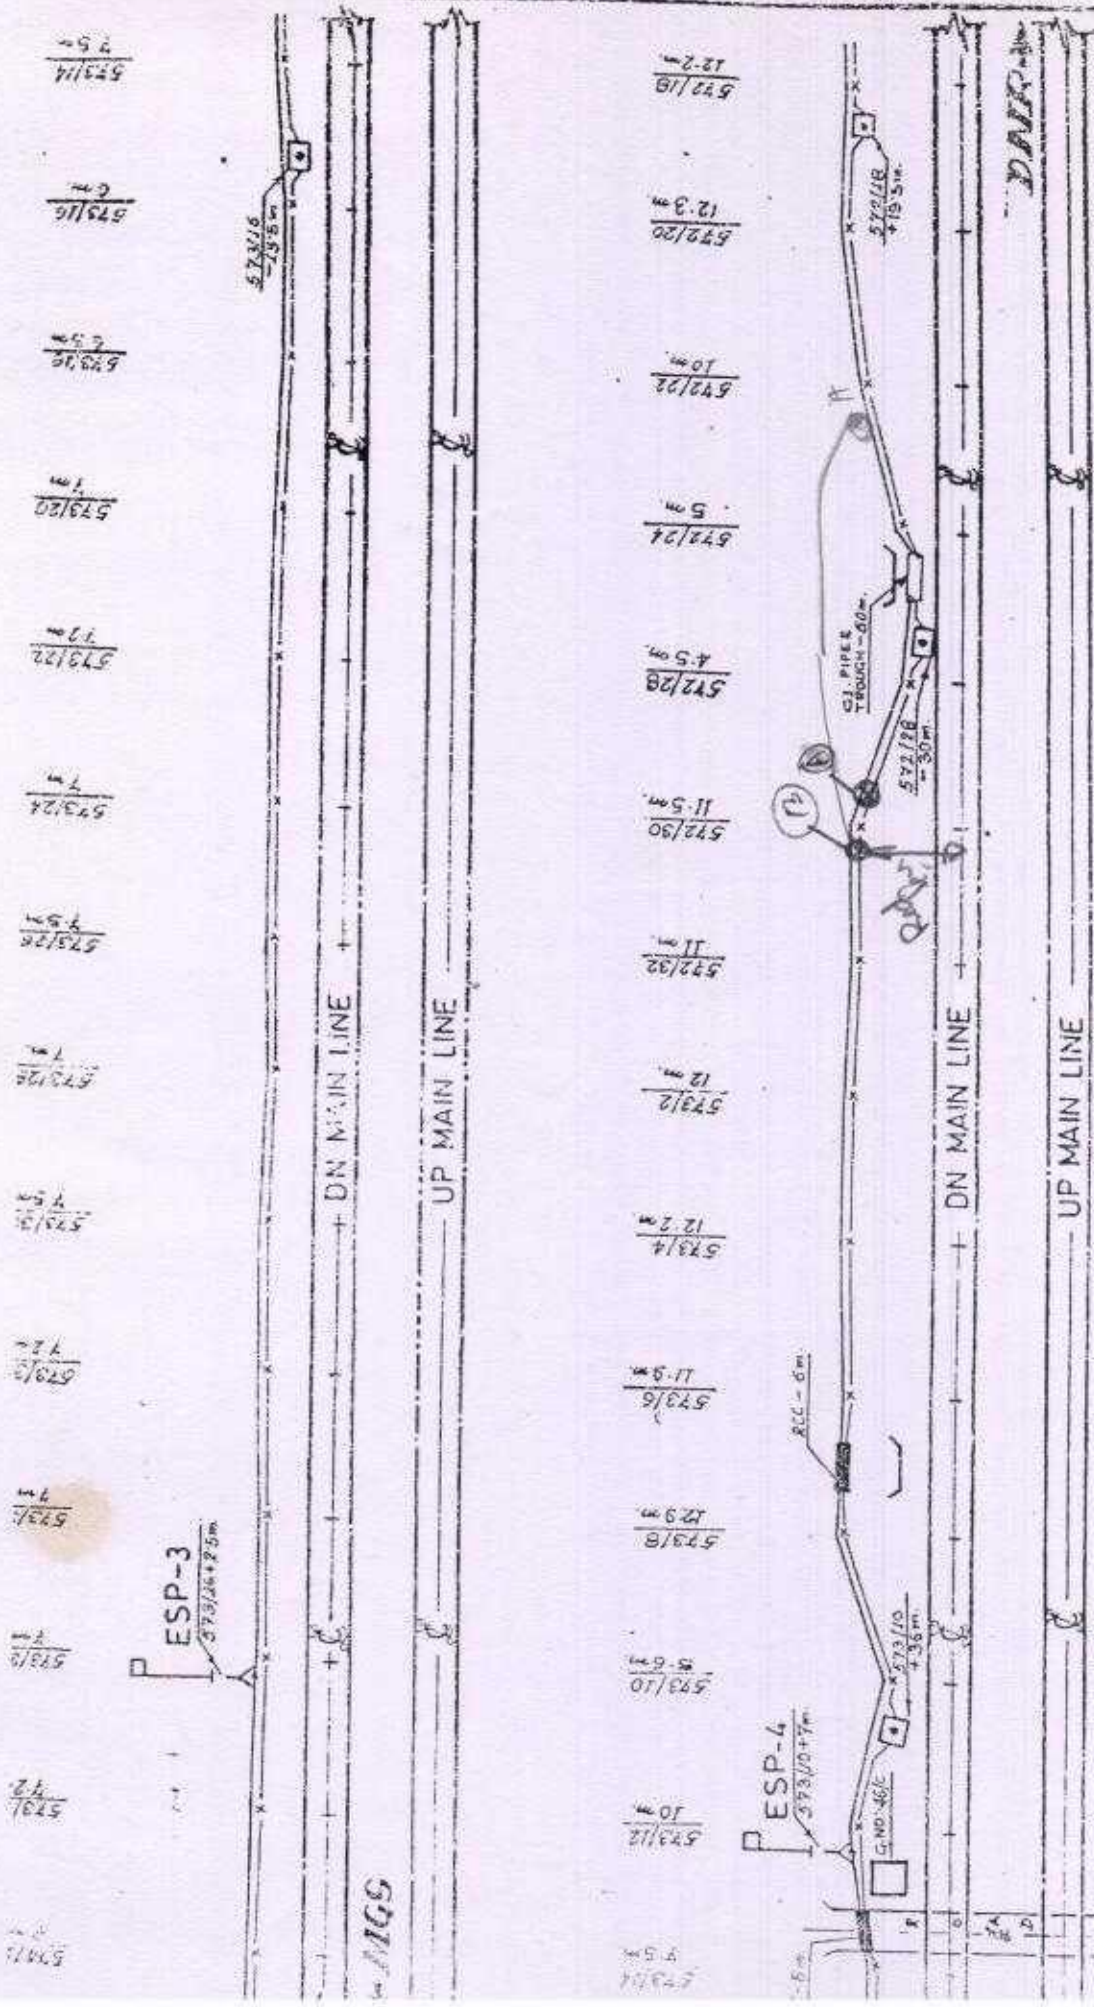

DRAWN BY	CHECKED BY
<i>B. Chatterjee</i>	<i>N. K. Chatterjee</i>
DRG NO-STL / CORE / 901/97/21	
SHEET NO:- 3 OF 5	


Temp, Date of int
 - Off set
 - Temp) low

A(572/24-4) 6.3
 B(572/30+5.50) 8.70

10/2/21

573/30+1.50x8.5m
 573/30+6m x 8.7m

DRAWN BY <i>Chatterjee</i>	CHECKED BY <i>A. V. S.</i>
DRG NO-STL / CORE / 301/97/21	
SHEET NO:- 4 OF 5	

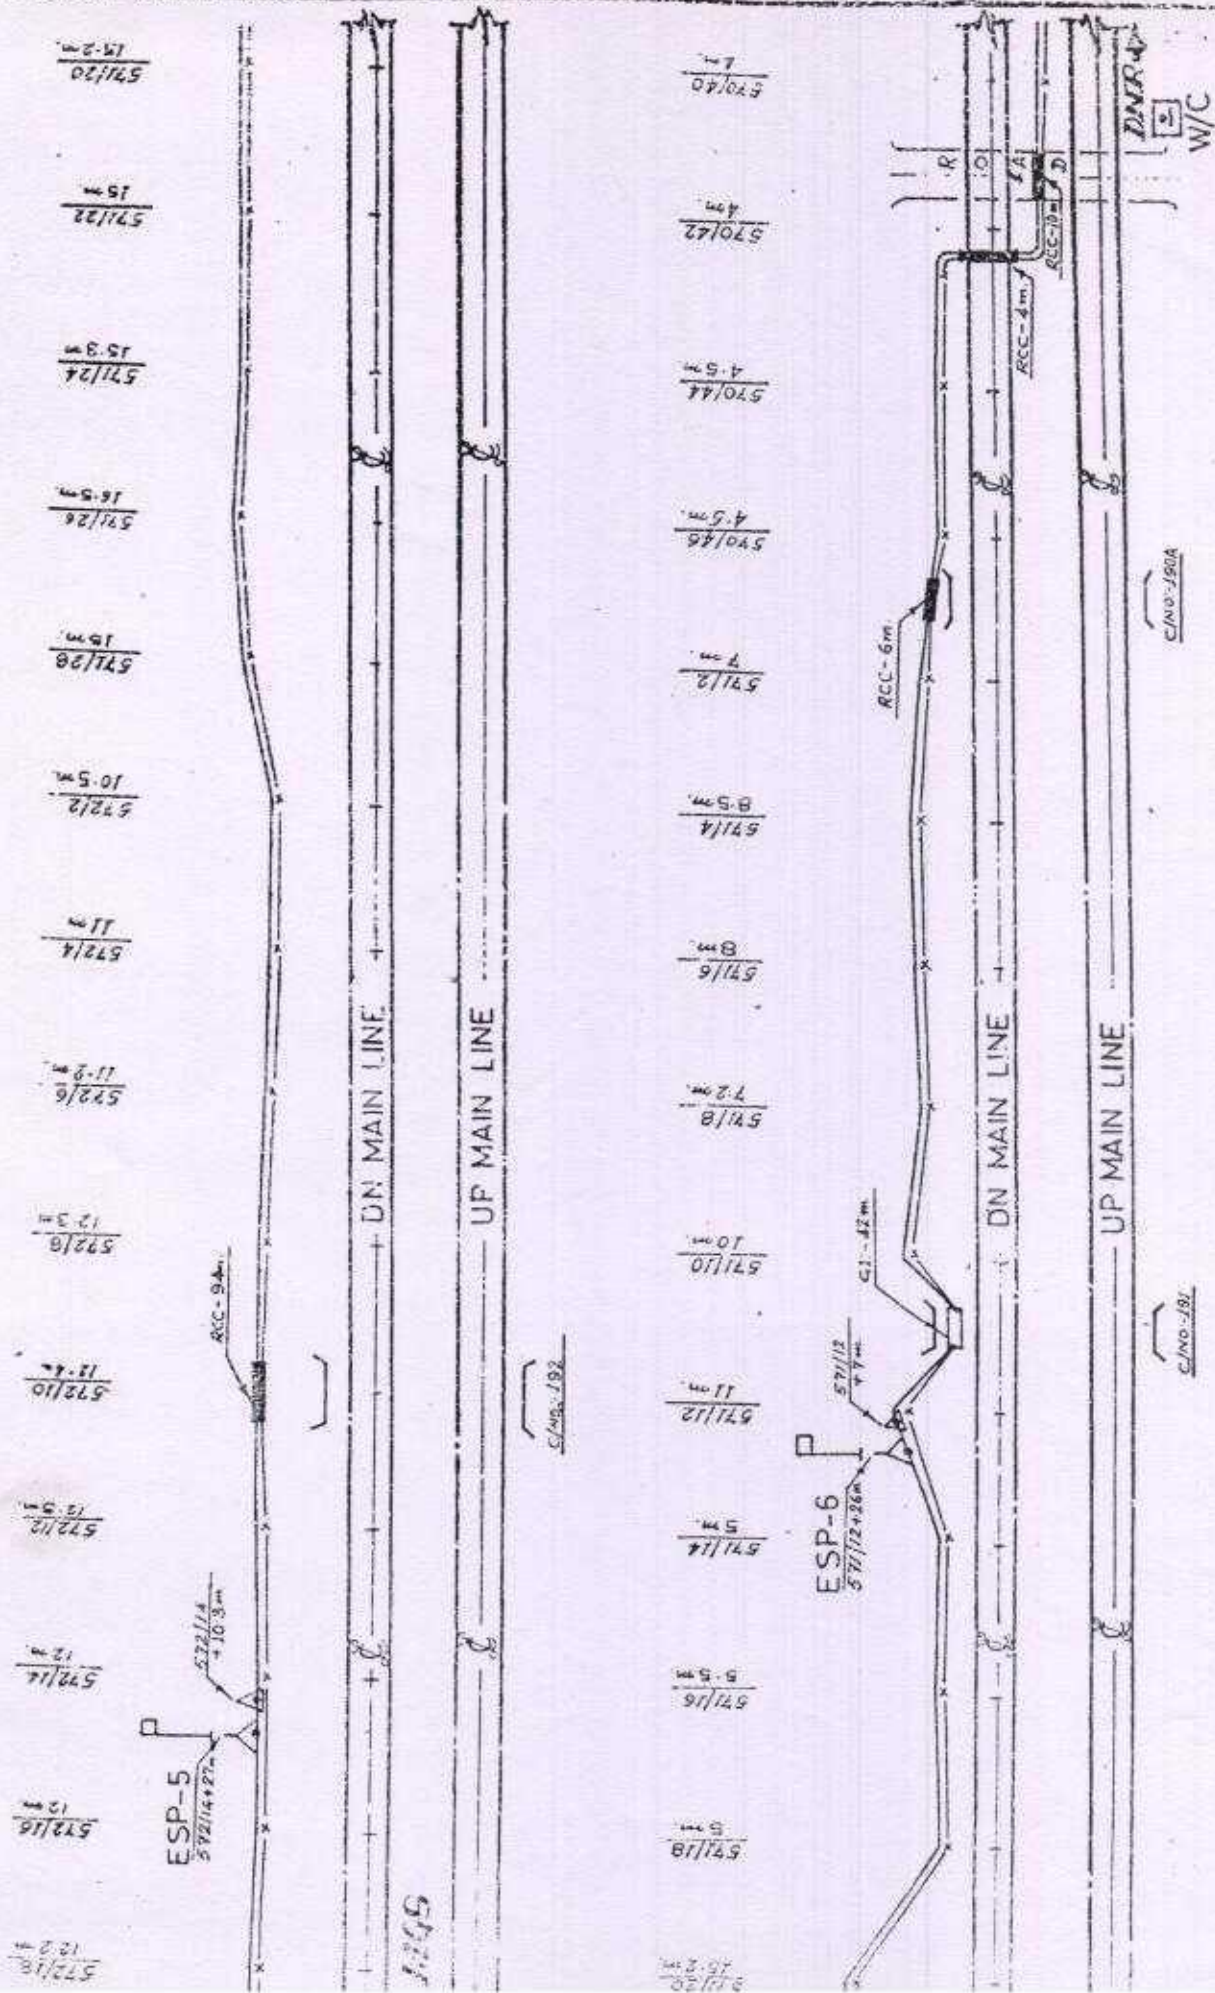

570/24
6m

570/26A
6.5m

570/30
6m

570/32
7m

1028
11m

1030
8m

570/38
4m

RCC-6m

RCC-6m

DN MAIN LINE

UP MAIN LINE

C/HUT
BIHTA

DNR

DRAWN BY <i>Shahaji</i>	CHECKED BY <i>N. K. K.</i>
DRG NO:- STL / CORE / 901/97/21	
SHEET NO:- 5 OF 5	

LEGEND

1. OFC CABLE ———— x ————
2. 4 QUAD CABLE ————
3. OFC JOINT ———— [] ————
4. 4 Q. 2T JOINT ———— [] ————
5. 4 Q. ST. JOINT ———— [] ————
6. RCC PIPE ———— [] ————
7. GI PIPE ———— [] ————
8. ESP ———— [] ————
9. ROAD ———— [] ————
10. CULVART ———— [] ————
11. CABIN ———— [] ————

NOTE

ALL DIMENTION ARE TAKEN FROM CENTER OF THE TRACK.

ALL DIMENTION ARE IN MTS.



RAILWAY ELECTRIFICATION PROJECT DANAPUR

AS BUILT DRAWING

TELECOM CABLE ROUTE PLAN OF BIHTA TO SADISOPUR SECTION

DRAWN BY	CHECKED BY	SCALE	NO OF SHEET
<i>[Signature]</i>	<i>[Signature]</i>	Not To Scale	1 OF 4
 SUPREME TELECOMMUNICATIONS LTD			DRG NO:— STL / CORE / 901/97/22 DATE :—


SE/RE/DNR	ASTE/RE/DNR	DY. CSTE/RE/DNR

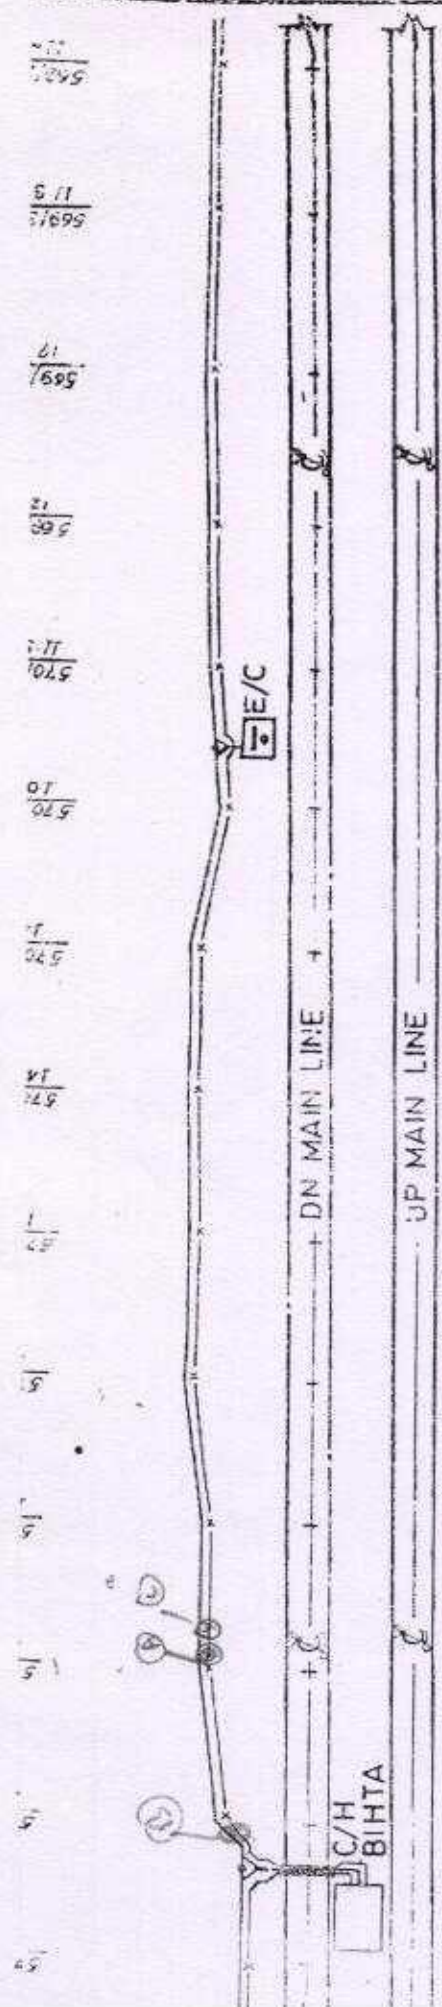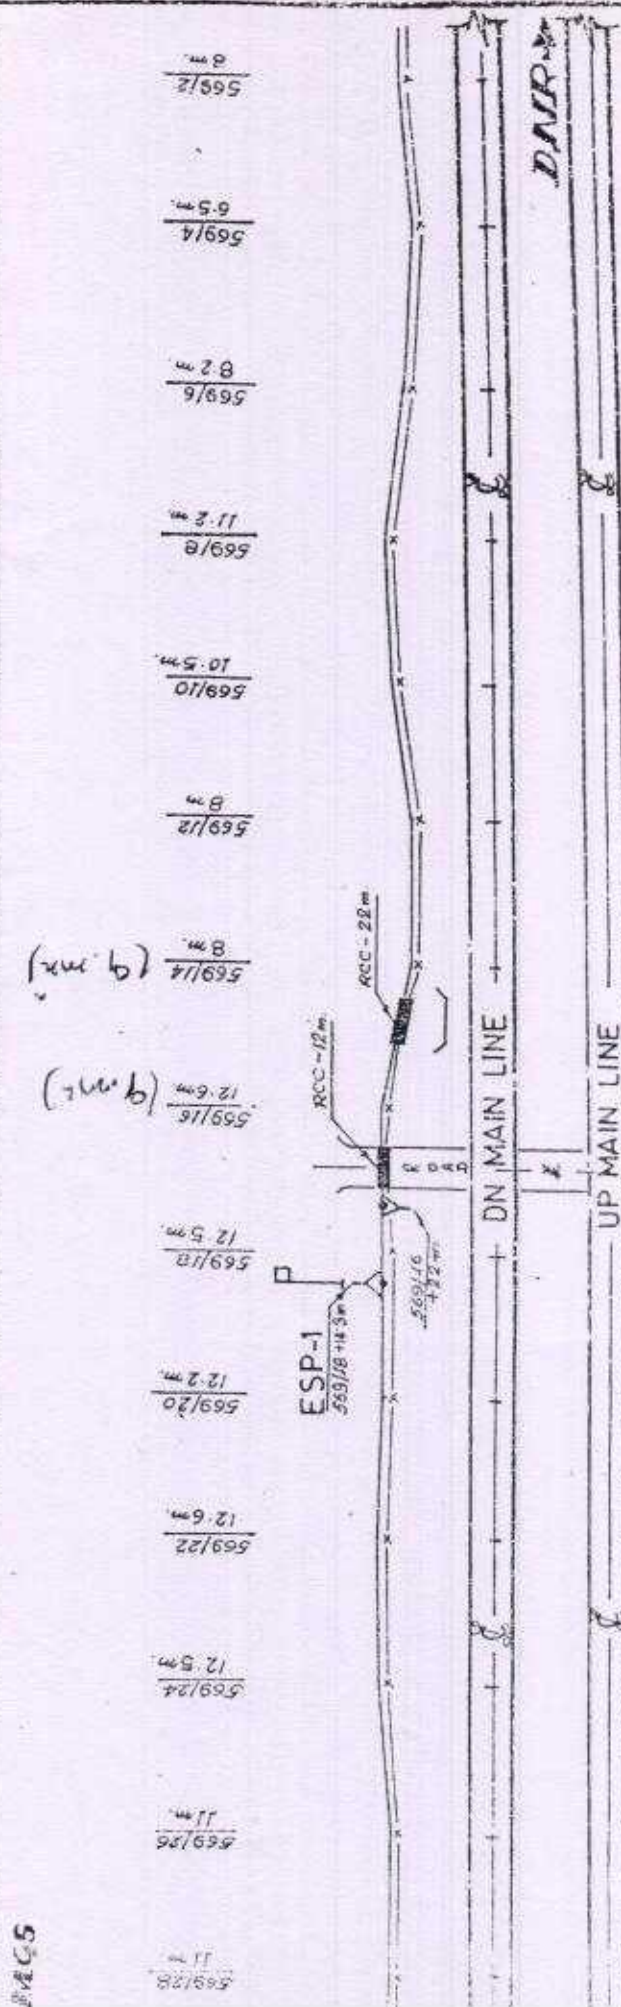

DRAWN BY	CHECKED BY
<i>Chatterjee</i>	<i>A. K. Chatterjee</i>
DRG NO:- STL / CORE / 901/97/22	
SHEET NO:- 2 OF 4	

01/03/13
 ① 570/16 - 14.5 x 14.5 mtr.
 ② 570/16 - 6.5 x 15.0 mtr.
 570-30 909 km from PUNE

570/18 + 24.8 x 24.8 mtr.
 C/NO:- JBZ

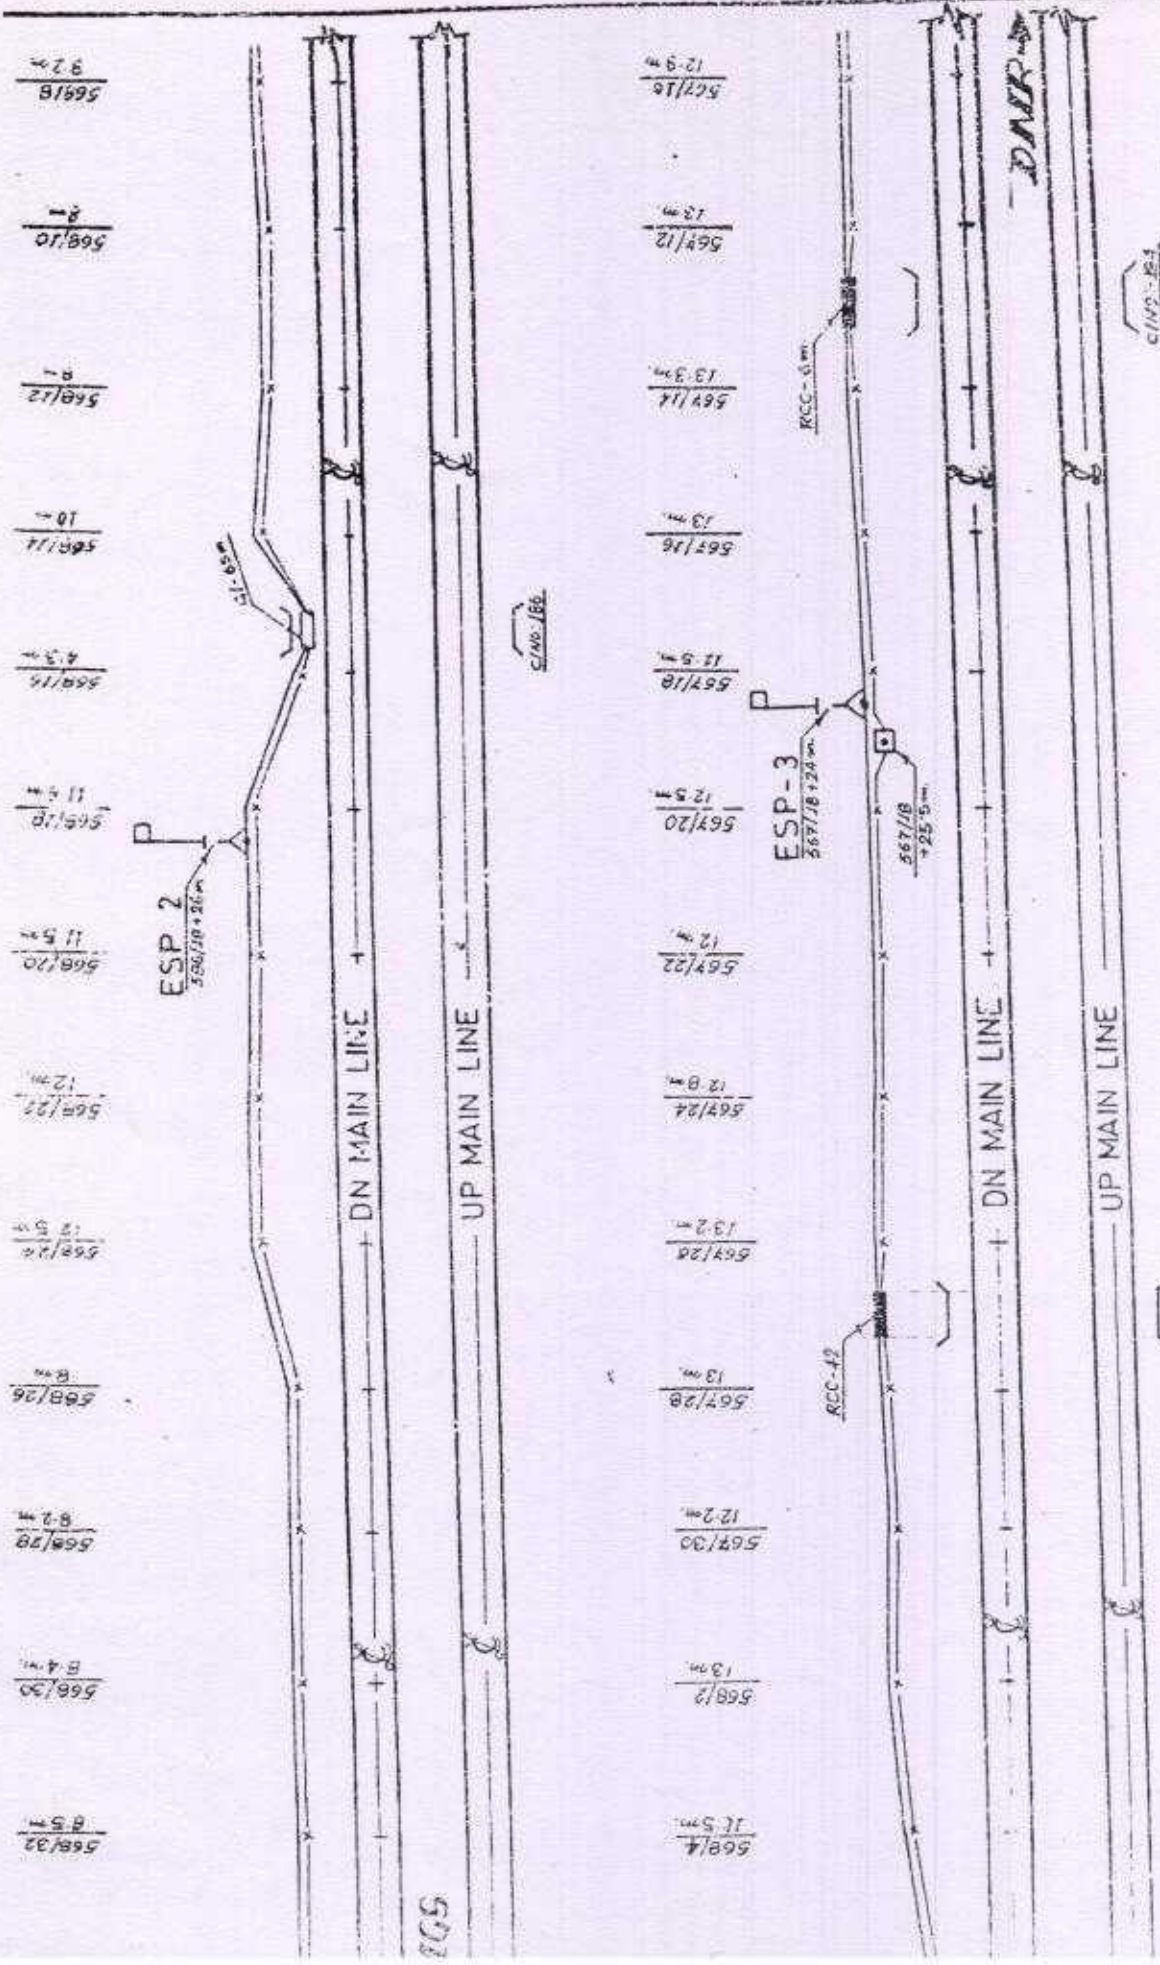

DRAWN BY	CHECKED BY
<i>Chatterjee</i>	<i>N. K. Saha</i>
DRG NO-STL / CORE / 901/97/22	
SHEET NO:- 3 OF 4	

$\frac{56718}{12m}$ $\frac{56716}{10.8m}$ $\frac{56714}{11m}$ $\frac{56712}{11m}$ $\frac{566136}{11.2m}$ $\frac{566134}{11.0m}$ $\frac{566132}{11.6m}$ $\frac{566130}{12.5m}$ $\frac{56612}{4m}$ $\frac{56612}{11.5m}$ $\frac{56612}{11.1m}$ $\frac{56612}{11m}$ $\frac{56612}{11.1m}$

ESP-4
566124/11.5m

51.70m

DN MAIN LINE

UP MAIN LINE

566183

265

$\frac{566116}{11.2m}$ $\frac{566113}{14.5m}$ $\frac{566111}{13.2m}$ $\frac{566109}{13.5m}$ $\frac{56617}{13.8m}$

DNR

DN MAIN LINE

UP MAIN LINE

CHUT SADISOPUR

DRAWN BY	CHACKED BY
<i>Diattop</i>	<i>N. C. S.</i>
DRG NO:- STL / CORE / 901/97/22	
SHEET NO:- 4 OF 4	

LEGEND

1. OFC CABLE	— x —
2. 4 QUAD CABLE	— — — —
3. OFC. JOINT	— [] —
4. 4Q. 2T JOINT	— [] —
5. 4Q. ST. JOINT	— [] —
6. RCC. PIPE	— [] —
7. G.I PIPE	— [] —
8. E.S.P.	— [] —
9. ROAD	— [] —
0. CULVART	— [] —
1. CABIN	— [] —

NOTE

1. ALL DIMENTION ARE TAKEN FROM CENTER OF THE TRACK.
2. ALL DIMENTION ARE IN MTS.




RAILWAY ELECTRIFICATION PROJECT DANAPUR

AS BUILT DRAWING




TELECOM CABLE ROUTE PLAN OF SADISOPUR TO NEORA SECTION

DRAWN BY	CHACKED BY	SCALE	NO OF SHEET
<i>Digit - Arthya</i>	<i>N. K. Arthya</i>	$\neq$ Not To Scale	1 OF 6
 SUPREME TELECOMMUNICATIONS LTD.			DRG NO: — STL / CORE / 901 / 97 / 23 DATE: —

E/SSE/RE/DNR	ASTE/RE/DNR	DY. CSTE/RE/DNR

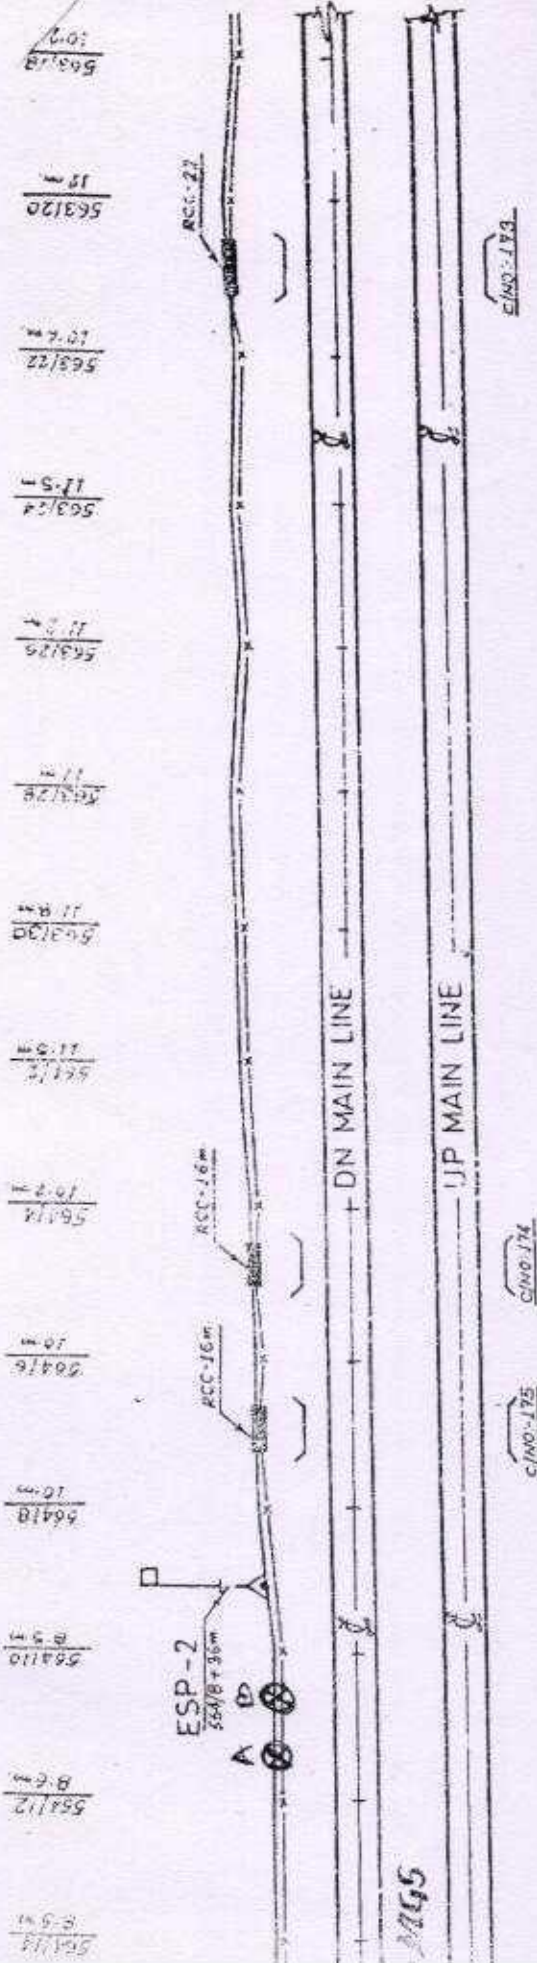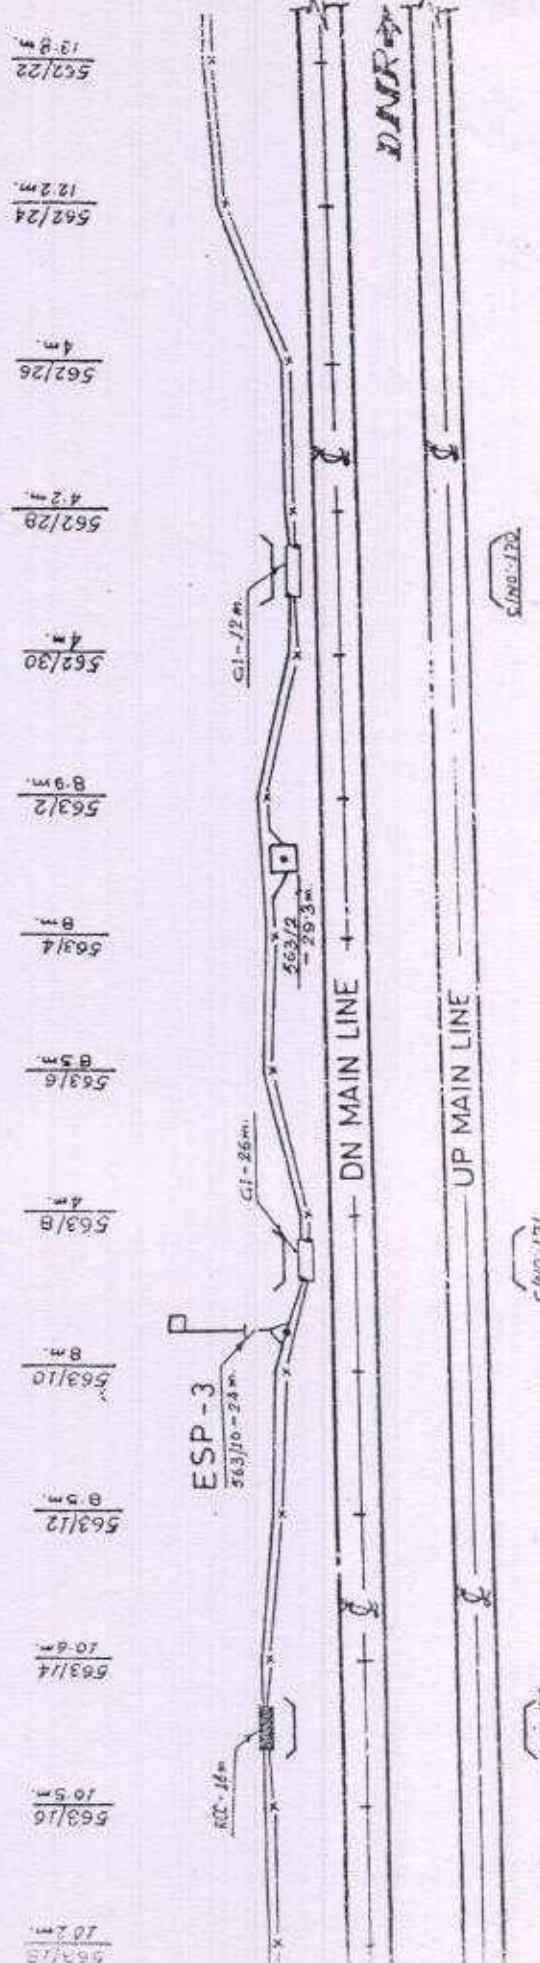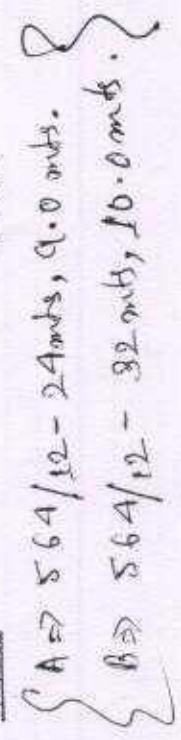


DRAWN BY	CHECKED BY
G. Hattarajin	A. K. K. K.
DRG NO:- STL / CORE / 901/97/23	
SHEET NO:- 3 OF 6	

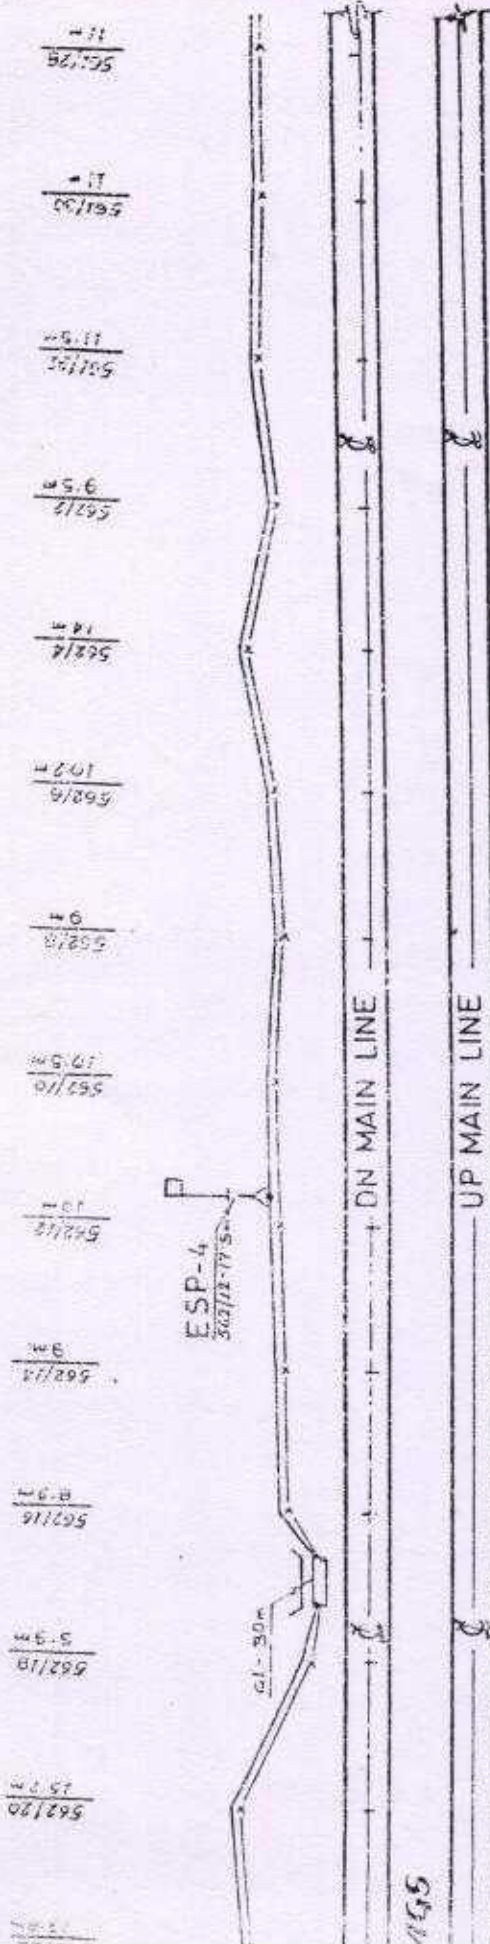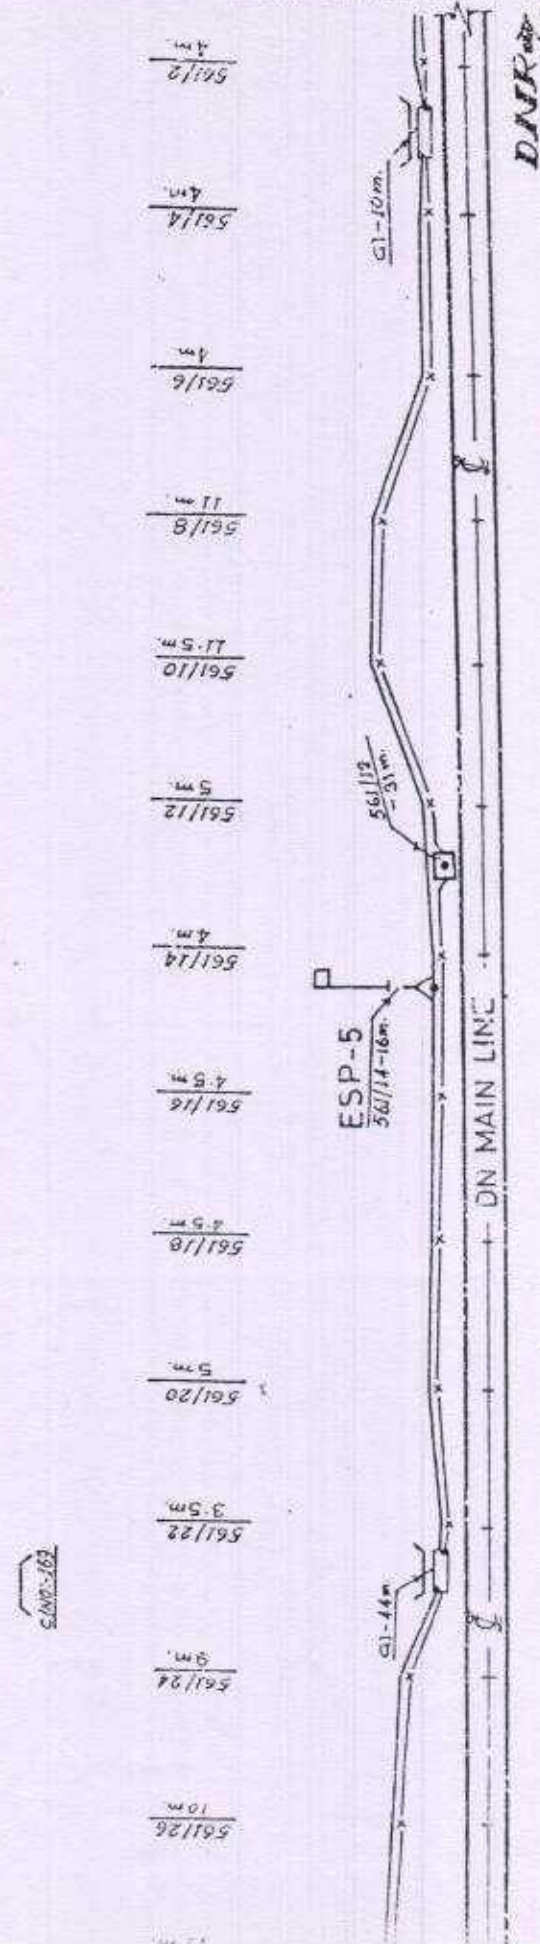
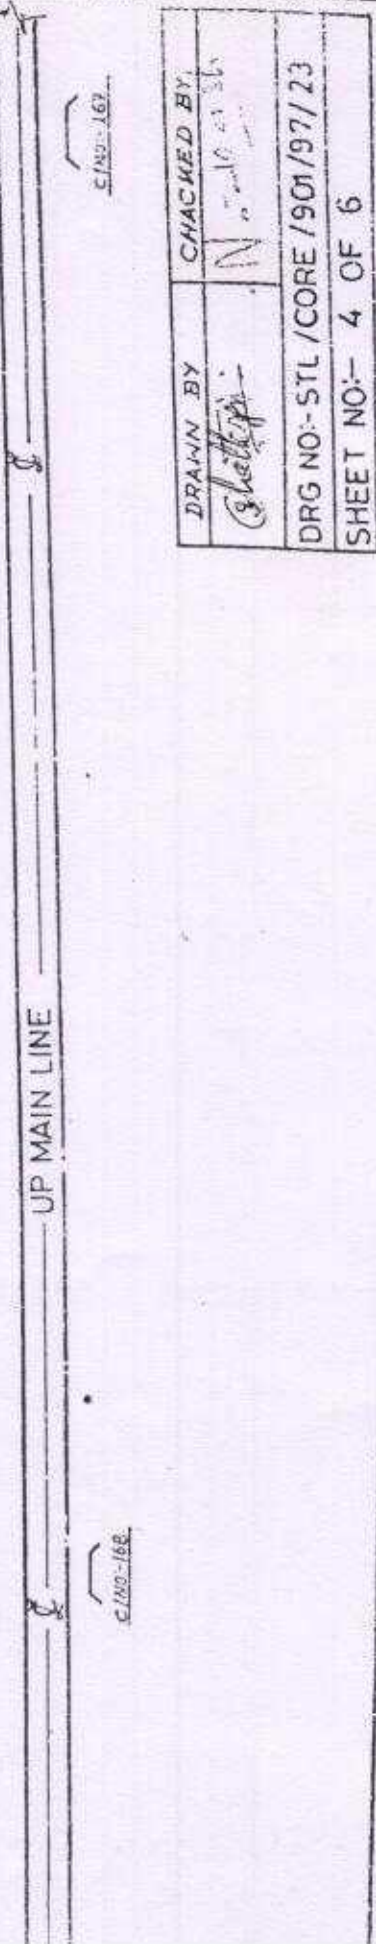


DRAWN BY	CHACKED BY
Ghathapi	N. S. S.
DRG NO:- STL / CORE / 901/97/23	
SHEET NO:- 4 OF 6	

DRAWN BY	CHACKED BY
<i>Chatterjee</i>	<i>N. K. Singh</i>
DRG NO:- STL / CORE / 901 / 97 / 23	
SHEET NO:- 5 OF 6	

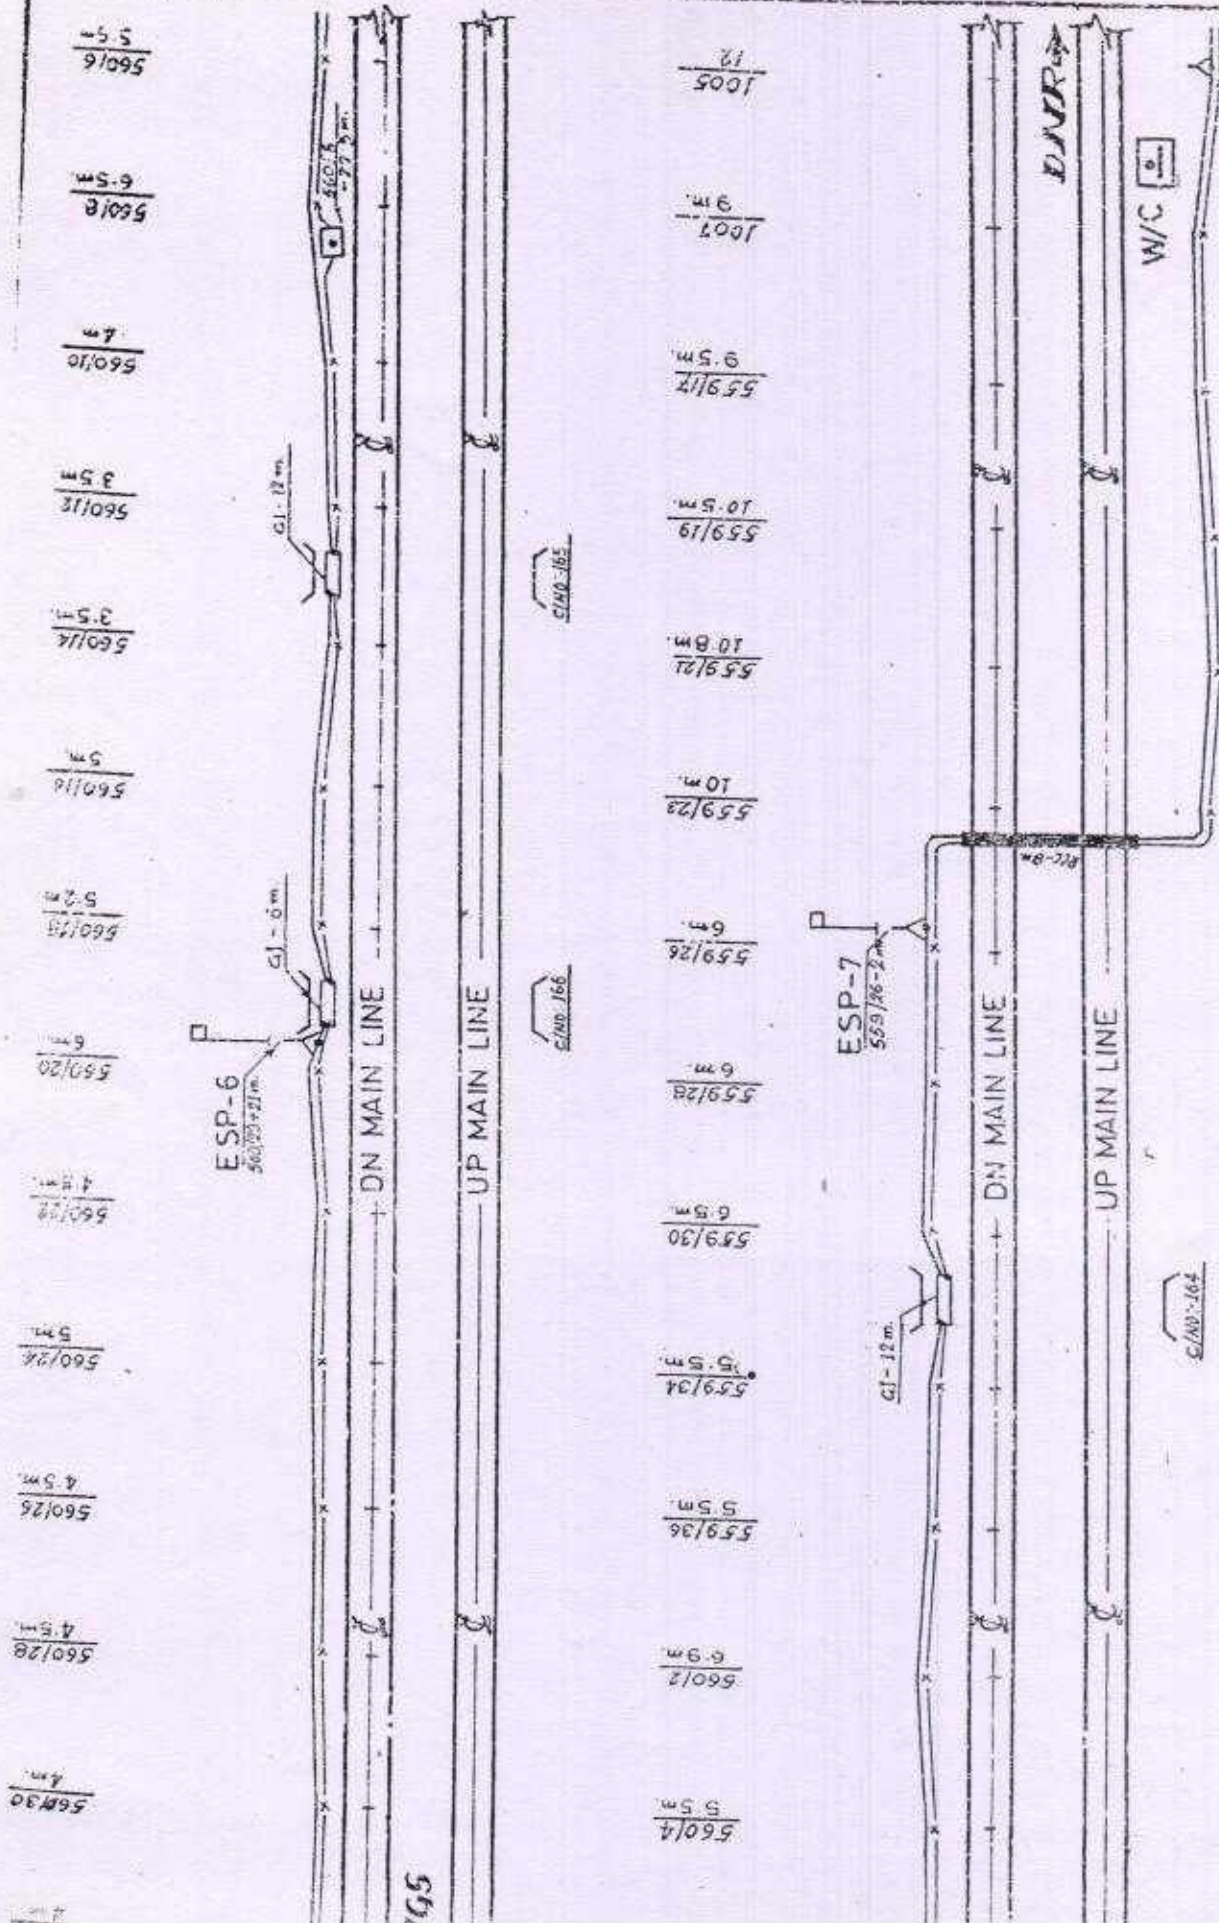


1005
1003
9 m
1001
9.5 m
559/9
8.5 m
559/7
8 m
559/5
12.5 m
559/3
14.7 m
559/1
22.5 m

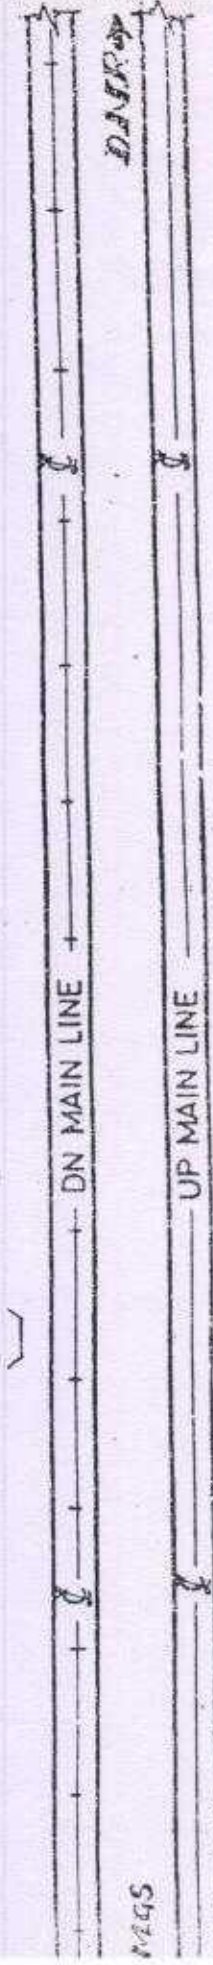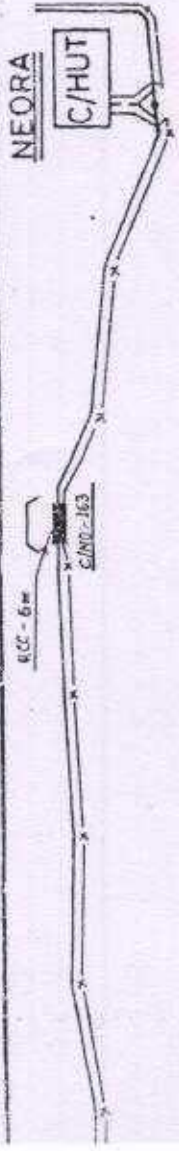

DRAWN BY <i>Shakti</i>	CHECKED BY <i>V. K. 10/10/10</i>
DRG NO:- STL / CORE / 901/97/23	
SHEET NO:- 6 OF 6	

RAILWAY ELECTRIFICATION PROJECT DANAPUR

AS BUILT DRAWING

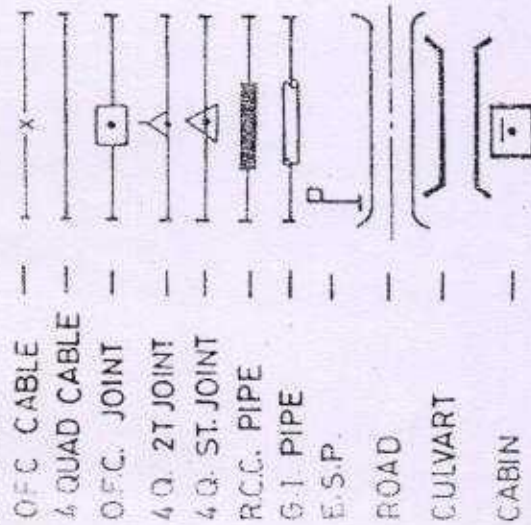



NOTE

ALL DIMENTION ARE TAKEN FROM
CENTER OF THE TRACK.

ALL DIMENTION ARE IN MTS.

TELECOM CABLE ROUTE PLAN OF NEORA TO DANAPUR SECTION

DRAWN BY	CHECKED BY	SCALE	NO OF SHEET
<i>S. J. K. Adhikari</i>	<i>N. K. S. 10.01.86</i>	$\neq$ Not To Scale	1 OF 6
		SUPREME TELECOMMUNICATIONS LTD.	
SSE/RE/DNR		DRG NO.:-	
ASTE/RE/DNR		STL/CORE/901/97/24	
		DATE:-	

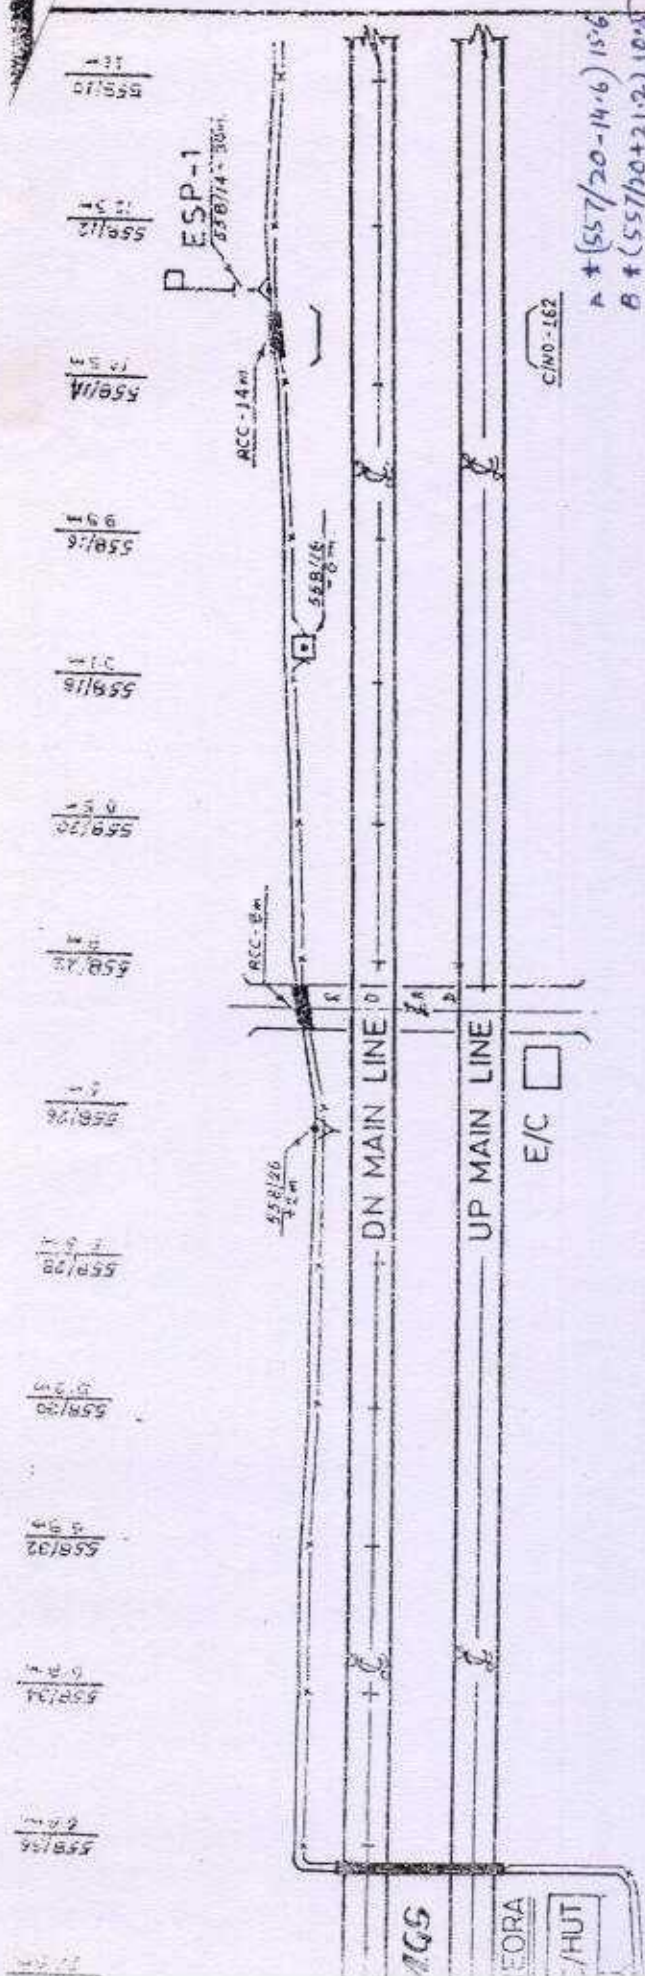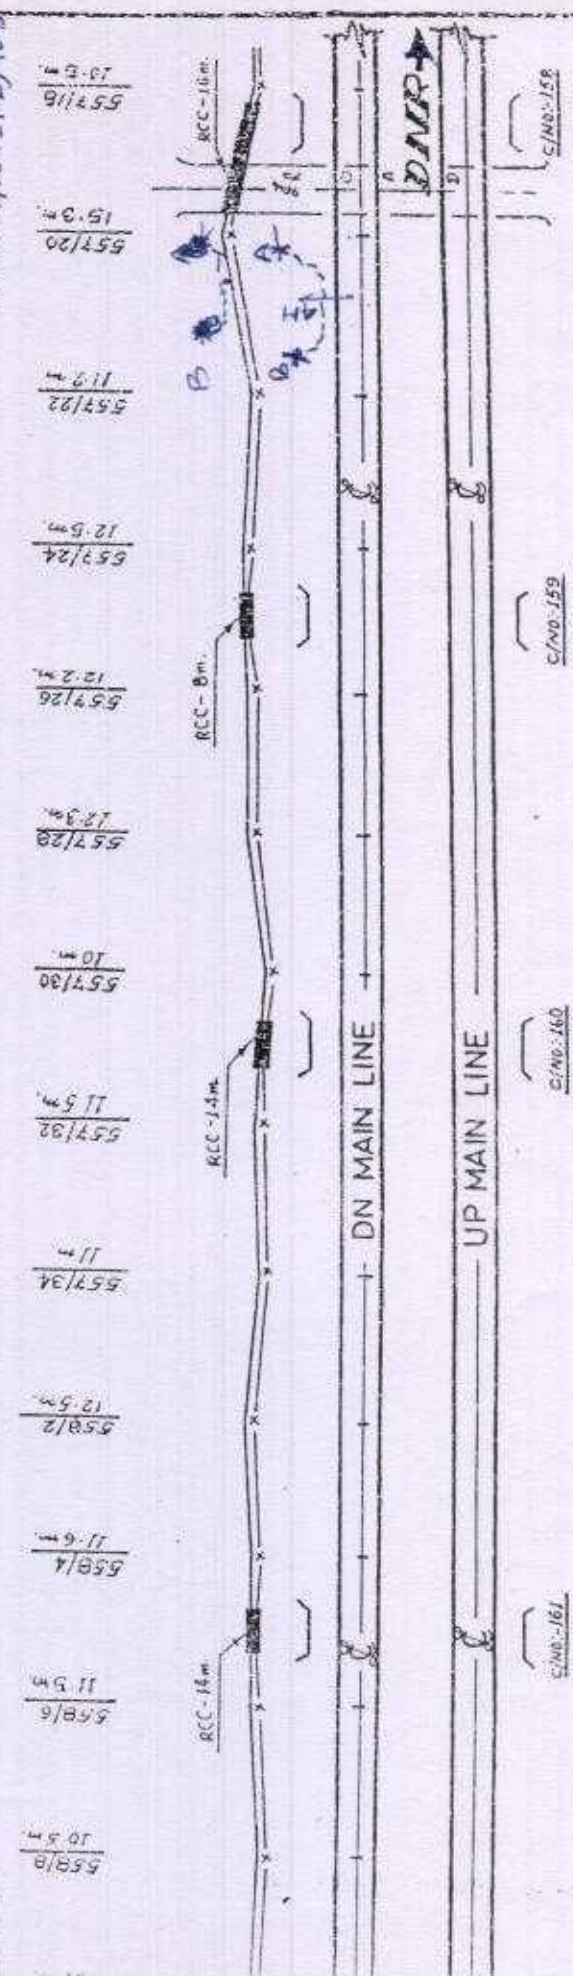

DRAWN BY	CHECKED BY
<i>B. J. J. J.</i>	<i>N. J. J. J.</i>
DRG NO:-STL / CORE / 901/97/24	
SHEET NO:- 2 OF 6	

DRG NO:-STL /CORE/901/97/24

SHEET NO:- 2 OF 6

