


Devi. d

Experiments

APPROVED	DATE	BY	OFFICE
			CABLE
RECEIVED	DATE	BY	OFFICE
			CABLE

LEGEND

SLAYING OF GUY CARL IN HOPE
SLAYING OF JERRY CARL SHOWN
SLAYING OF WENDY CARL SHOWN
HARRIS REPORT JOHN SPOON
SPOON LEAD RECALL
BRIEF REPORT
REPORT ON THE
RECALL ON THE

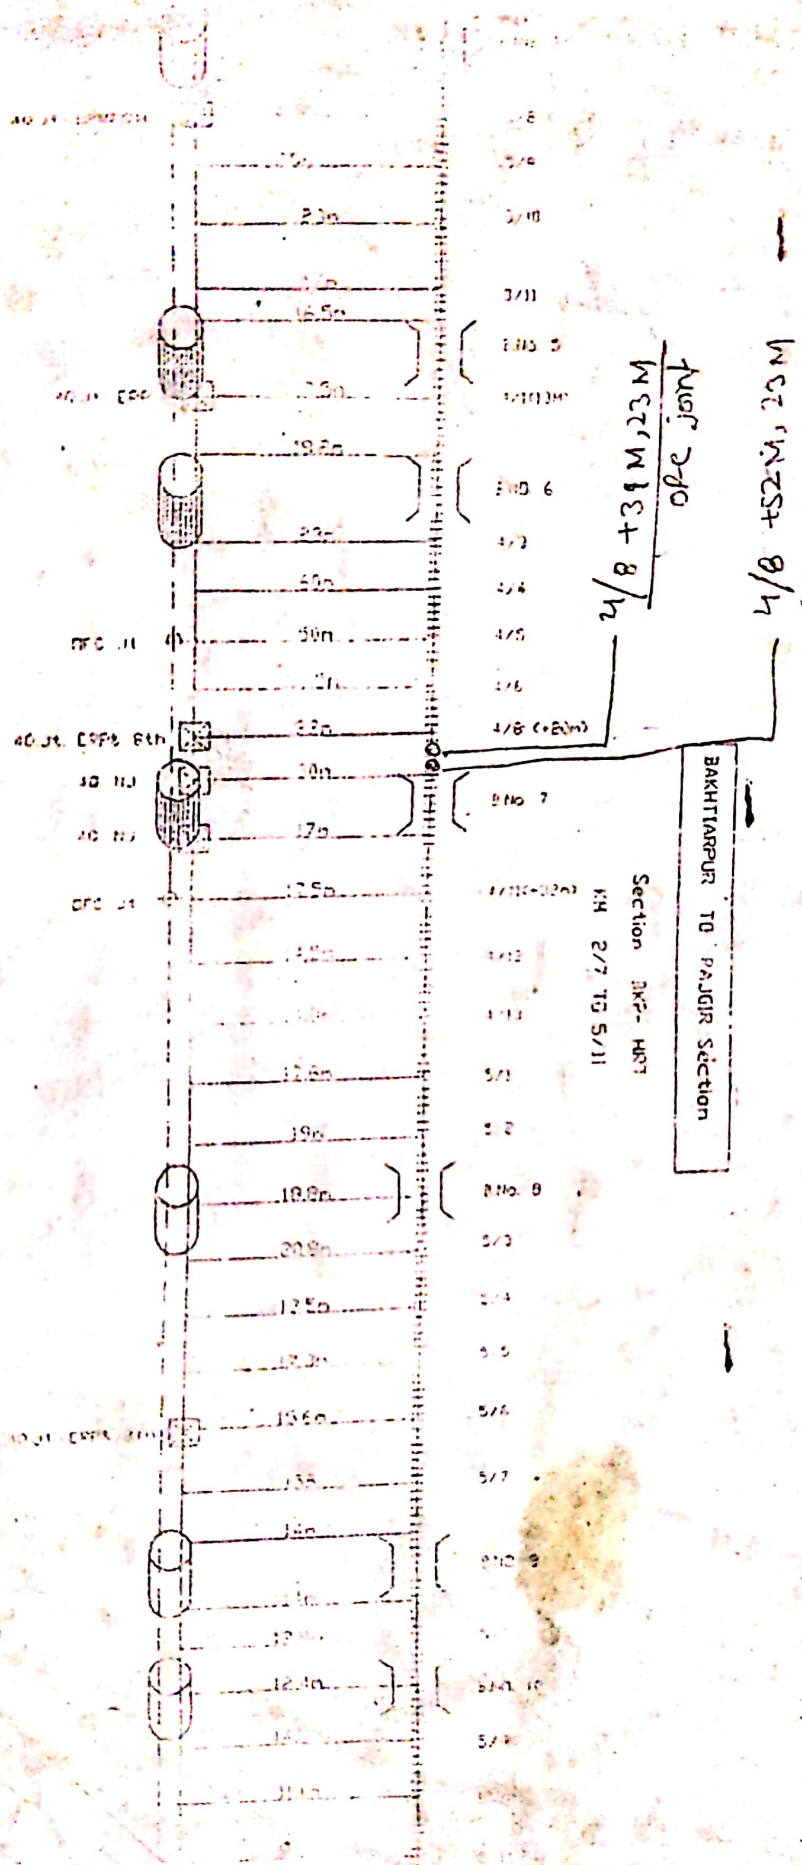

M/S SAIGON CO., LTD.
CHIEF | ACCOUNT
Saiyudin
Proprietor

REC'D 12/15 1978	DATE 10/28 1978	TIME 1:10 PM	REC'D 12/15 1978
------------------------	-----------------------	--------------------	------------------------

LEGEND

1. LAYING OF D/C CABLE IN HDPE PIPE
2. LAYING OF 4 CORED CABLE SHOWN
3. LAYING OF 10/20 CABLE IN SHOWN
4. 4 CORED CABLE JOINT SHOWN
5. D/C JOINT SHOWN
6. 1 PIPE AT BENCH
7. 500 C PIPE AT BENCH
8. 600 PIPE ON TRUCK

(К.Н. 6.33)
К.Н.РАУРА'Н

40. J1. ERP & 8th

BAKHTIARPUR TO RAJGIR Section

Section BKP-47
Km. 5.11 TD 7.9

M/S GATINDEA SINGH	
CHEER	APPROVED
Vaidya	

Propósito:

APPROVED	CHECKED	DFC
IN CASE C.V. D. 67	BASIC C.V. D. 67	CABLE ROUTE
	STG/VV 6/6/67	PLAN

LEGEND

FLAYING OF OFC CABLE IN HDPE PIPE
FLAYING OF 4 QUARD CABLE SHOWN
FLAYING OF 10/20 PAIR-PIE SHOWN
4.4000RN CABLE JOINT SHOWN
SUDC JOINT SHOWN
6.6.1 PIPE AT BRIDGE
7.R.L.C PIPE AT BRIDGE & L/C GATE
8.G.I PIPE ON BRIDGE

BAKHTIARPUR TO RAJGIR Section

Section : BKP- HRT

K.M. 7/9 TD 9/3

7/16

7/11

7/12

7/13

7.14

871

P.N.O. 19

P.H.G. 19 (+24r)

5/2

2.7

18 Nov. 20

8/4

•

9/7

END. 2)



1

1

10


3

3

5

1

10/7 10/3 5/3 10/7

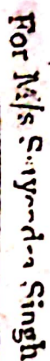

LEGEND

1. LAYING OF OFC CABLE IN HDPE PIPE
 2. LAYING OF 4 GUARD CABLE SHOWN
 3. LAYING OF 10/20 PAIR-PIE SHOWN
 4. 4-GUARD CABLE JOINT SHOWN
 5. OFC JOINT SHOWN
 6. GI. PIPE AT BRIDGE
 7. RCC PIPE AT BRIDGE & L/C GATE
 8. GI PIPE ON BRIDGE




OFC Dt. (G2N8) / 20.03.2012
 i) 12/6, + 37M x 8.3M
 ii) 12/6, + 50.5M x 6.2M

DAKHIAIPUR TO RAJGIR SECTION

SECTION : HRT TO WEND

KM 10/7 TO 12/8

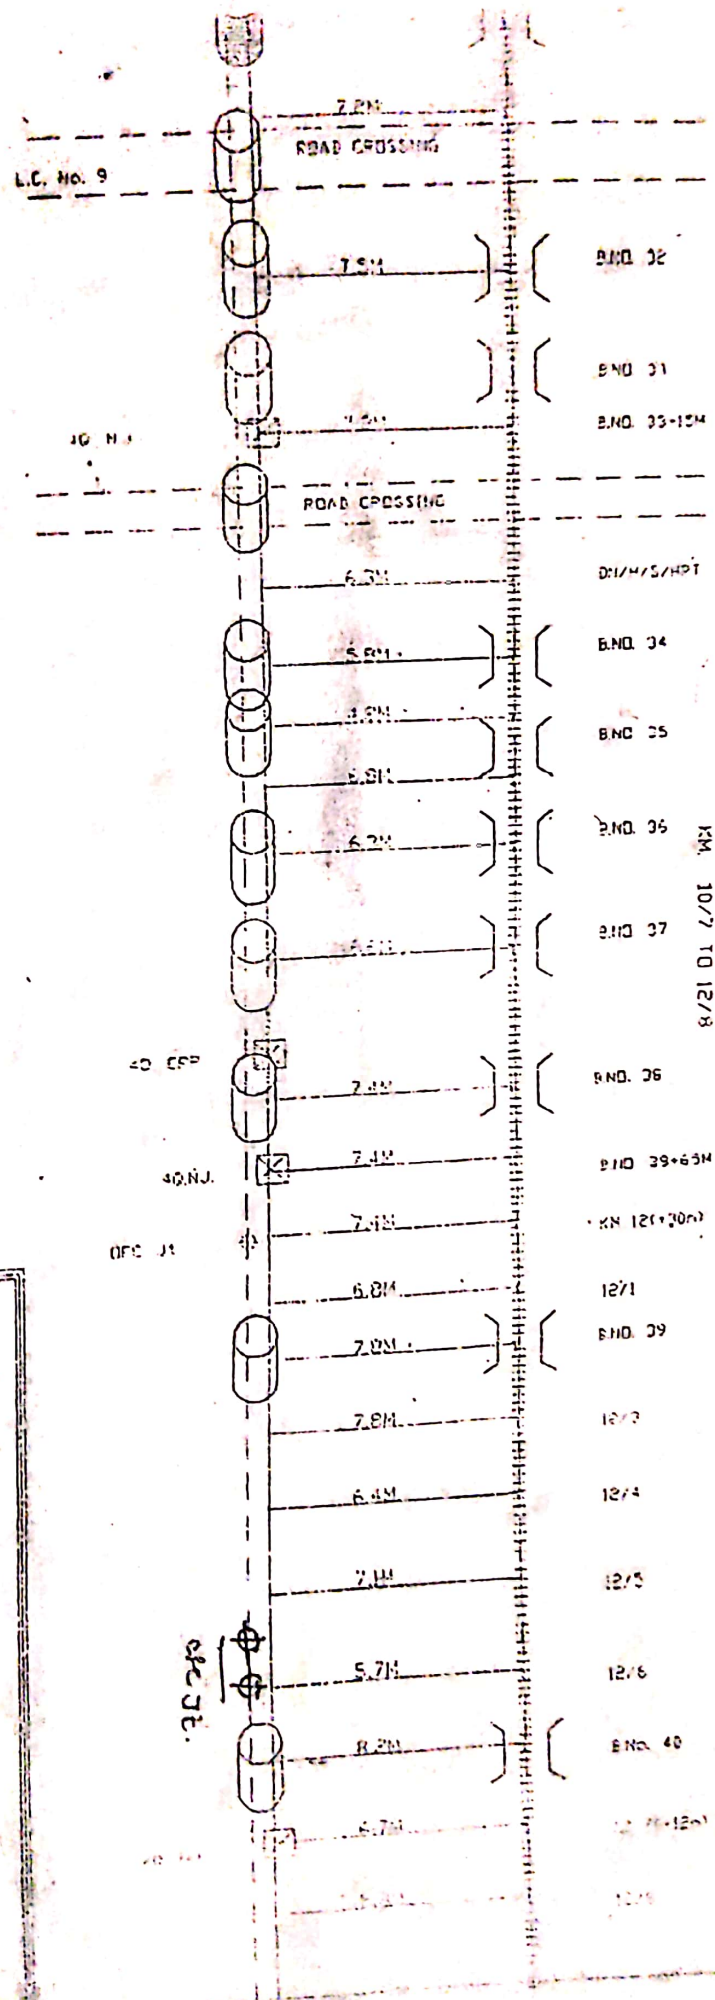

For M/s Sanyard Singh

NO. 1	NO. 2	NO. 3	NO. 4
10/5	10/5	10/5	10/5

Proprietor

APPROVED	DATE	BY
RECEIVED	DATE	BY

LEGEND

- LAYING OF OFC CABLE IN HDPE PIPE
- LAYING OF 4 QUARD CABLE SHOWN
- LAYING OF 10/20 PAIR-PLIE SHOWN
- QUARD CABLE JOINT SHOWN
- OFC JOINT SHOWN
- 60.1 PIPE AT BRIDGE
- 70.1 PIPE AT BRIDGE & L/C GATE
- 80.1 PIPE ON BRIDGE

DATE	APPROVED
S. J. T. under	

Proprietor

APPROVED	CHECKED	DFC
DATE 4/2/00	DATE (C/O/D)	ROUTE PLAN

LEGEND

LEAVING OF OFC CABLE IN HOPE PFT
 PLATING OF 4 DUAED CABLE SHOWN
 SLAVING OF 10/20 PAIR-PIE SHOWN
 4-ADUAED CABLE JOINT SHOWN
 450FC JOINT SHOWN
 3-6G1 PIPE AT BRIDGE
 4-78CC PIPE AT BRIDGE & L/C SATE
 3-6G1 PIPE ON BRIDGE

BAKHTIARPUR TO RAJGIR Section

Section : HRT TD WEEK 4

KM. 12/8 TD 14:7

12/10
12/11
12/12(+18n)
12/13
12/14
12/15
BND 41
13/1
13/2
13/3(+18n)
13/4
13/5
BND 42
BND 43
13/7(+13n)
13/8
13/9
13/10
13/11
13/12
13/13
13/14
BND 44
14/1
14/2
14/3
14/4
BND 45

MPFARNI KALT

40. ५५

ERD

KM 14/7 TD 15/13

VERA 315
RM 15-28

1.LAYING OF OFC CABLE IN HDPE PIPE
2.LAYING OF 4 GUARD CABLE SHOWN
3.LAYING OF 10/20 PAIR-PIE SHOWN
4.GUARD CABLE JOINT SHOWN
5.OFC JOINT SHOWN
6.G.I. PIPE AT BRIDGE
7.R.C.C PIPE AT BRIDGE & L/C GATE.
8.G.I. PIPE ON BRIDGE

M/S SATYENDRA SINGH	
EMERGED	APPROVED
S. Satendra Singh	


	APPROVED	CHECKED		OFC CABLE ROUTE PLAN
			<i>Shaw</i>	
BY: SIE (C)/DNR	DATE (C)/DNR	SENT/W DNR		

~~OFC~~
CABLE
ROUTE
PLAN

BAKHTIARPUR TO RAJGIR Section

Section : WENA TO BHIS.

KN15/13 TO 17/7

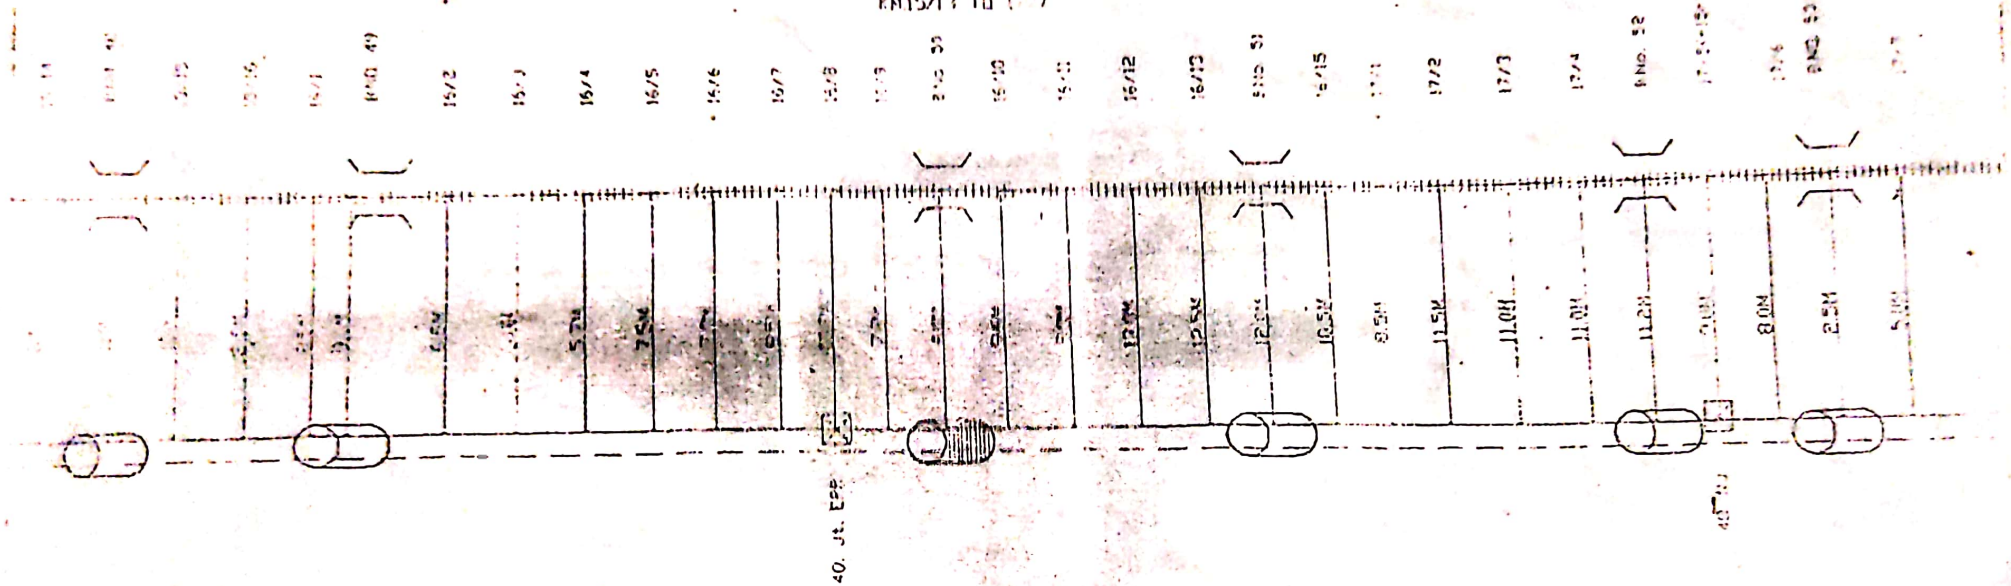

For M/s Satyendra Singh

M/S SATYENDRA SINGH	
CHECKED	APPROVED
Satendra	

Proprietor

APPROVED	DATE	BY	DATE	BY

DPC
CABLE
ROUTE
PLAN

LEGEND


1. LAYING OF DFC CABLE IN HOPE PIPE
2. LAYING OF 4 QUARD CABLE SHOWN
3. LAYING OF 10/20 PAIR-PIPE SHOWN
4. QUARD CABLE JOINT SHOWN
5. DFC JOINT SHOWN
6. G.I. PIPE AT BRIDGE
7. R.C.C. PIPE AT BRIDGE & 1/2 GATE
8. G.I. PIPE ON BRIDGE



BAKHTIARPUR TO RAJGIR Section

Section VENA TO BENS

KM 17/7 TO 19/12

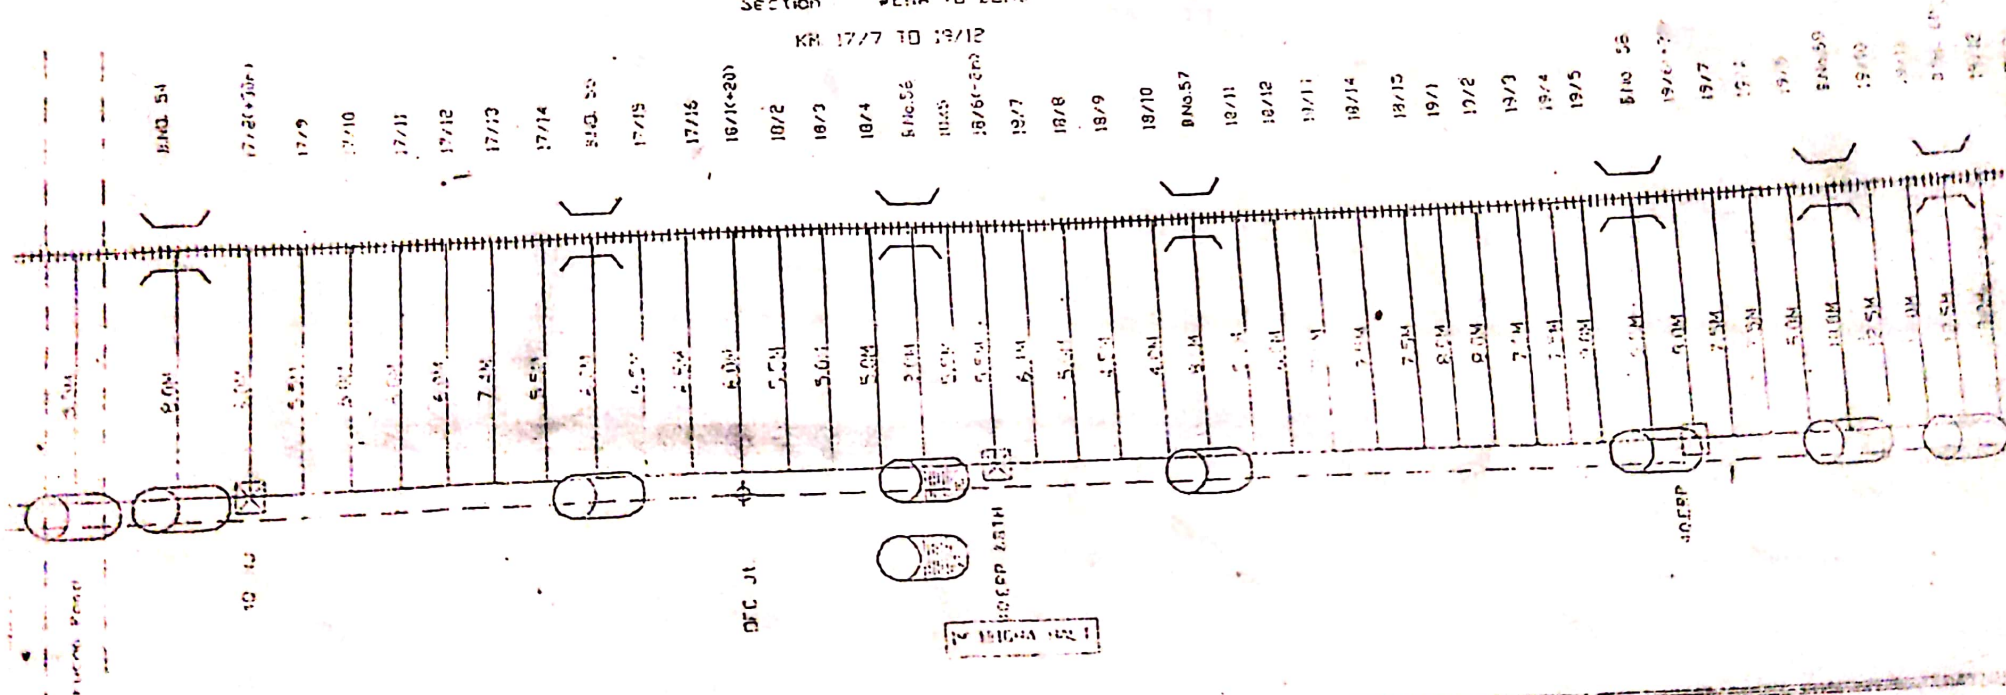

For M/s Sanyendra Singh

M/S SANYENDRA SINGH	APPROVED
OWNER	APPROVED
Sanyendra Singh	

Proprietor


DATE	APPROVED	OWNER	DATE	APPROVED	OWNER

LEGEND

1. LAYING OF DFC CABLE IN HOPE PIPE
2. LAYING OF 4 GUARD CABLE SHOWN
3. LAYING OF 10/20 PAIR-PIPE SHOWN
4. GUARD CABLE JOINT SHOWN
5. DFC JOINT SHOWN
6. G.I. PIPE AT BRIDGE
7. R.C.C. PIPE AT BRIDGE & L/V GATE
8. G.I. PIPE ON BRIDGE



19:10 15 21:45

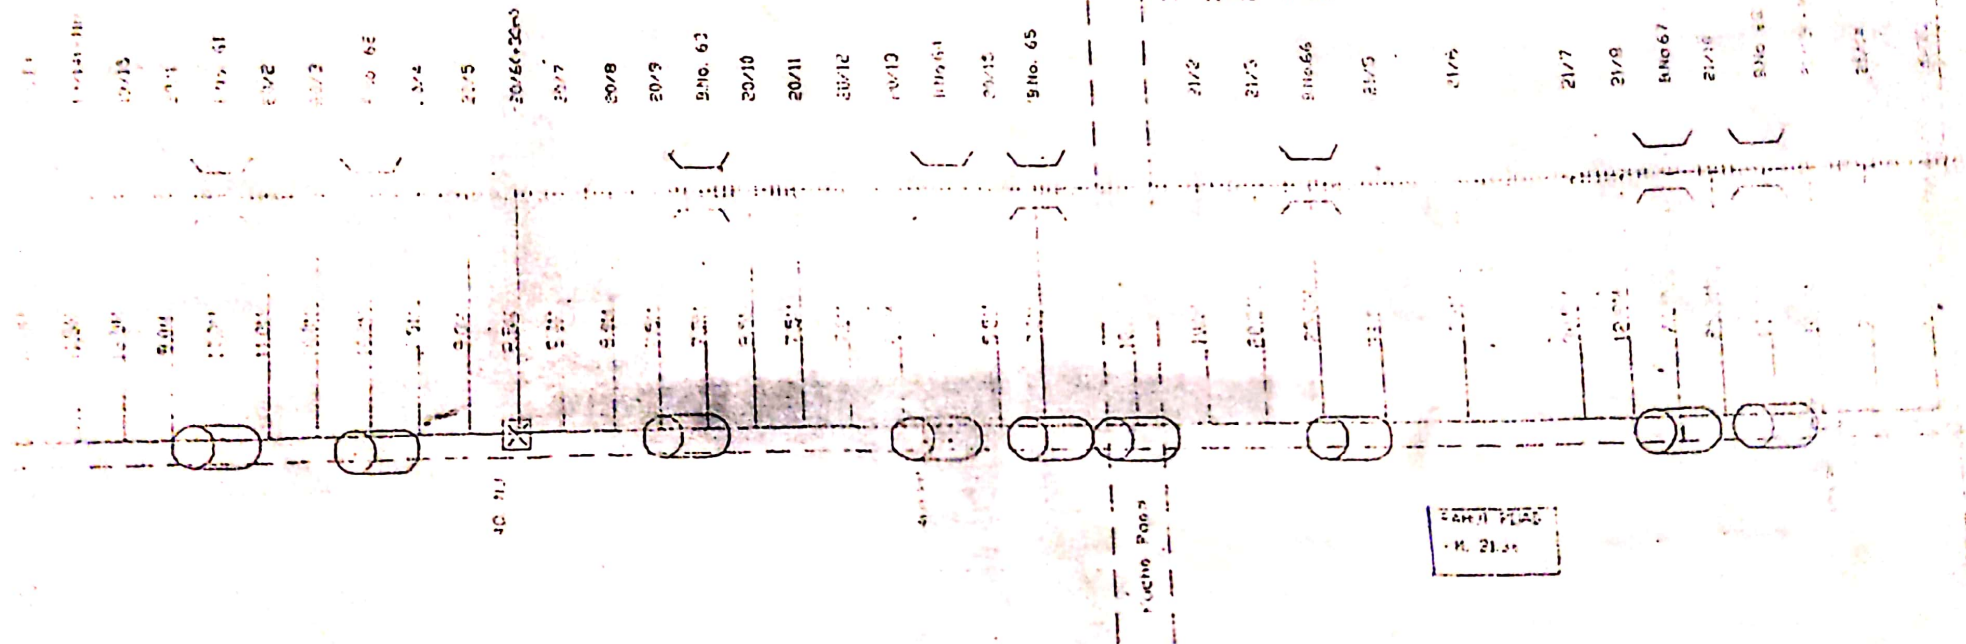

M/S SATYENDRA SINGH
CHARTS APPROVED
Satyendra


Proprietor

APPROVED	CHECKED		UFC CABLE ROUTE PLAN
		<i>Spencer</i>	
DATE	DATE	DATE	
BY	BY	BY	

1. LAYING OF 0.5" CABLE IN HDPE PIPE
2. LAYING OF 4 QUAD CABLE SHOWN
3. LAYING OF 10 20 PAIR-PIE SHOWN
4. QUAD CABLE JOINT SHOWN
5. DFC JOINT SHOWN
6. D.1. PIPE AT BRIDGE
7. R.C.C. PIPE AT BRIDGE & LIVE GATE
8. D.1. PIPE ON BRIDGE

~~2) $24/9, = 1 \times 25M$~~

KM. 21/15 TO 24/14

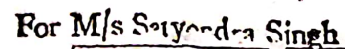


Proprietor

LEGEND

1. LAYING OF OFC CABLE IN HDPE PIPE
2. LAYING OF 4 QUARD CABLE SHOWN
3. LAYING OF 10/20 PAIR-PIPE SHOWN
4. QUARD CABLE JOINT SHOWN
5. OFC JOINT SHOWN
6. G.I. PIPE AT BRIDGE
7. R.C.C PIPE AT BRIDGE & L/C GATE
8. G.I. PIPE ON BRIDGE

DRG No. 10475

Section 1 BEHS. TO NLD.
KM.29/3 TO 31/2

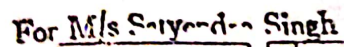

M/S SATYENDRA SINGH	
CHIEF	APPROVED
Satyendra	


Proprietor

CABLE	APPROVED	CHIEF		DFC CABLE ROUTE PLAN
	Director DYESTIC CENTER	JOSE VANDER	SEATTLE IND	

1. LAYING OF OFC CABLE IN HDPE PIPE
2. LAYING OF 4 GUARD CABLE SHOWN
3. LAYING OF 10/20 PAIR-PIE SHOWN
4. GUARD CABLE JOINING SHOWN
5. OFC JOINT SHOWN
6. G.I. PIPE AT BRIDGE
7. R.C.C PIPE AT BRIDGE & L.V. GATE
8. G.I. PIPE ON BRIDGE

Section : BEHS. TO NLD.

KM.31/2 TO 34/1

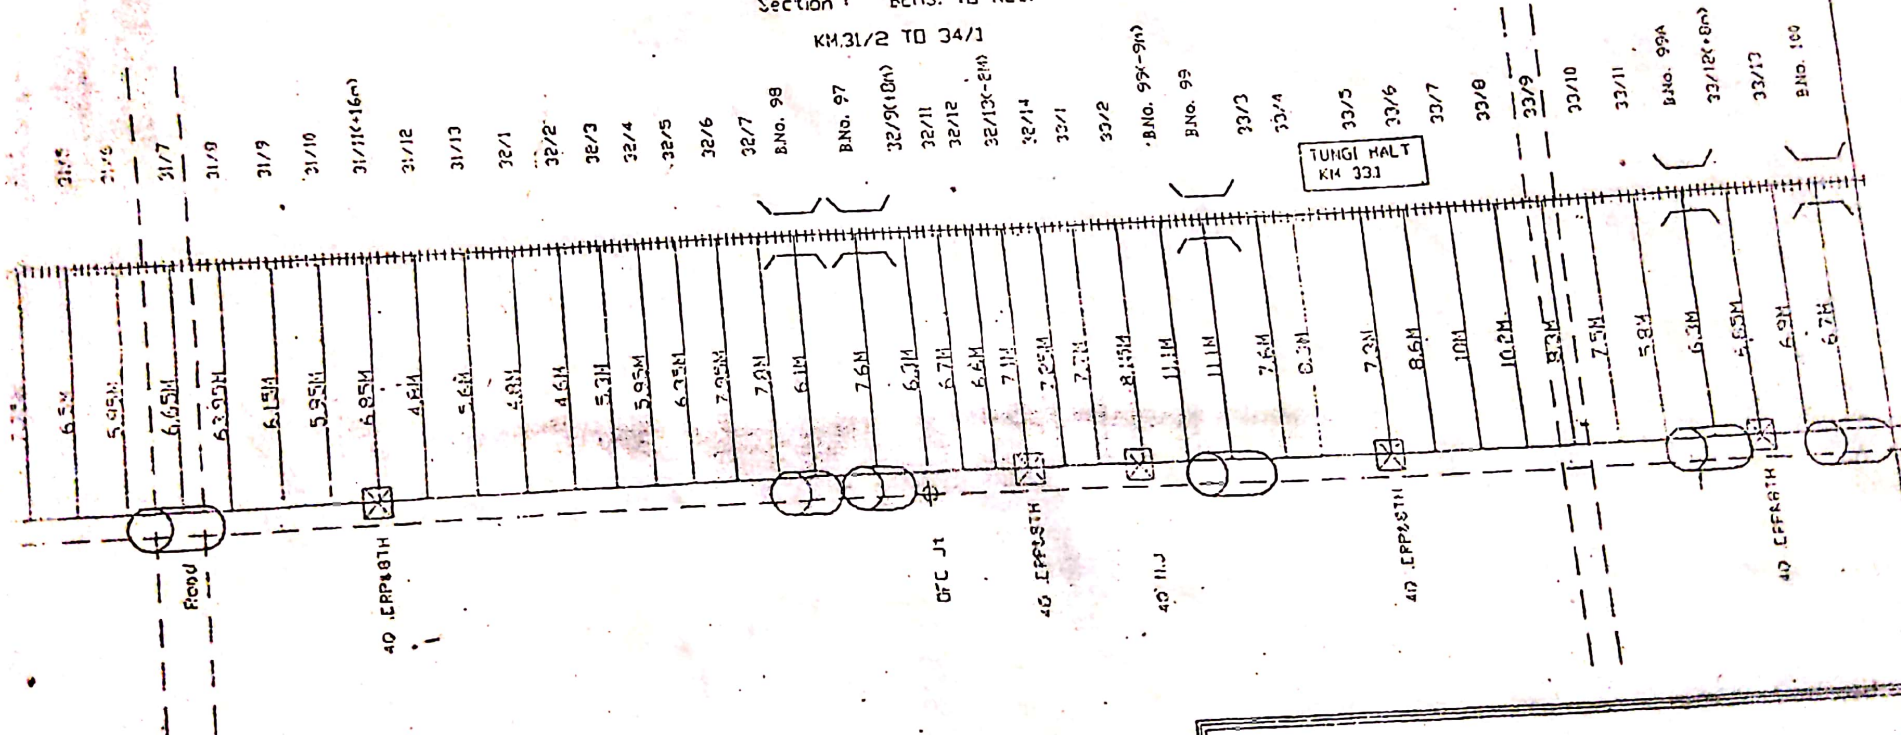

H/S SATYENDRA SINGH	
CHECKED	APPROVED
Satyendra	

Proprietor

DATE	APPROVED		CHECKED	OFC CABLE ROUTE PLAN
	PROJECT CONTR	DATE (CONTR)	DATE SIGNED	

LEGEND

1. LAYING OF OFC CABLE IN HDPE PIPE
2. LAYING OF 4 QUARD CABLE SHOWN
3. LAYING OF 10/20 PAIR-PIPE SHOWN
4. QUARD CABLE JOINT SHOWN
5. OFC JOINT SHOWN
6. G.I. PIPE AT BRIDGE
7. R.C.C PIPE AT BRIDGE & L/C GATE
8. G.I. PIPE ON BRIDGE




Page 10 of 10

BAKHTIARPUR TO RAJGIR SECTION

Section: BENS TO N.D.

km. 34/1 TO 36/1

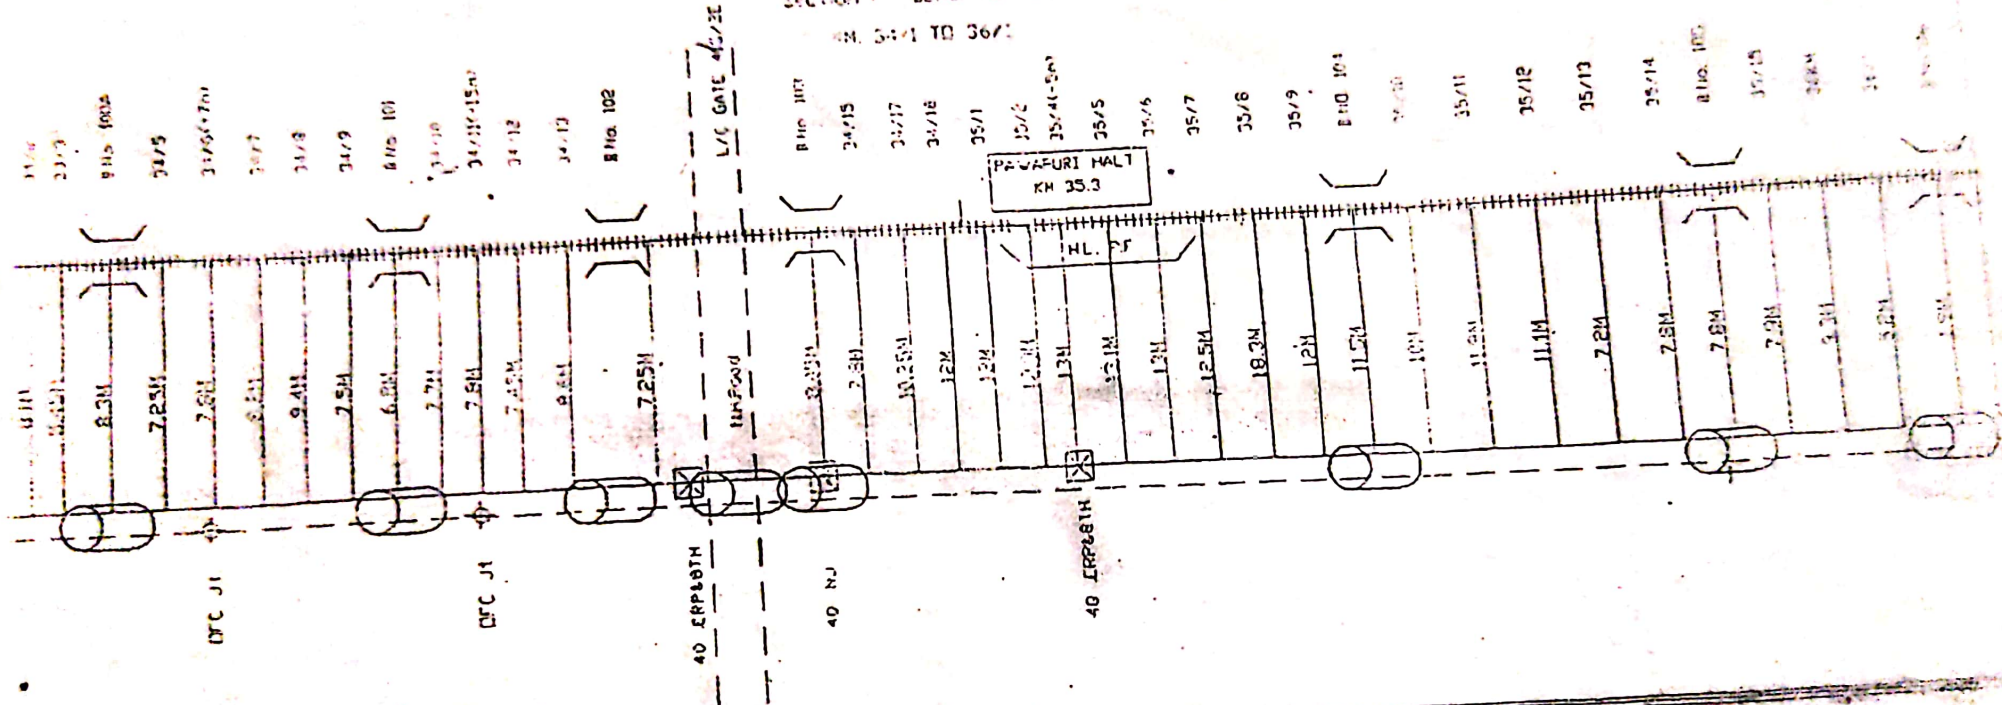

For M/s S. Singh & Singh

M/S. SATYENDRA SINGH
OWNER / APPROVED
Satendra

Proprietor

APPROVED	CHECKED	D.F.C. CABLE ROUTE PLAN
DISTRICT 10/1/1987	DISTRICT 10/1/1987	ST/1/1/1987

LEGEND

1. LAYING OF D.F.C. CABLE IN HOPE PIPE
2. LAYING OF 4 GUARD CABLE SHOWN
3. LAYING OF 10/20 PAIR-PIPE SHOWN
4. 4 GUARD CABLE JOINT SHOWN
5. D.F.C. JOINT SHOWN
6. G.I. PIPE AT BRIDGE
7. R.C.C. PIPE AT BRIDGE & L/G GATE
8. G.I. PIPE ON BRIDGE



OFC Joint BR No = 107, RGD end

i) 37/3, -12.5M X 18.5M


ii) 37/3, -11.5M X 0M

iii) 37/3, -19.5M X 0M

BAKHTIARPUR TO RAJGIR Section

Section: BHS. TO NLD.

KM. 36/1 TO 38/7

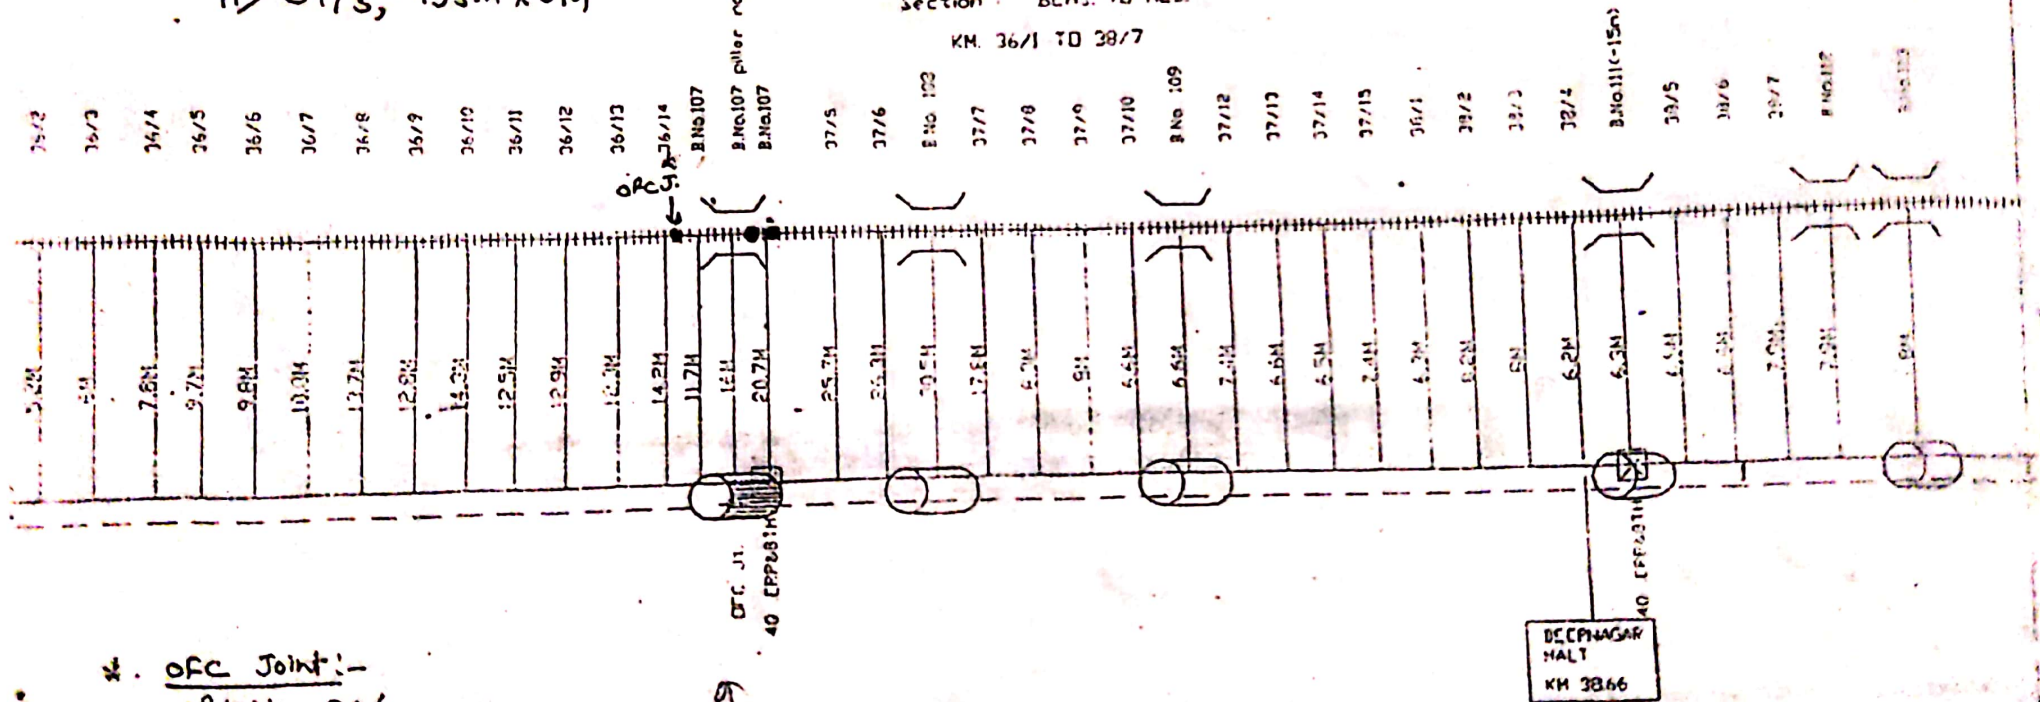

* OFC Joint:-

Pole No = 36/14, +51M X 13M

For M/s Sanyam Singh

M/s SATYAM SINGH
CHECKED
Sanyam Singh
Proprietor

APPROVED	CHECKED	OFC CABLE ROUTE PLAN

LEGEND


- 1. LAYING OF OFC CABLE IN HDPE PIPE
- 2. LAYING OF 4 QUARD CABLE SHOWN
- 3. LAYING OF 10/20 PAIR-PIE SHOWN
- 4. 4 QUARD CABLE JOINT SHOWN
- 5. OFC JOINT SHOWN
- 6. 60.1 PIPE AT BRIDGE
- 7. 78.00 PIPE AT BRIDGE & L/C GATE
- 8. 80.1 PIPE ON BRIDGE



BAKHTIARPUR TO RAJGIR Section

Section : BEHS. TO NLD.

KM. 38/7 TO 40/11

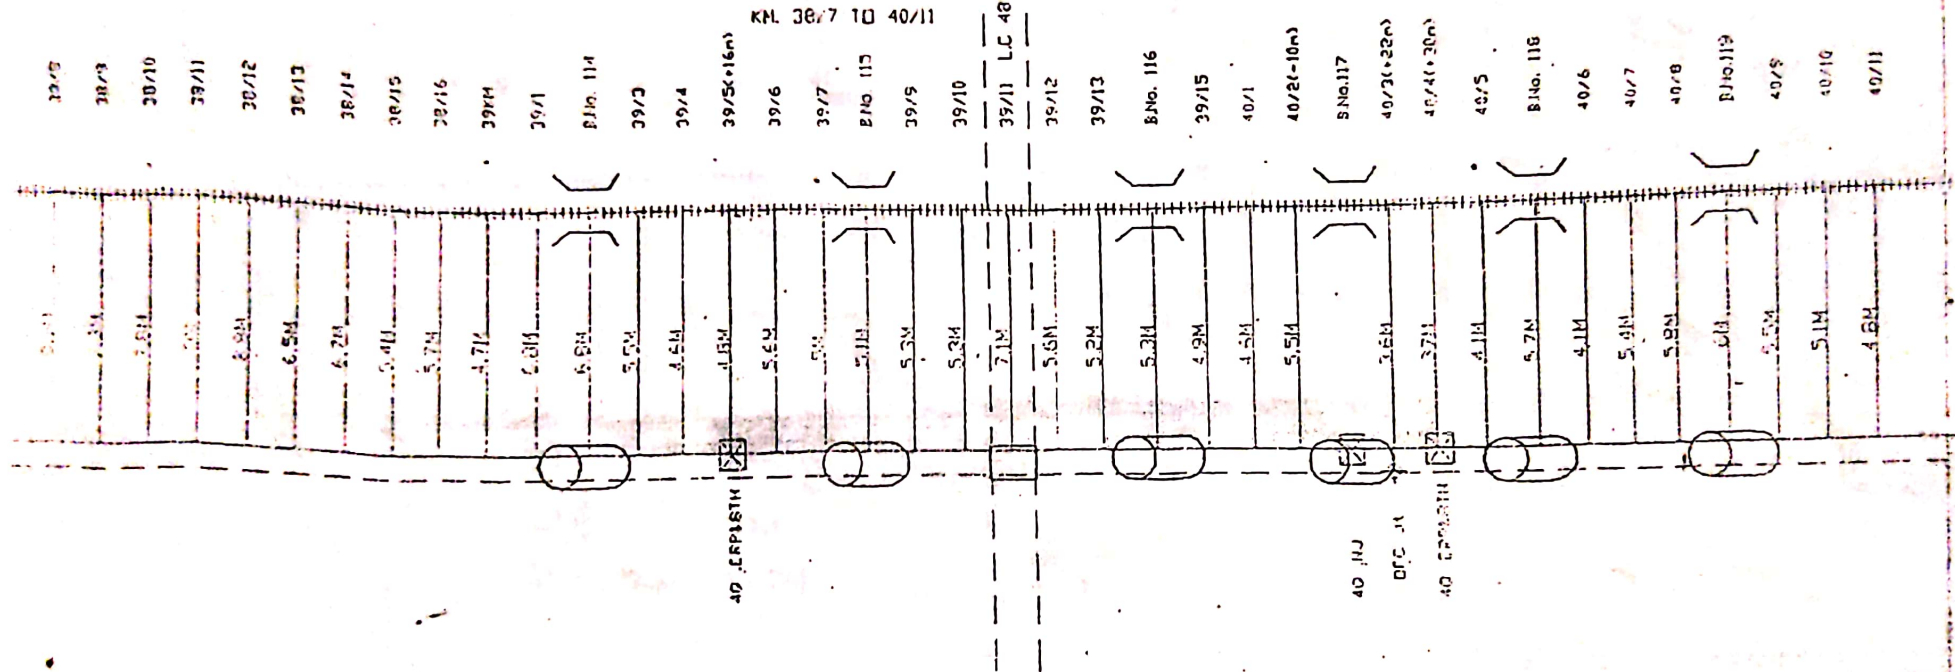

For M/s Sanyasir Singh

M/S SATYENDRA SINGH
OWNER
APPROVED
Sanyasir Singh

Proprietor

APPROVED	CHIEF	DATE
DATE	DATE	DATE
10/10/11	10/10/11	10/10/11

DPC
CABLE
ROUTE
PLAN

LEGEND

1. LAYING OF DPC CABLE IN HDPE PIPE
2. LAYING OF 4 QUARD CABLE SHOWN
3. LAYING OF 10/20 PAIR-PIE SHOWN
4. QUARD CABLE JOINT SHOWN
5. DPC JOINT SHOWN
6. G.I. PIPE AT BRIDGE
7. R.C.C PIPE AT BRIDGE & L/C GATE
8. G.I. PIPE ON BRIDGE




BAKHTIARPUR TO RAJGIR Section

Section BEHS. TO NLD.

KM. 40/11 TO 43/2

HL. FF.

NLD STA. ASM

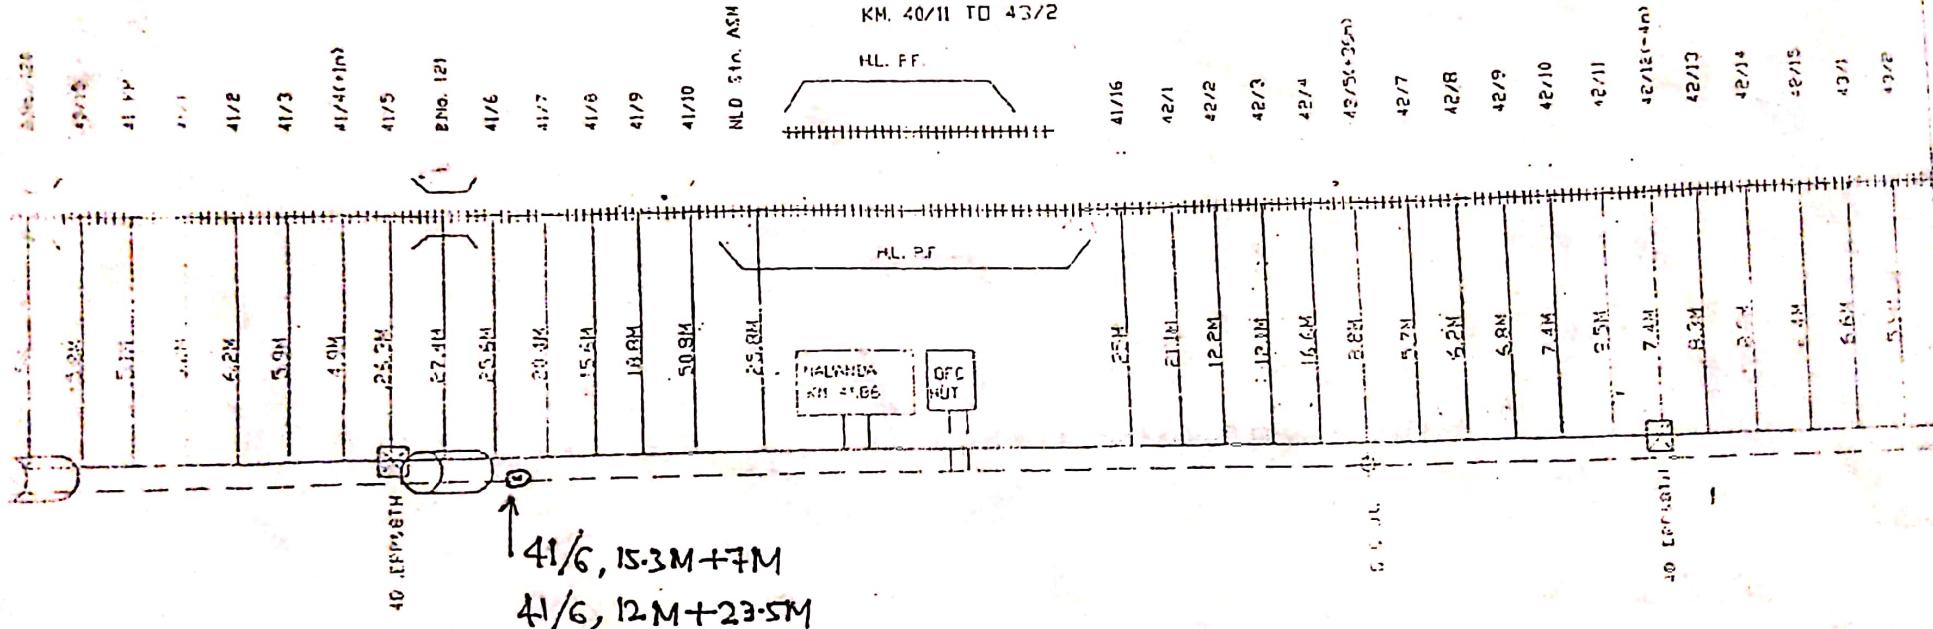

For M/s Sanyard Singh

M/S SANYARD SINGH	
CHECKED	APPROVED
<i>Sanyard Singh</i>	

Proprietor


APPROVED		CHECKED
DESIGN	DESIGN	SCALE
DATE	DATE	DATE

LEGEND

1. LAYING OF OFC CABLE IN HDPE PIPE
2. LAYING OF 4 GUARD CABLE SHOWN
3. LAYING OF 10/20 PAIR-PIE SHOWN
4. GUARD CABLE JOINT SHOWN
5. OFC JOINT SHOWN
6. G.I. PIPE AT BRIDGE
7. R.C.C. PIPE AT BRIDGE & L/C GATE
8. G.I. PIPE ON BRIDGE



KM. 43/2 TO 45/8

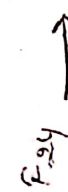

M/S SATVENDRA SINGH	
CHECKED	APPROVED
Satyendra	


APPROVED	CHECKED		DPC CABLE ROUTE PLAN
		<i>[Signature]</i>	
BY SITE TECHNICIAN	DATE (DD/MM/YY)	SERIAL NO.	

1. LAYING OF DFC CABLE IN HDPE PIPE-
2. LAYING OF 4 QUARD CABLE SHOWN
3. LAYING OF 10/20 PAIR-PIPE SHOWN
4. QUARD CABLE JOINT SHOWN
5. DFC JOINT SHOWN
6. G.I. PIPE AT BRIDGE
7. R.C.C PIPE AT BRIDGE & L/C GATE
8. G.I. PIPE ON BRIDGE

ofc to close off set
 1) 58C, 5-6M-2.1M
 2) 58C, 5-6M-5.1M

BAKHTIARPUR TO RAJGIR Section

Section : NLD. TO RGD.
 KM. 45/8 TO 48/7

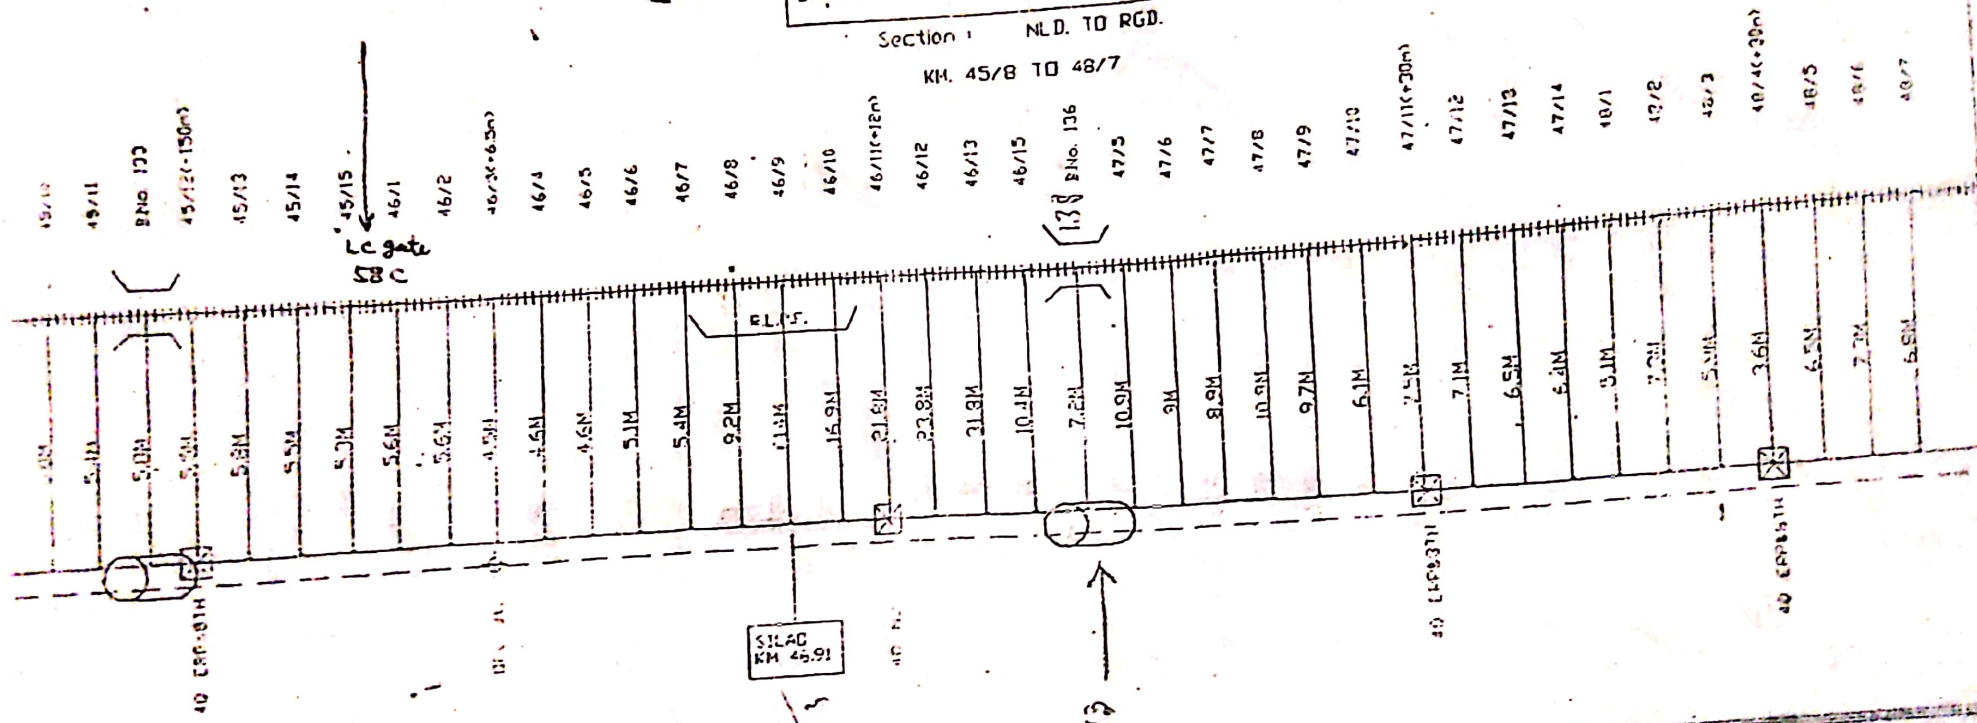

Ag, F13

For M/s Satyendra Singh
 Satyendra Singh
 Proprietor

APPROVED	CHECKED		OFC CABLE ROUTE PLAN
	DATE (DD/MM)	DATE (DD/MM)	


LEGEND

- 1. LAYING OF OFC CABLE IN HOPE PIPE
- 2. LAYING OF 4 GUARD CABLE SHOWN
- 3. LAYING OF 10/20 PAIR-PIE SHOWN
- 4. 4 GUARD CABLE JOINT SHOWN
- 5. OFC JOINT SHOWN
- 6. G.I. PIPE AT BRIDGE
- 7. R.C.C. PIPE AT BRIDGE & L/C GATE
- 8. G.I. PIPE ON BRIDGE

BAKHTIARPUR TO RAJGIR Section

Section NLD. TO RGD.

KM. 48/7 TO 51/3

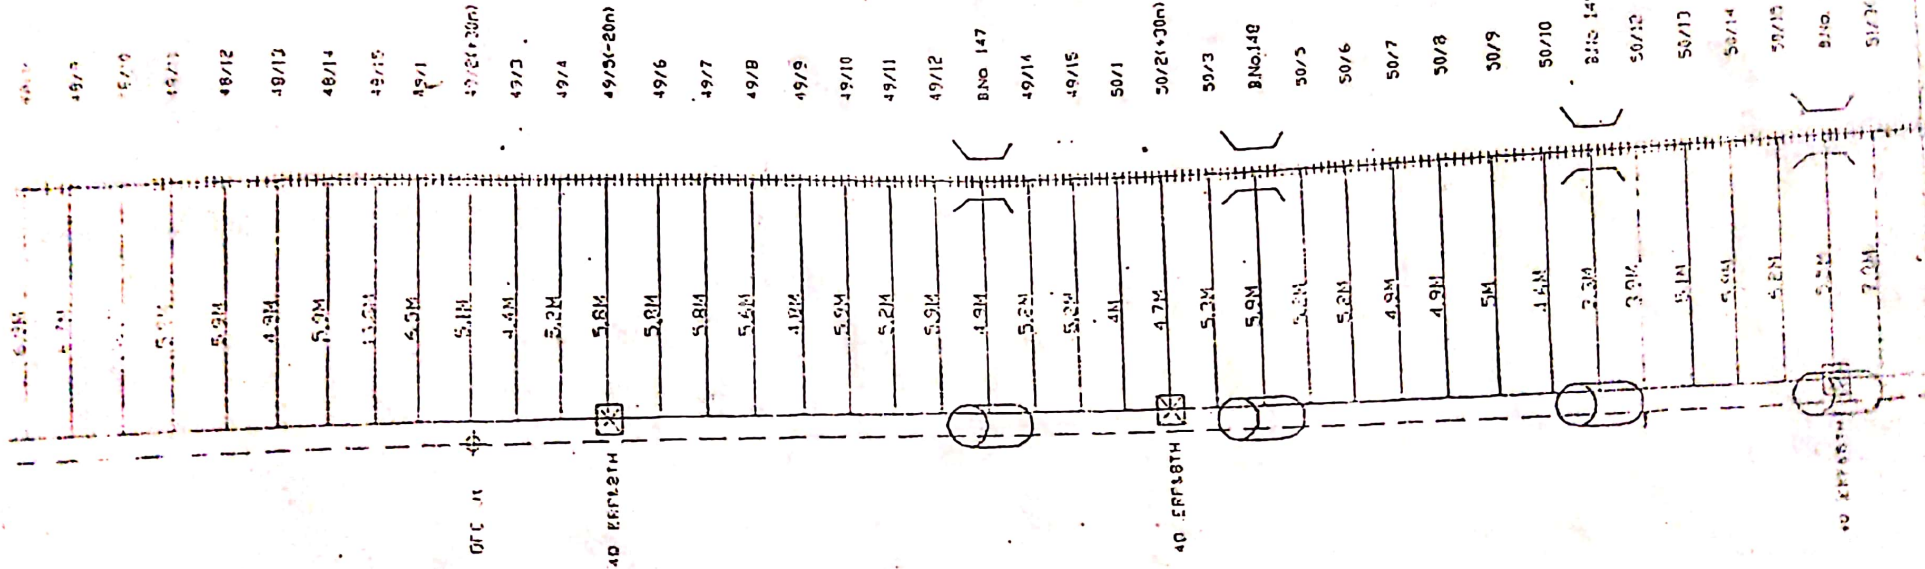

For M/s. Sanyasir Singh

APPROVED
CHECKED
Sanyasir Singh

Proprietor

APPROVED	CHECKED	DPC CABLE ROUTE PLAN
BYESTE (C/DNR)	BYESTE (C/DNR)	SECTAN BAR


LEGEND

1. LAYING OF DFC CABLE IN HDPE PIPE
2. LAYING OF 4 QUARD CABLE SHOWN
3. LAYING OF 10/20 PAIR-PIJE SHOWN
4. QUARD CABLE JOINT SHOWN
5. DFC JOINT SHOWN
6. G.I. PIPE AT BRIDGE
7. R.C.C. PIPE AT BRIDGE & LAKE GATE
8. G.I. PIPE ON BRIDGE

BAKHTIARPUR TO RAJGIR Section

Section : HLD. TO RGD.

KM. 48/7 TO 51/3

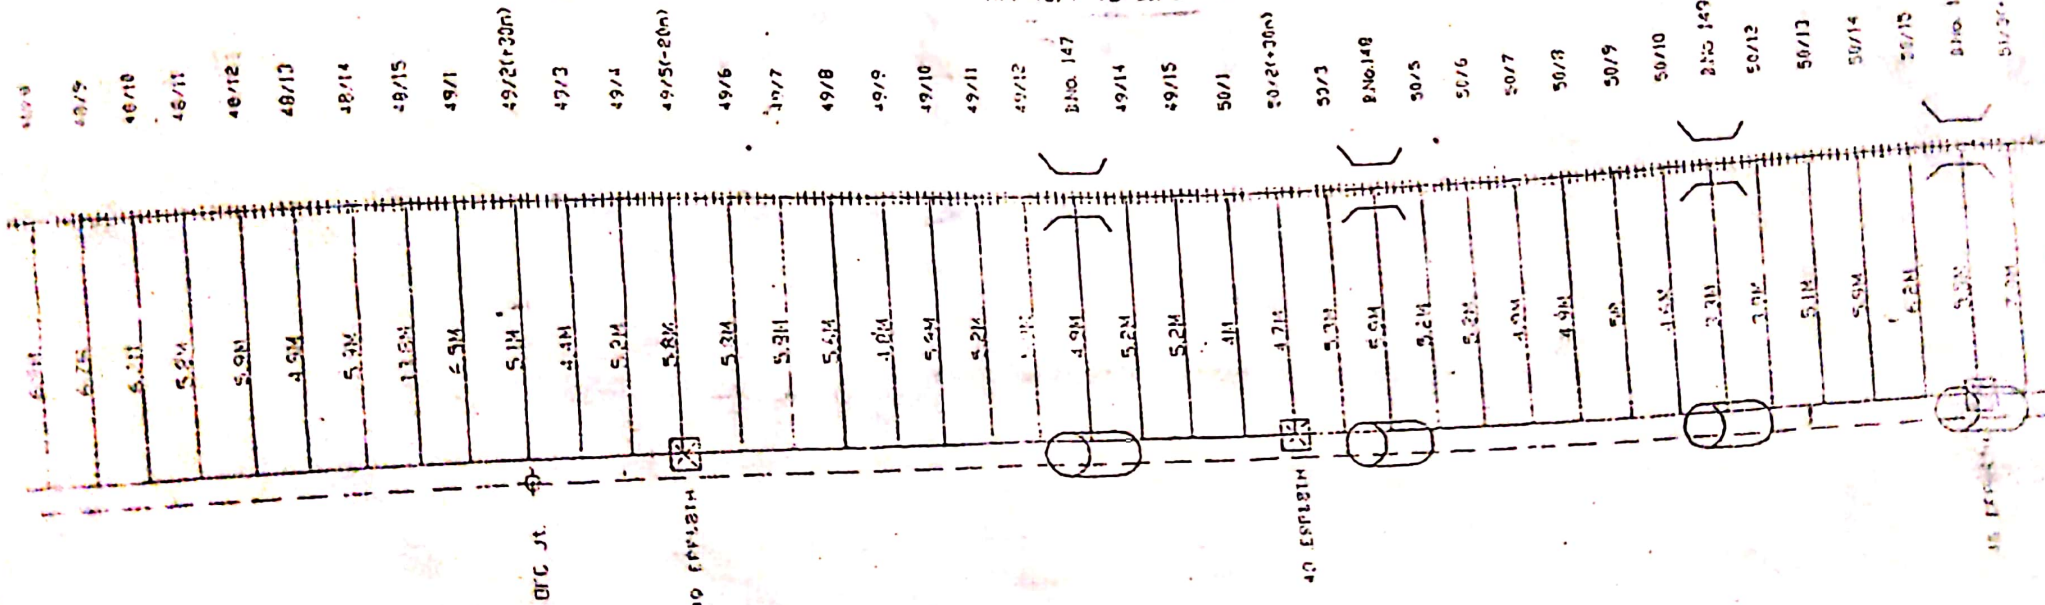

For M/s Satyendra Singh

M/S SATYENDRA SINGH
CHECKED
APPROVED
<i>Satendra</i>

Proprietor

APPROVED	CHECKED	D/C CABLE ROUTE PLAN
DYESTIE (CONTR)	ESTIE (CONTR)	SECT/AN

LEGEND

- 1. LAYING OF DFC CABLE IN HDPE PIPE
- 2. LAYING OF 4 GUARD CABLE SHOWN
- 3. LAYING OF 10/20 PAIR-PILE SHOWN
- 4. 4 GUARD CABLE JOINT SHOWN
- 5. DFC JOINT SHOWN
- 6. G.I. PIPE AT BRIDGE
- 7. R.C.C. PIPE AT BRIDGE & L.V. GATE
- 8. G.I. PIPE ON BRIDGE



For M/s S. V. Singh

APPROVED	DATE	BY
APPROVED	DATE	BY
APPROVED	DATE	BY

Proprietor

PLAN	DATE	BY
PLAN	DATE	BY
PLAN	DATE	BY

LEGEND

LAYING OF OTC CABLE IN HOPE PIPE

LAYING OF A GUARD CABLE TOWARD

LAYING OF 10/20 PAIR-PIEC SHOWN

A GUARD CABLE JOINT SHOWN

S.O.P.C. JOINT SHOWN

6.00 PAIR AT BRIDGE

7.00 PAIR AT BRIDGE

8.00 PAIR AT BRIDGE

