
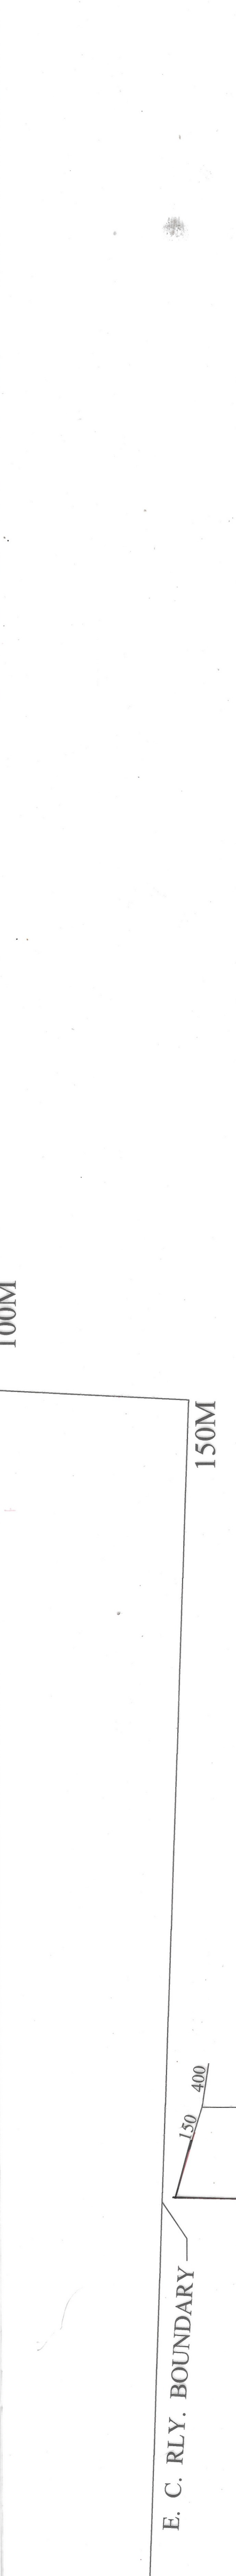


.B. ITEM NO. - 54 OF 2015-2016
THIS DRG. IS BASED ON CE'S DRG. NO. - Y-05 - 2013

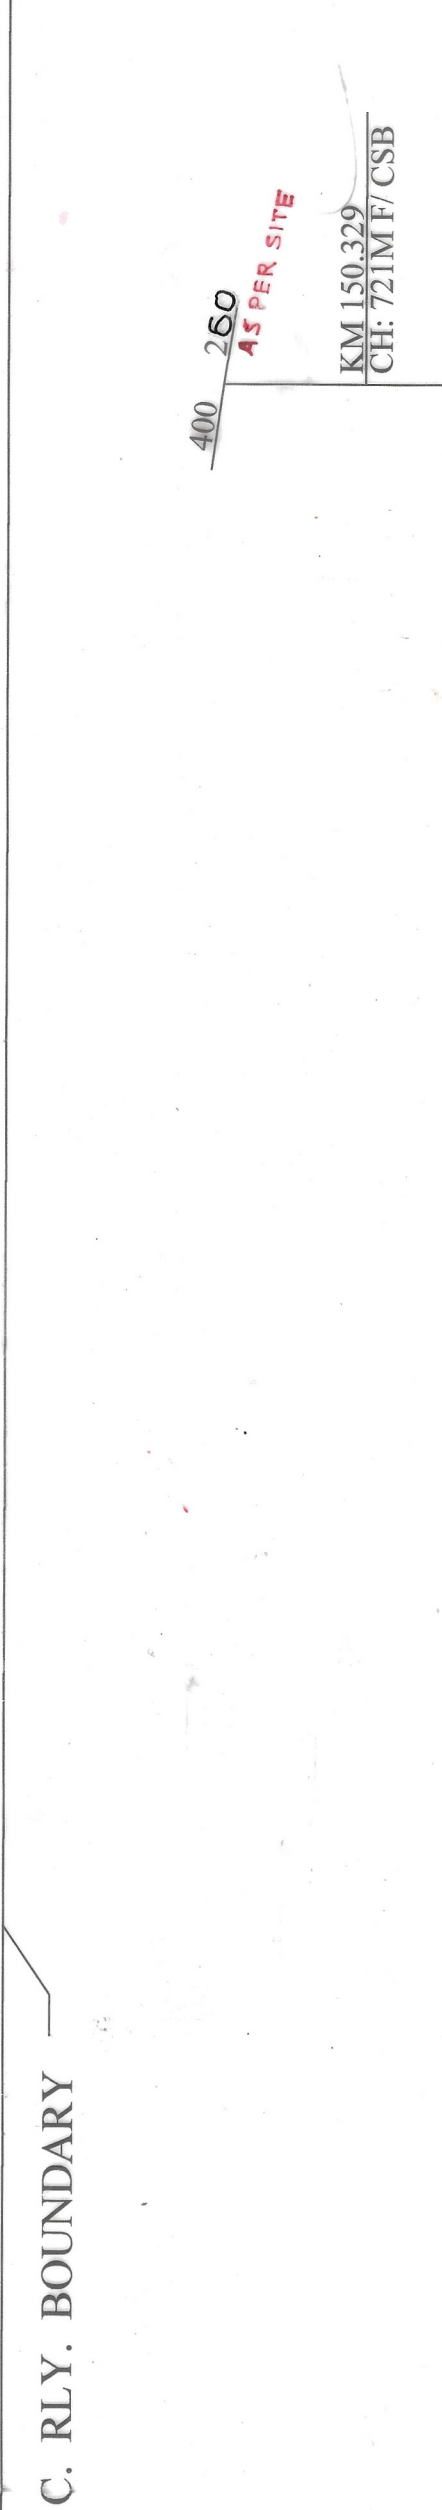

1. EXISTING WORKS SHOWN IN BLACK
2. DISMANTLING WORKS SHOWN IN BLACK DOTTED
3. PROPOSED WORKS SHOWN IN RED

S.N.	LC NO.	KM	M/UM	BLOCK SECTION	TELEPHONE CONNECTED WITH STATION
1.	NIL	—	—	MWF - PPKD	—

SL. NO.	LC. NO.	KM	M/LM	BLOCK SECTION	TELEPHONE CONNECTED WITH EN
1.	NIL	—	—	MWF-KARD	—

DETAILS OF LC'S IN BLOCK SECTION