
AUTHORITY OF WORKS
DM (MUZAFFARPUR) LETTER NO.200 DATED 31.01.2020
PID No.03.05.18.19.1.54.002


LEGEND

1. EXISTING WORK SHOWN THUS ——————
2. PROPOSED WORK SHOWN THUS ——————
3. DEMOLITIONS WORK SHOWN THUS ——————

NOTES:-

1. ALL DIMENSIONS ARE IN METERS EXCEPT OTHERWISE MENTIONED
2. ALL FTS & TPCS SHOWN IN THE PLAN.
3. IT IS CERTIFIED THAT THERE IS NO CHANGE IN GRADES IN NOW OF POINTS AND T-POCS.
4. THIS DRAWING SUPERSEDES GP TO CE DRG NO.T-90-00/2017&GT-11
5. THIS DRAWING IS ON THE BASIS OF SITE SURVEY AND OLE APPROVED DRAWING.
6. THIS DRAWING SUPERSEDES CE DRG NO.T-90-00/2017&GT-12
7. UPGRADATION OF LC IS DONE AFTER SANCTIONING OF WORK
8. THE GRADIENT OF ROAD NO SLOPE TAKING OFF FROM TRANSITION PORTION OF LEVEL CURVE.
9.DETAILS OF CLOSURE OF 12x:-
APPROACH TO BE CONSTRUCTED WITH 12 NO.1:5 'RL' ON AT KM 41/5-5 AND 41/7-8 BETWEEN TUR-RD.
APPROACH TO BE CONSTRUCTED WITH 12 NO.1:5 'RL' ON AT KM 39/1-2 AND 39/3-4 BETWEEN TUR-KHI.
APPROACH TO BE CONSTRUCTED WITH 12 NO.1:4 'RL' ON AT KM 39/1-2 BETWEEN TUR-KHI.

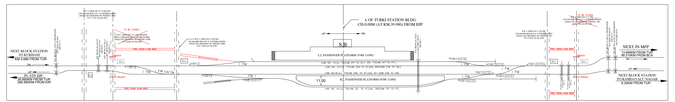

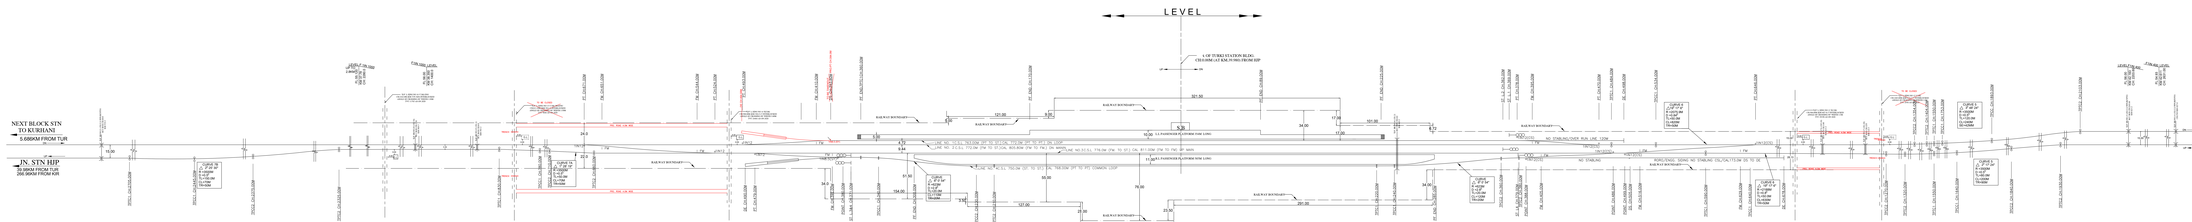

DETAIL OF L-XING BETWEEN TURKI AND KURHANI :-

S.NO.	L.C. NO.	CLASS	M/U.M	LOCATION	BLOCK SECTION	TELE CONNECTION	T.V.U. AS ON 1/1/2020	E/T	INTERLOCKED
1.	14	B2	M	39/4-5	TUR-KHI	TUR	24446	T	YES
2.	~~15~~	~~C~~	~~M~~	~~39/1-2~~	~~" "~~	~~TUR~~	~~3048~~	~~T~~	~~YES~~
3.	16	C	M	37/9-38/0	" "	TUR	11765	E	NO
4.	17	C	M	34/2-3	" "	KHI	8398	T	YES

~~TO BE CLOSED~~

THERE IS NO OTHER L-XING OR BRIDGE OR CULVERT WITHIN 2BOM FROM EXISTING FACING POINT.

DETAIL OF BRIDGE BETWEEN TURKI AND KURHANI :-

S.NO.	BR.NO.	KM	SPAN	TYPE
1.	19	39/1-2	1x1.2	BOX
2.	20	38/4-5	1x2.54	BOX
3.	21	37/1-2	5x12.2	RVTPG
4.	22	36/3-4	4x12.2	RVTPG

DETAIL OF L-XING BETWEEN TUR AND RD :-

S.NO.	L.C. NO.	CLASS	M/U.M	LOCATION	BLOCK SECTION	TELE CONNECTION	T.V.U. AS ON 1/1/2020	E/T	INTERLOCKED
1.	13	B1	M	40/7-8	TUR-RD	TUR	29198	T	YES
2.	~~12~~	~~C~~	~~M~~	~~41/2-3~~	~~TUR-RD~~	~~TUR~~	~~2958~~	~~E~~	~~NO~~
3.	11	B2	M	43/3-4	TUR-RD	TUR	21580	E	YES
4.	8	C	M	46/2-3	TUR-RD	RD	18720	E	YES
5.	7	SPL	M	47/2-3	TUR-RD	RD	225589	T	YES

~~TO BE CLOSED~~

THERE IS NO OTHER L-XING OR BRIDGE OR CULVERT WITHIN 2BOM FROM EXISTING FACING POINT.

DETAIL OF BRIDGE BETWEEN TUR AND RD:-

S.NO.	BR.NO.	KM	SPAN	TYPE
1.	18	40/2-3	1x0.5	EWE
2.	17A	41/1-2	1x5.1	BOX
3.	17	41/2-3	1x1.2	PIPE
4.	15	42/1-2	4x12.2	WPG
5.	14	42/7-8	1x12.2	WPG
6.	13	43/5-6	1x1.2	PIPE

CPDE	BRIJESH KUMAR SINGH	Date: 2022.02.24 17:52:44 +05'30'
CTPM	AMBASTHA	Digitally signed by AMBASTHA Date: 2022.02.24 18:55:09 +05'30'
DESIGN.	OFFICER's SIGN.	
DRM	NILMANI	Digitally signed by NILMANI Date: 2022.02.25 10:08:58 +05'30'
SR.DEN/C	SANJAY KUMAR SINGH	Digitally signed by SANJAY KUMAR SINGH Date: 2022.02.25 10:30:48 +05'30'
SR.DOM	RAJEEV RANJAN	Digitally signed by RAJEEV RANJAN Date: 2022.02.25 10:43:56 +05'30'
SR.DSTE	ABHISHEK KUMAR	Digitally signed by ABHISHEK KUMAR Date: 2022.02.25 10:51:56 +05'30'
SR.DEE/G	KUMAR PRAKASH NAVEEN	Digitally signed by KUMAR PRAKASH NAVEEN Date: 2022.02.25 10:58:36 +05'30'
SR.DEE/TRD	SANJAY KUMAR PASWAN	Digitally signed by SANJAY KUMAR PASWAN Date: 2022.02.25 11:05:08 +05'30'
SR.DEN/H	MANTU KUMAR	Digitally signed by MANTU KUMAR Date: 2022.02.25 11:12:26 +05'30'
SSE/INC/DRG	ANIL KUMAR RAI	Digitally signed by ANIL KUMAR RAI Date: 2022.02.25 11:19:46 +05'30'
SSE/DRG/SSE	KUNJ BIHARI PRASAD	Digitally signed by KUNJ BIHARI PRASAD Date: 2022.02.25 12:01:17 +05'30'
DESIGN.	OFFICER's SIGN.	

EAST CENTRAL RAILWAY

SONPUR DIVISION

TURKI STATION(TUR) द्वारा

PROPOSED YARD PLAN IN CONNECTION WITH CLOSURE OF LC NO.12 'C' (M) AT KM 41/2-3 AND LC NO.15 'C' (M) AT KM 39/1-2 AND PROVISION OF SAND HUMP.

C.E'S DRG.NO:- Y - 28 - 2022

BINOD KUMAR SINGH	DILIP KUMAR	DRM/ENGG./SSE/DRG.NO-7/1/2022	
SSE/W/MFP	ADEN/MFP	SCALE :- 1CM=1OM	