


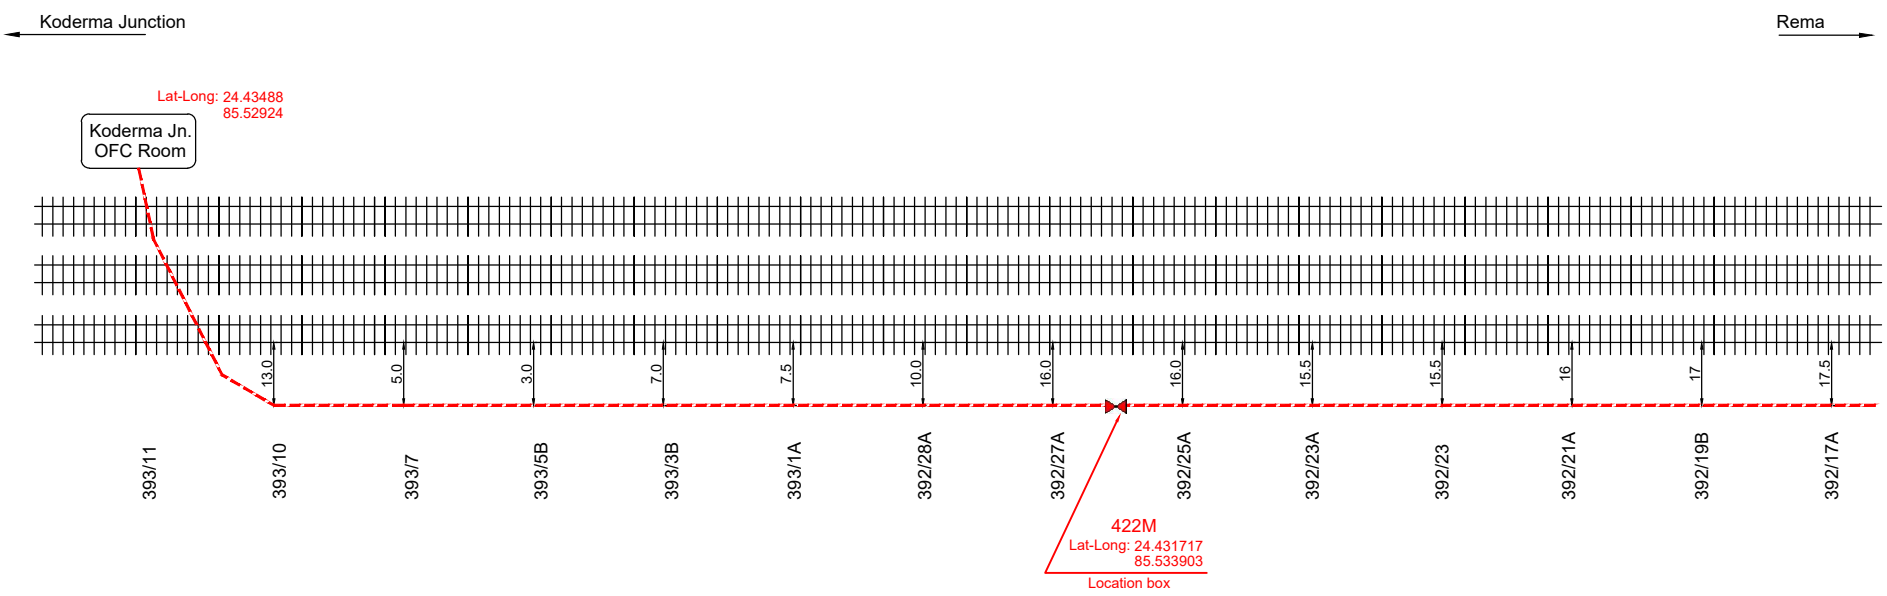

As Built Drawing For OFC & 6-Quad Cable Route
Section : - Koderma Junction To Rema Station
Sub. Section : - Koderma Junction To Koderma Town
Chainage : - 393/11 - 392/17A



LEGENDS:

- 6 Quad joint / Location Box Straight Joint
- OFC Joint
- DWC / GI
- Rly Track
- OFC & 6-Quad Cable
- Bridge/Culvert
- Kaccha/Pakka Road

GM	AGM/DGM	SR.MANAGER	PWI	SSE/ELECT	SSE/TD	SSE/SIG/M	
SSE/TELE/M	SR.DEE (TD/BB)	SR.DEE/G/BB	DEN (NE)	SR.DEN (CO)	ADRM	DRM	

RAILTEL CORPORATION OF INDIA LTD.
EASTERN REGION

PROJECT - Rectification of U/G OFC & 6 Quad copper cable
in KQR - Rema (55 km) Sec.of ECR
WO. NO. 2002110395,Dated 28.07.2021

PROJECT BY-
M/S U.K.TRADERS
10,LUXMANPUR ALLAHABAD ROAD SULTANPUR U.P
PIN CODE - 228001


SCALE
NTS

SHEET No.
01



As Built Drawing For OFC & 6-Quad Cable Route

Section : - Koderma Junction To Rema Station
Sub. Section : - Koderma Junction To Koderma Town
Chainage : - 392/17A - 392/1

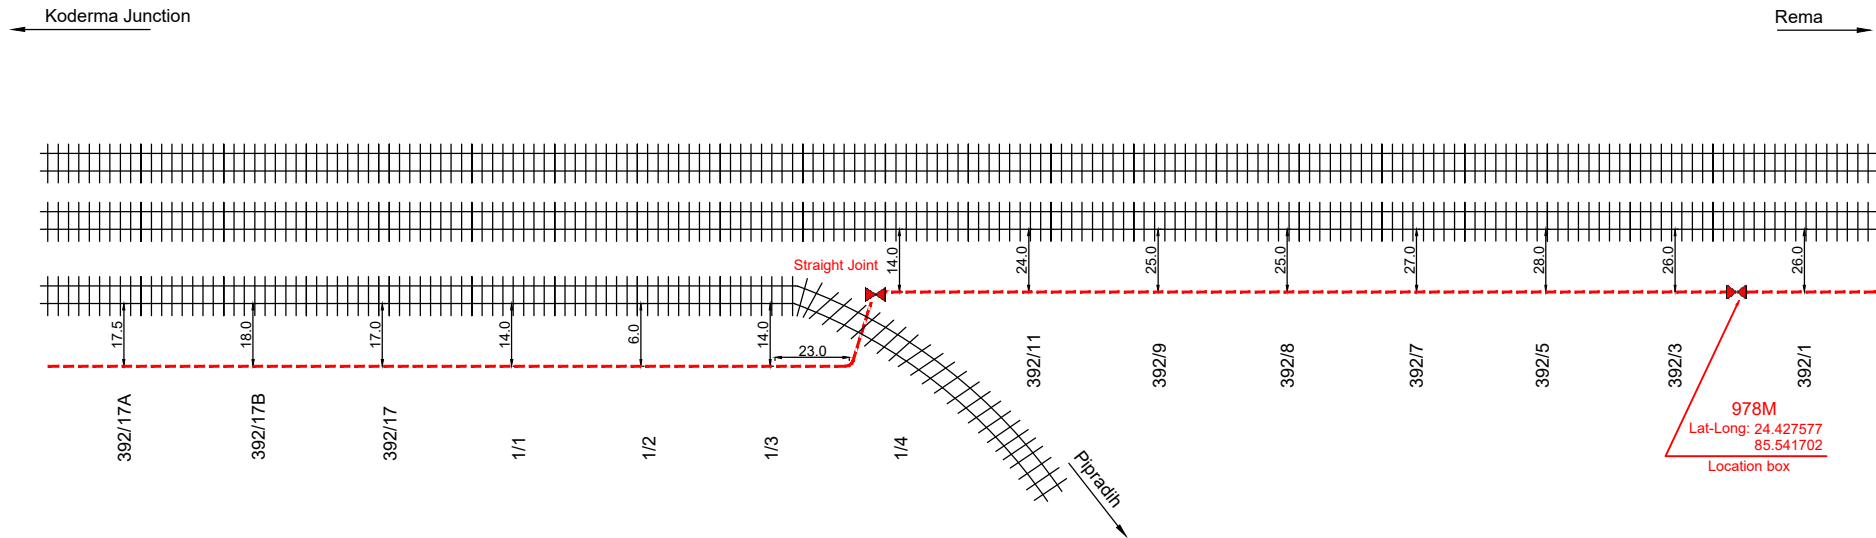

LEGENDS:

- 6 Quad joint / Location Box
- Straight Joint
- OFC Joint
- DWC / GI
- Rly Track
- OFC & 6-Quad Cable
- Bridge/Culvert
- Kaccha/Pakka Road

GM	AGM/DGM	SR.MANAGER	PWI	SSE/ELECT	SSE/TD	SSE/SIG/M	
SSE/TELE/M	SR.DEE (TD/BB)	SR.DEE/G/BB	DEN (NE)	SR.DEN (CO)	ADRM	DRM	

RAILTEL CORPORATION OF INDIA LTD.
EASTERN REGION

PROJECT - Rectification of U/G OFC & 6 Quad copper cable
in KQR - Rema (55 km) Sec. of ECR
WO. NO. 2002110395, Dated 28.07.2021



PROJECT BY-
M/S U.K. TRADERS
10, LUXMANPUR ALLAHABAD ROAD SULTANPUR U.P
PIN CODE - 228001

SCALE NTS SHEET No. 02



As Built Drawing For OFC & 6-Quad Cable Route

Section : - Koderma Junction To Rema Station
Sub. Section : - Koderma Junction To Koderma Town
Chainage : - 2/6 - 3/11

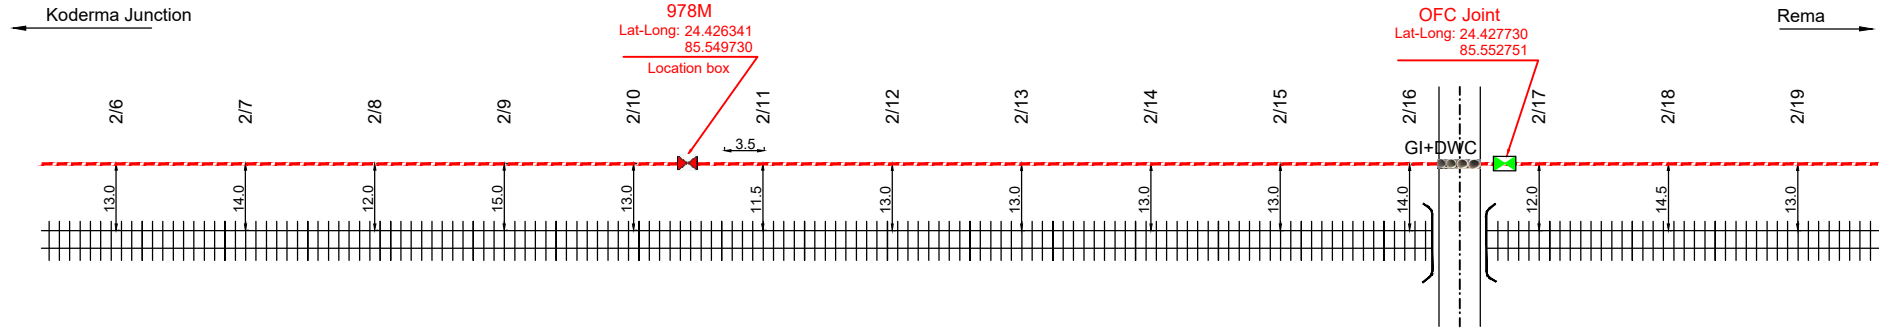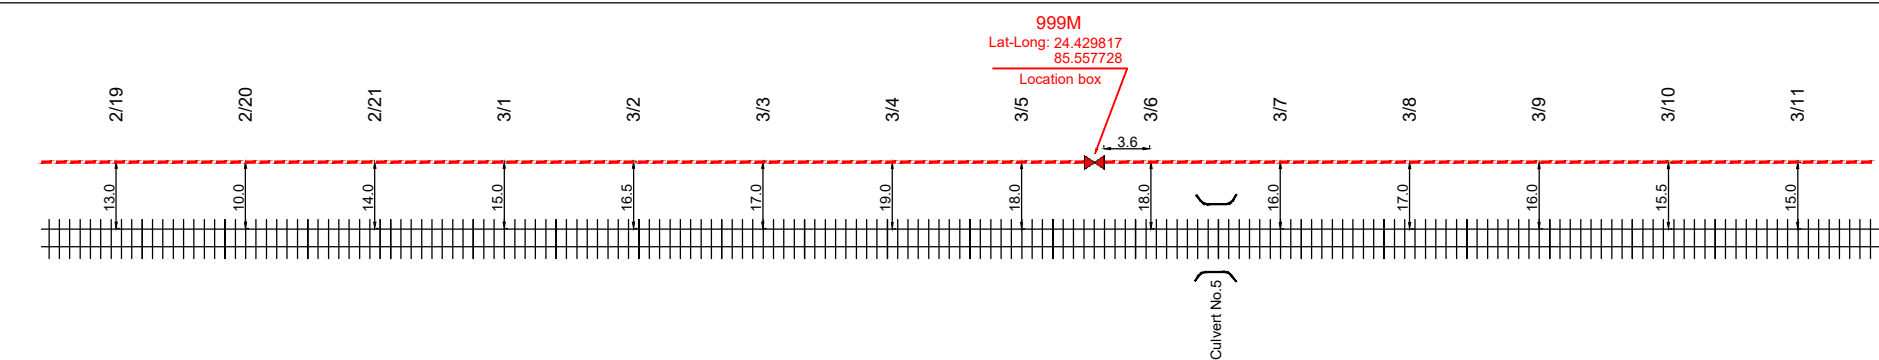

LEGENDS:

- 6 Quad joint / Location Box
- Straight Joint
- OFC Joint
- DWC / GI
- Rly Track
- OFC & 6-Quad Cable
- Bridge/Culvert
- Kaccha/Pakka Road

GM	AGM/DGM	SR.MANAGER	PWI	SSE/ELECT	SSE/TD	SSE/SIG/M	
SSE/TELE/M	SR.DEE (TD/BB)	SR.DEE/G/BB	DEN (NE)	SR.DEN (CO)	ADRM	DRM	

RAILTEL CORPORATION OF INDIA LTD.
EASTERN REGION

PROJECT - Rectification of U/G OFC & 6 Quad copper cable
in KQR - Rema (55 km) Sec.of ECR
WO. NO. 2002110395, Dated 28.07.2021

PROJECT BY-
M/S U.K.TRADERS
10,LUXMANPUR ALLAHABAD ROAD SULTANPUR U.P
PIN CODE - 228001


SCALE
NTS

SHEET No.
04



As Built Drawing For OFC & 6-Quad Cable Route

Section : - Koderma Junction To Rema Station
Sub. Section : - Koderma Junction To Koderma Town
Chainage : - 3/11 - 5/3

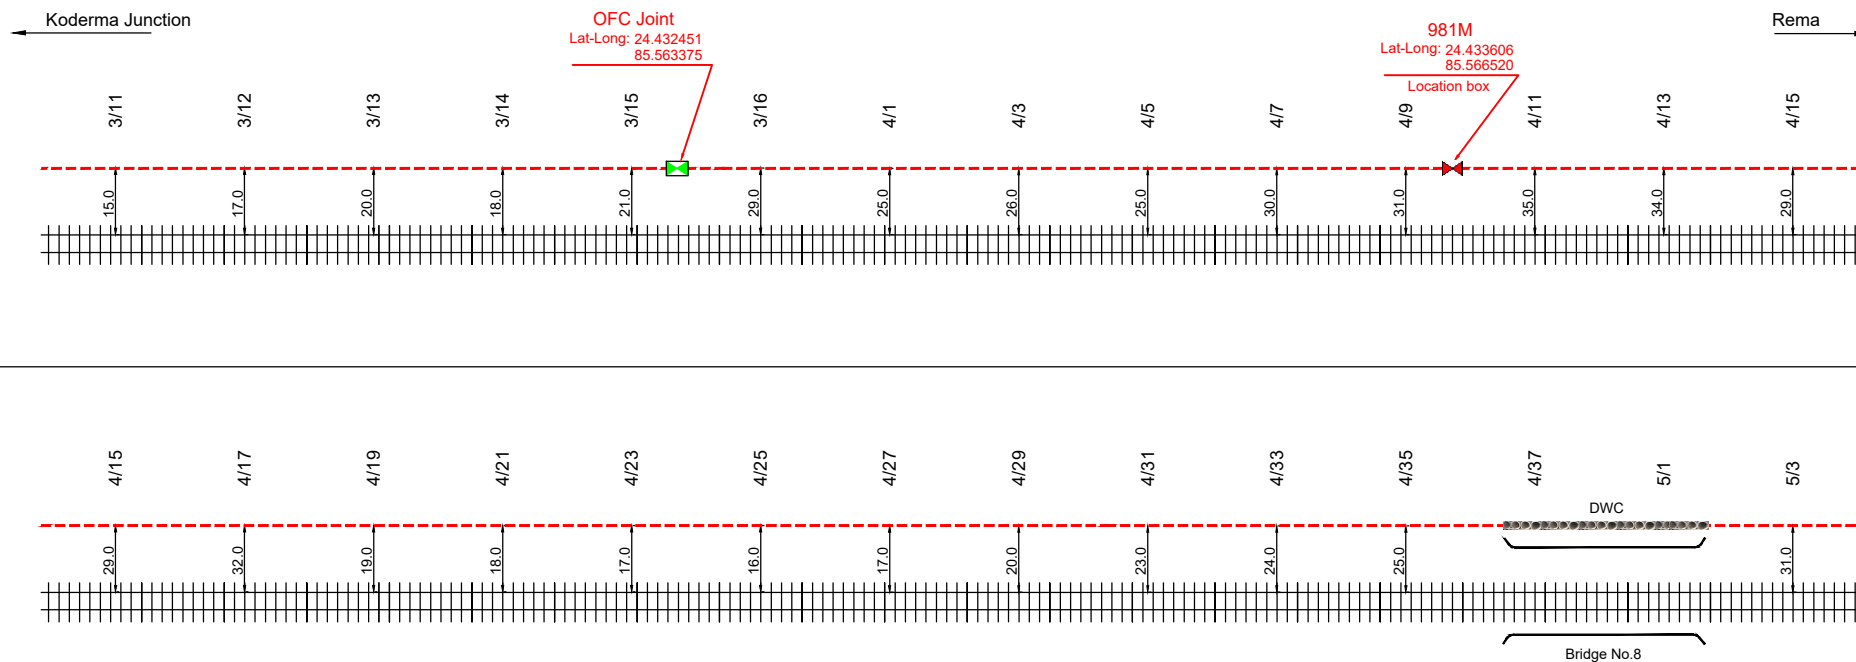

LEGENDS:

- 6 Quad joint / Location Box
- Straight Joint
- OFC Joint
- DWC / GI
- Rly Track
- OFC & 6-Quad Cable
- Bridge/Culvert
- Kaccha/Pakka Road

GM	AGM/DGM	SR.MANAGER	PWI	SSE/ELECT	SSE/TD	SSE/SIG/M
SSE/TELE/M	SR.DEE (TD/BB)	SR.DEE/G/BB	DEN (NE)	SR.DEN (CO)	ADRM	DRM

RAILTEL CORPORATION OF INDIA LTD.
EASTERN REGION

PROJECT - Rectification of U/G OFC & 6 Quad copper cable
in KQR - Rema (55 km) Sec. of ECR
WO. NO. 2002110395, Dated 28.07.2021

PROJECT BY-
M/S U.K. TRADERS
10, LUXMANPUR ALLAHABAD ROAD SULTANPUR U.P.
PIN CODE - 228001



SCALE
NTS

SHEET No.
05



As Built Drawing For OFC & 6-Quad Cable Route

Section : - Koderma Junction To Rema Station
Sub. Section : - Koderma Junction To Koderma Town
Chainage : - 5/3 - 6/21

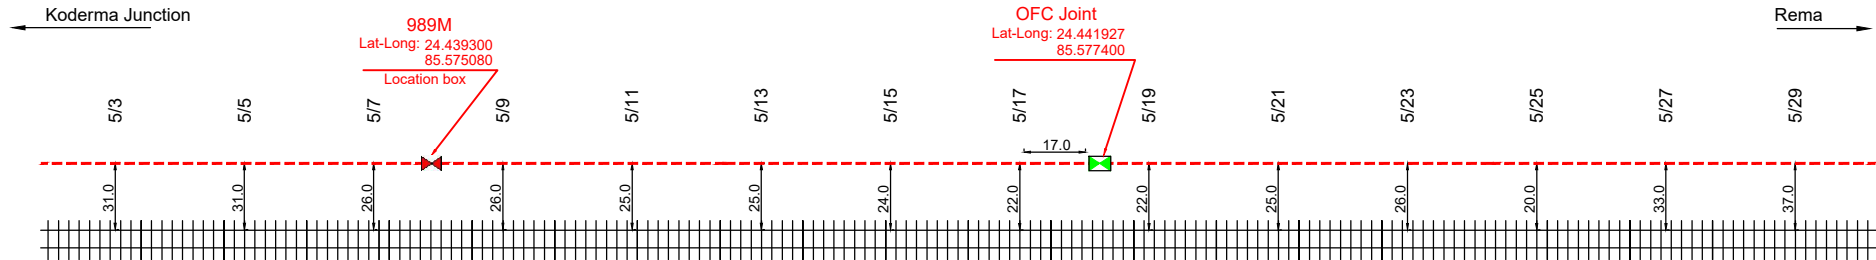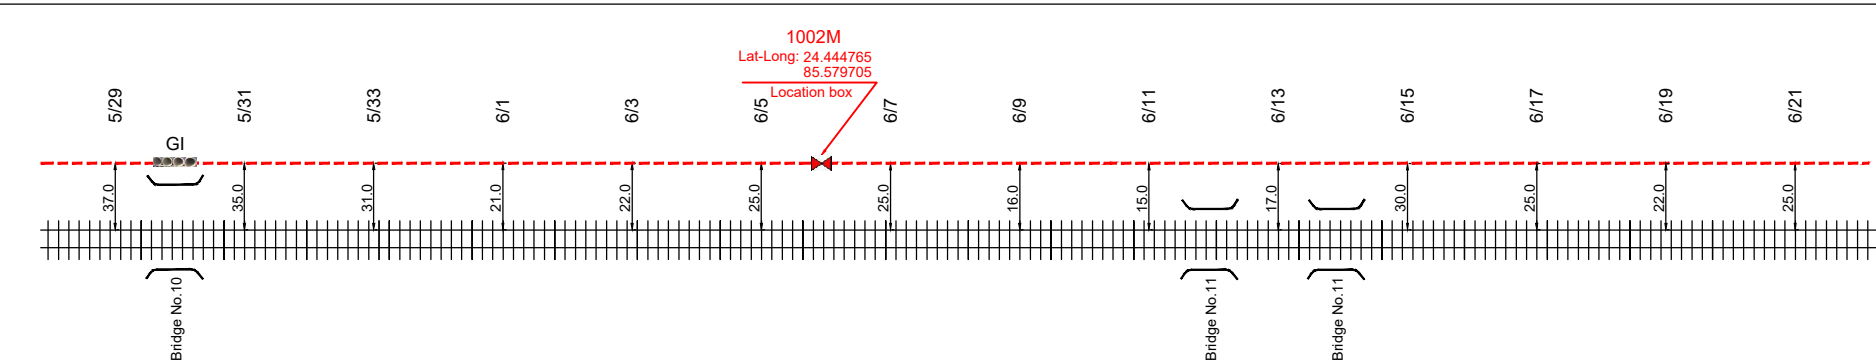

LEGENDS:

6 Quad joint / Location Box
Straight Joint



OFC Joint



DWC / GI



Rly Track



OFC & 6-Quad Cable



Bridge/Culvert



Kaccha/Pakka Road



GM	AGM/DGM	SR.MANAGER	PWI	SSE/ELECT	SSE/TD	SSE/SIG/M	
SSE/TELE/M	SR.DEE (TD/BB)	SR.DEE/G/BB	DEN (NE)	SR.DEN (CO)	ADRM	DRM	

RAILTEL CORPORATION OF INDIA LTD.
EASTERN REGION

PROJECT - Rectification of U/G OFC & 6 Quad copper cable
in KQR - Rema (55 km) Sec. of ECR
WO. NO. 2002110395, Dated 28.07.2021

PROJECT BY-
M/S U.K. TRADERS
10, LUXMANPUR ALLAHABAD ROAD SULTANPUR U.P.
PIN CODE - 228001

SCALE
NTS



SHEET No.
06



As Built Drawing For OFC & 6-Quad Cable Route

Section : - Koderma Junction To Rema Station
Sub. Section : - Koderma Junction To Koderma Town

Chainage : - 6/21 - 8/13

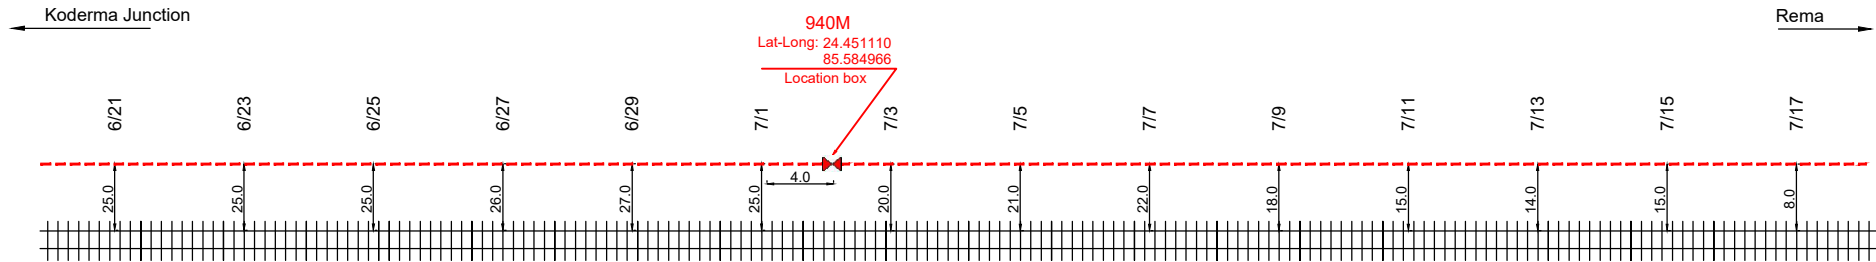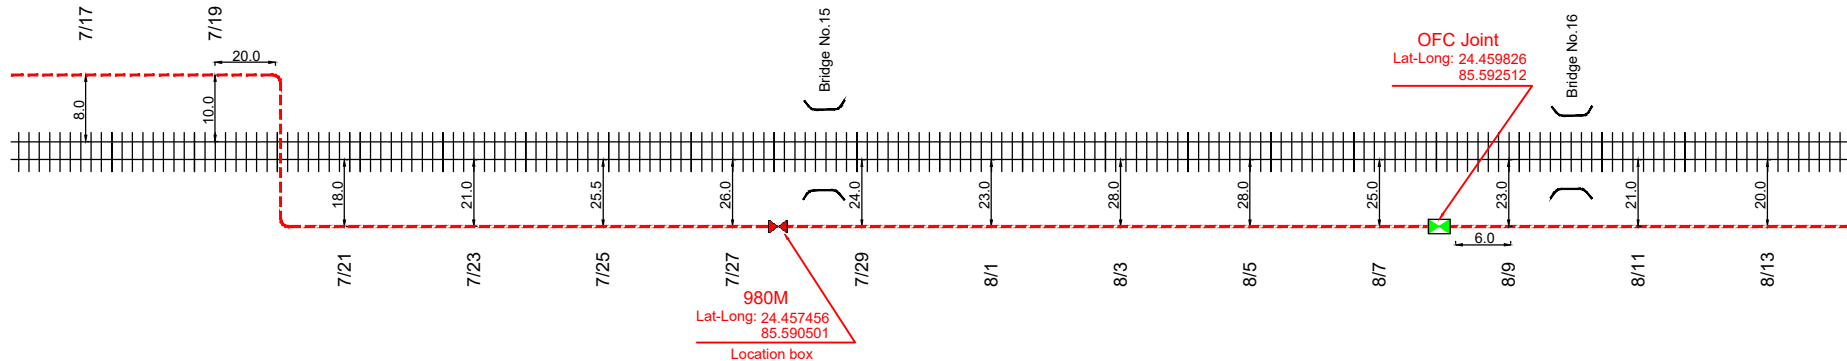

LEGENDS:

6 Quad joint / Location Box
Straight Joint



OFC Joint



DWC / GI



Rly Track



OFC & 6-Quad Cable



Bridge/Culvert



Kaccha/Pakka Road



GM	AGM/DGM	SR.MANAGER	PWI	SSE/ELECT	SSE/TD	SSE/SIG/M
SSE/TELE/M	SR.DEE (TD/BB)	SR.DEE/G/BB	DEN (NE)	SR.DEN (CO)	ADRM	DRM

RAILTEL CORPORATION OF INDIA LTD.
EASTERN REGION

PROJECT - Rectification of U/G OFC & 6 Quad copper cable
in KQR - Rema (55 km) Sec.of ECR
WO. NO. 2002110395, Dated 28.07.2021

PROJECT BY-
M/S U.K.TRADERS
10,LUXMANPUR ALLAHABAD ROAD SULTANPUR U.P
PIN CODE - 228001



SCALE
NTS

SHEET No.
07



As Built Drawing For OFC & 6-Quad Cable Route

Section : - Koderma Junction To Rema Station
Sub. Section : - Koderma Junction To Koderma Town
Chainage : - 8/13 - 9/25

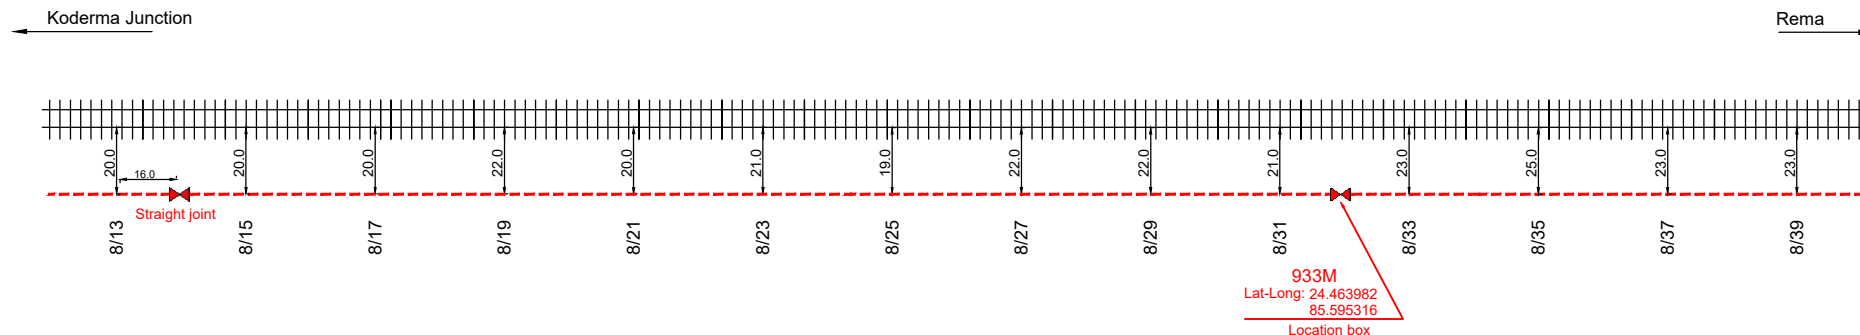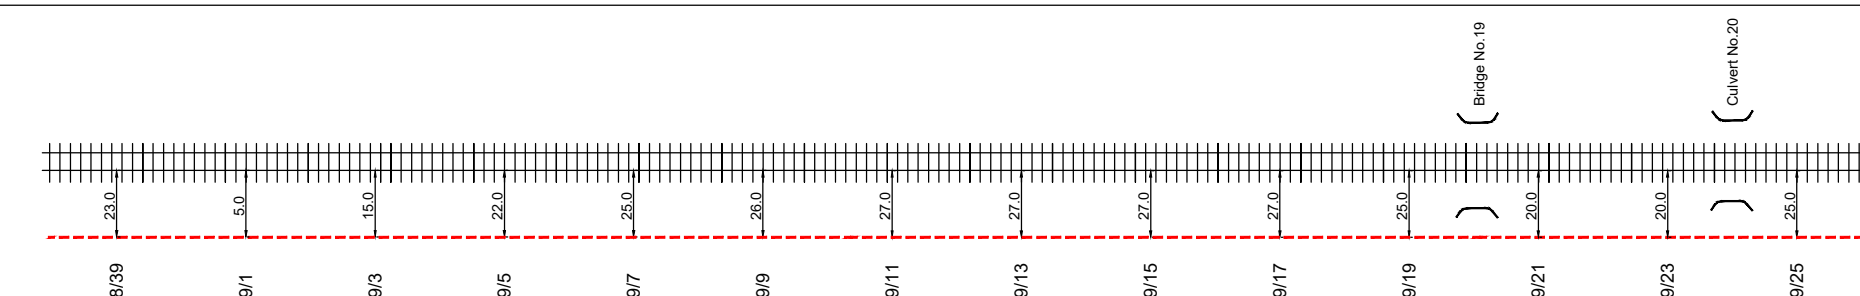

LEGENDS:

6 Quad joint / Location Box
Straight Joint



OFC Joint



DWC / GI



Rly Track



OFC & 6-Quad Cable



Bridge/Culvert



Kaccha/Pakka Road





RAILTEL CORPORATION OF INDIA LTD. EASTERN REGION						
PROJECT - Rectification of U/G OFC & 6 Quad copper cable in KQR - Rema (55 km) Sec. of ECR WO. NO. 2002110395, Dated 28.07.2021						
PROJECT BY- M/S U.K. TRADERS 10, LUXMANPUR ALLAHABAD ROAD SULTANPUR U.P. PIN CODE - 228001						
GM	AGM/DGM	SR.MANAGER	PWI	SSE/ELECT	SSE/TD	SSE/SIG/M
SSE/TELE/M	SR.DEE (TD/BB)	SR.DEE/G/BB	DEN (NE)	SR.DEN (CO)	ADRM	DRM
SCALE NTS					SHEET No. 08	



As Built Drawing For OFC & 6-Quad Cable Route

Section : - Koderma Junction To Rema Station
Sub. Section : - Koderma Junction To Koderma Town
Chainage : - 9/25 - 10/25

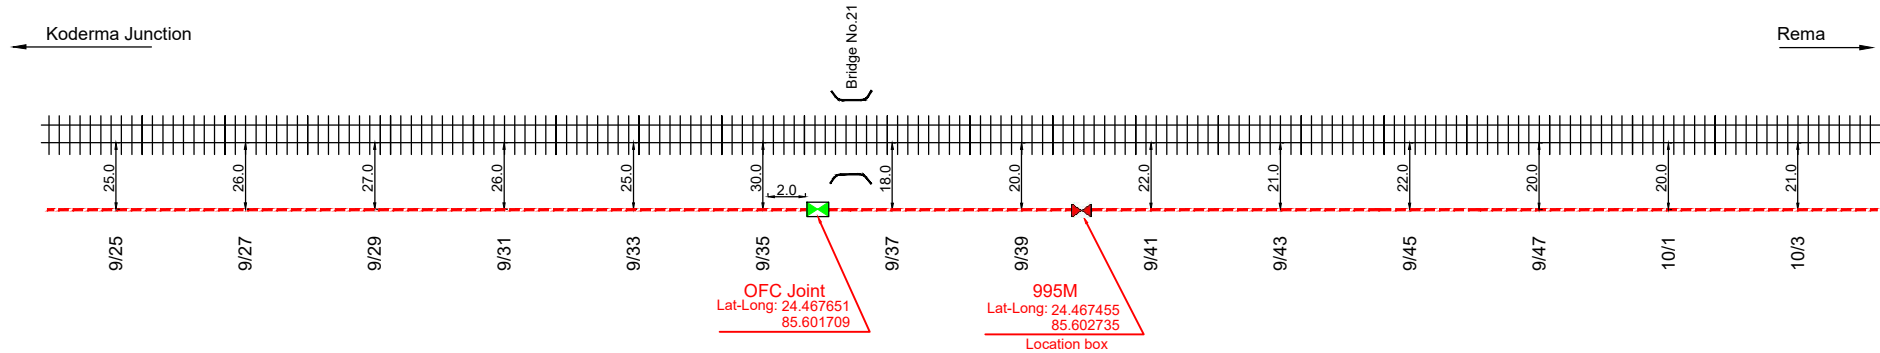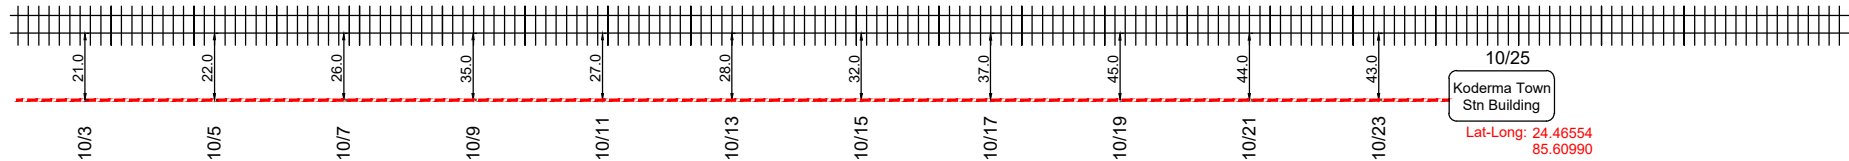

LEGENDS:

6 Quad joint / Location Box
Straight Joint



OFC Joint



DWC / GI



Rly Track



OFC & 6-Quad Cable



Bridge/Culvert



Kaccha/Pakka Road



GM	AGM/DGM	SR.MANAGER	PWI	SSE/ELECT	SSE/TD	SSE/SIG/M	
SSE/TELE/M	SR.DEE (TD/BB)	SR.DEE/G/BB	DEN (NE)	SR.DEN (CO)	ADRM	DRM	

RAILTEL CORPORATION OF INDIA LTD.
EASTERN REGION

PROJECT - Rectification of U/G OFC & 6 Quad copper cable
in KQR - Rema (55 km) Sec.of ECR
WO. NO. 2002110395,Dated 28.07.2021

PROJECT BY-
M/S U.K.TRADERS
10,LUXMANPUR ALLAHABAD ROAD SULTANPUR U.P
PIN CODE - 228001



SCALE
NTS

SHEET No.
09



As Built Drawing For OFC & 6-Quad Cable Route

Section : - Koderma Junction To Rema Station
Sub. Section : - Koderma Town To Maheshpur Halt
Chainage : - 10/25 - 11/35

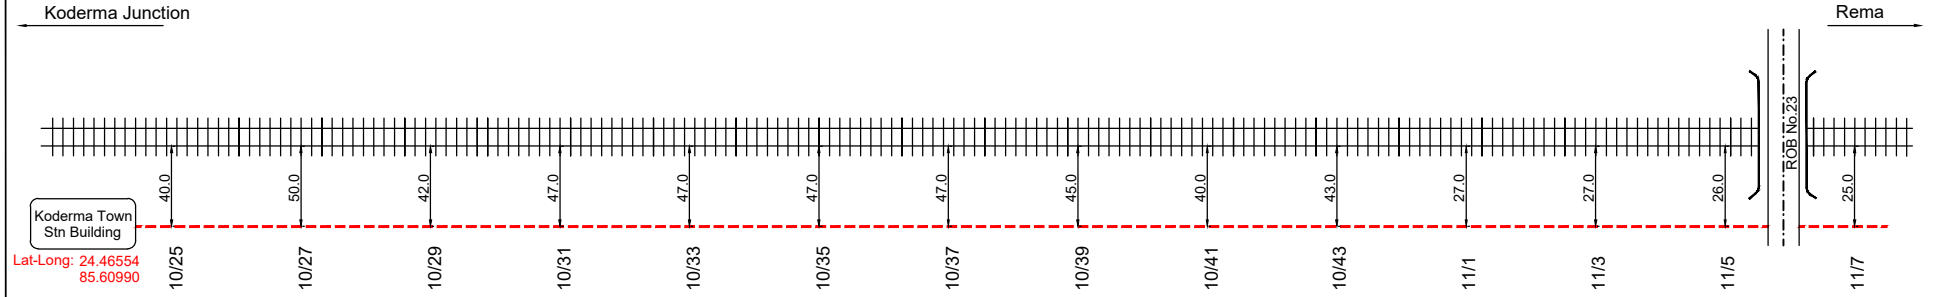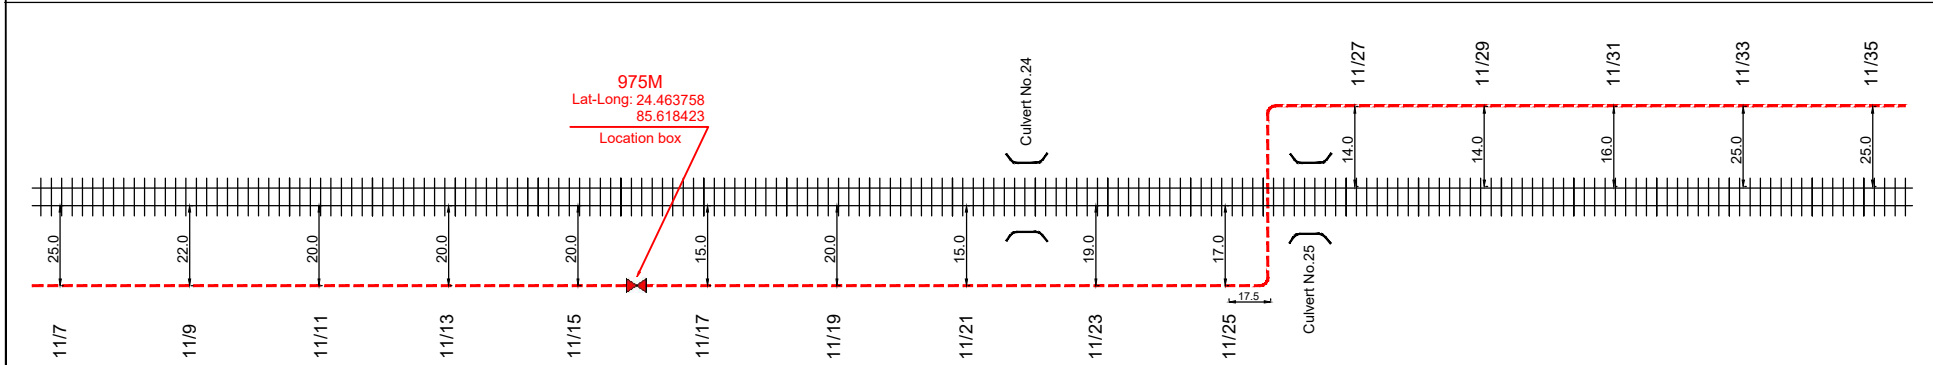

LEGENDS:

6 Quad joint / Location Box
Straight Joint



OFC Joint



DWC / GI



Rly Track



OFC & 6-Quad Cable



Bridge/Culvert



Kaccha/Pakka Road



GM	AGM/DGM	SR.MANAGER	PWI	SSE/ELECT	SSE/TD	SSE/SIG/M	
SSE/TELE/M	SR.DEE (TD/BB)	SR.DEE/G/BB	DEN (NE)	SR.DEN (CO)	ADRM	DRM	

RAILTEL CORPORATION OF INDIA LTD.
EASTERN REGION

PROJECT - Rectification of U/G OFC & 6 Quad copper cable
in KQR - Rema (55 km) Sec.of ECR
WO. NO. 2002110395,Dated 28.07.2021

PROJECT BY-

M/S U.K. TRADERS
10,LUXMANPUR ALLAHABAD ROAD SULTANPUR U.P
PIN CODE - 228001

SCALE
NTS

SHEET No.
10





As Built Drawing For OFC & 6-Quad Cable Route

Section : - Koderma Junction To Rema Station

Sub. Section : - Koderma Town To Maheshpur Halt

Chainage : - 11/35 - 13/19

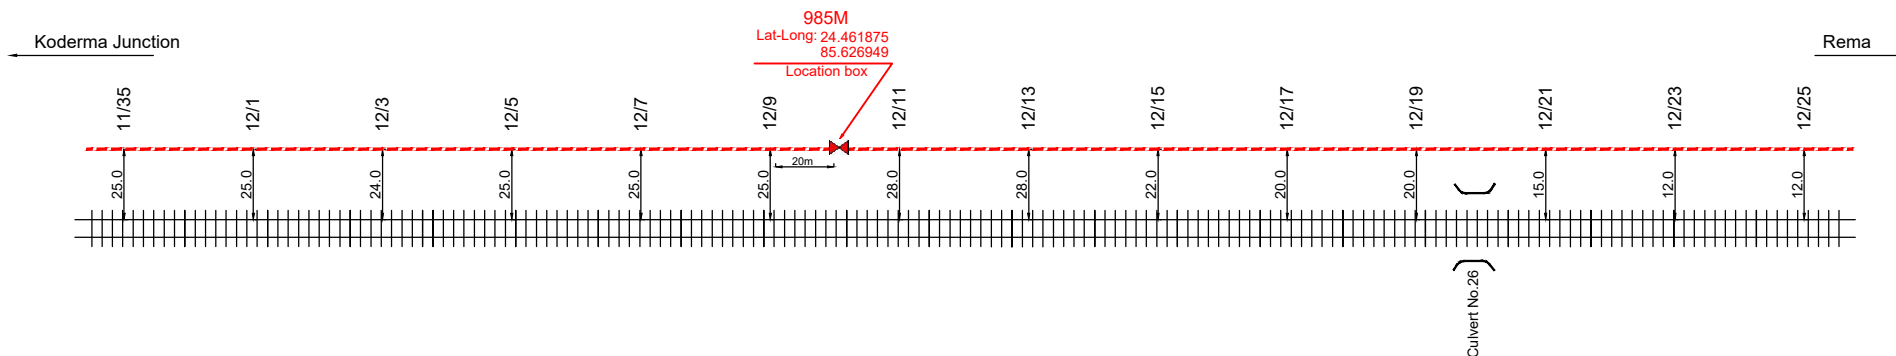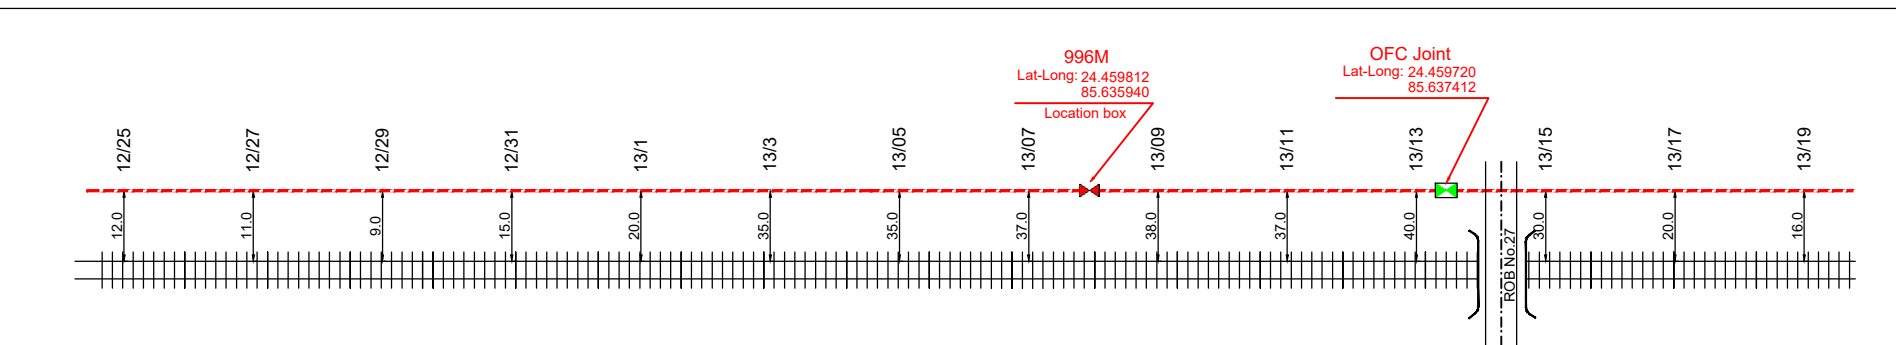

LEGENDS:

6 Quad joint / Location Box
Straight Joint



OFC Joint



DWC / GI



Rly Track



OFC & 6-Quad Cable



Bridge/Culvert



Kaccha/Pakka Road



GM	AGM/DGM	SR.MANAGER	PWI	SSE/ELECT	SSE/TD	SSE/SIG/M
SSE/TELE/M	SR.DEE (TD/BB)	SR.DEE/G/BB	DEN (NE)	SR.DEN (CO)	ADRM	DRM

RAILTEL CORPORATION OF INDIA LTD.
EASTERN REGION

PROJECT - Rectification of U/G OFC & 6 Quad copper cable
in KQR - Rema (55 km) Sec.of ECR
WO. NO. 2002110395, Dated 28.07.2021

PROJECT BY-
M/S U.K.TRADERS
10,LUXMANPUR ALLAHABAD ROAD SULTANPUR U.P
PIN CODE - 228001



SCALE
NTS

SHEET No.
11



As Built Drawing For OFC & 6-Quad Cable Route

Section : - Koderma Junction To Rema Station
Sub. Section : - Koderma Town To Maheshpur Halt
Chainage : - 13/19 - 15/1

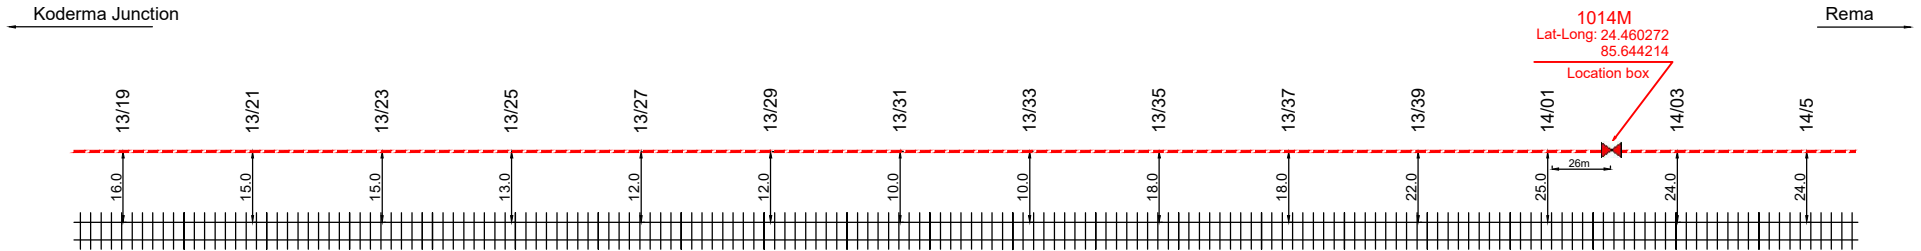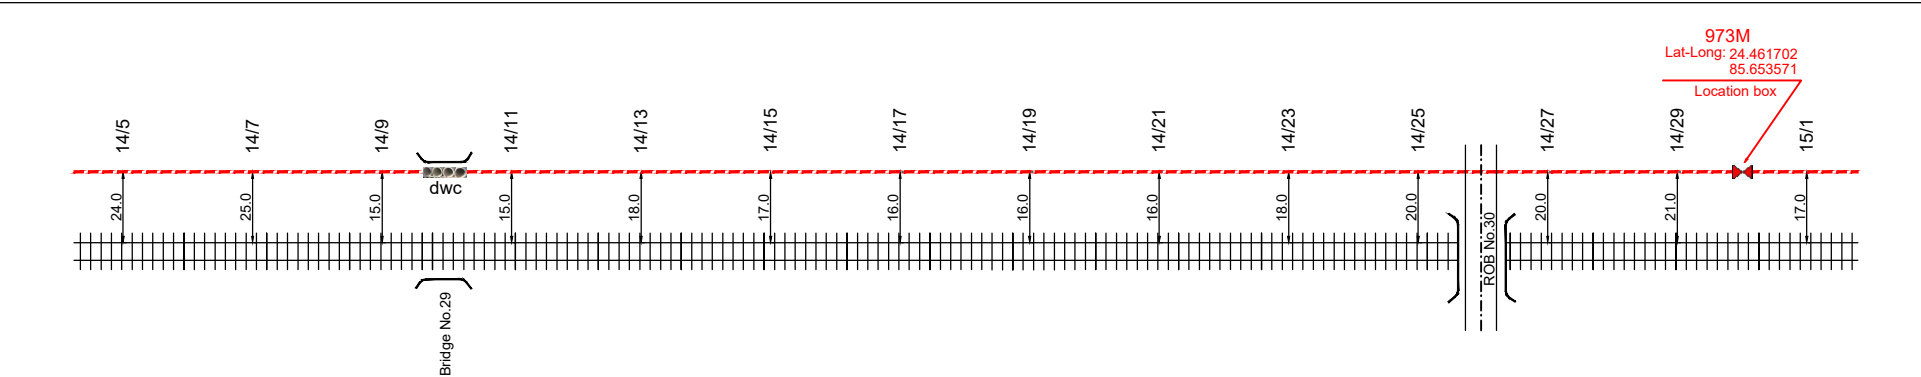

LEGENDS:

- 6 Quad joint / Location Box Straight Joint
- OFC Joint
- DWC / GI
- Rly Track
- OFC & 6-Quad Cable
- Bridge/Culvert
- Kaccha/Pakka Road

GM	AGM/DGM	SR.MANAGER	PWI	SSE/ELECT	SSE/TD	SSE/SIG/M	
SSE/TELE/M	SR.DEE (TD/BB)	SR.DEE/G/BB	DEN (NE)	SR.DEN (CO)	ADRM	DRM	

RAILTEL CORPORATION OF INDIA LTD.
EASTERN REGION

PROJECT - Rectification of U/G OFC & 6 Quad copper cable
in KQR - Rema (55 km) Sec. of ECR
WO. NO. 2002110395, Dated 28.07.2021

PROJECT BY-
M/S U.K. TRADERS
10, LUXMANPUR ALLAHABAD ROAD SULTANPUR U.P.
PIN CODE - 228001

SCALE
NTS

SHEET No.
12





As Built Drawing For OFC & 6-Quad Cable Route

Section : - Koderma Junction To Rema Station
Sub. Section : - Koderma Town To Maheshpur Halt
Chainage : - 15/1 - 16/23



Koderma Junction

Rema

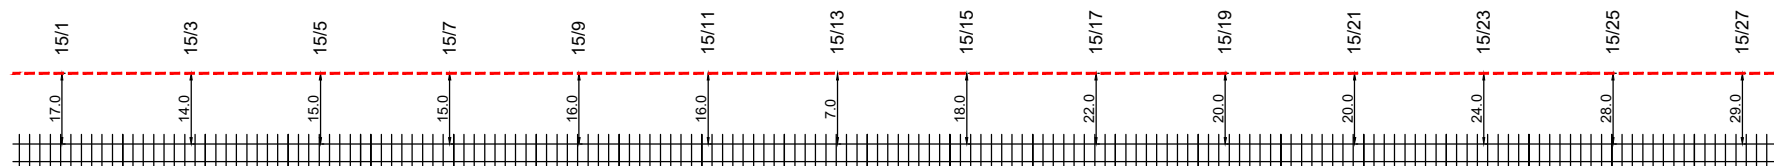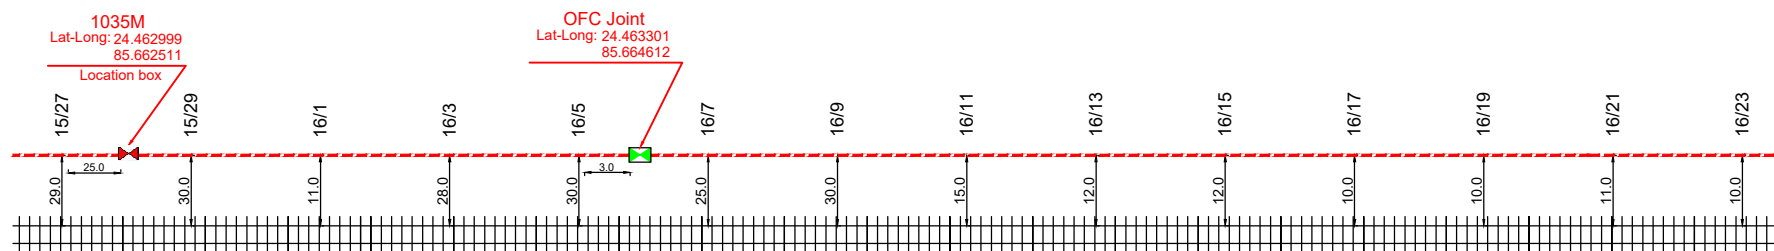

LEGENDS:

6 Quad joint / Location Box
Straight Joint



OFC Joint



DWC / GI



Rly Track



OFC & 6-Quad Cable



Bridge/Culvert



Kaccha/Pakka Road



GM	AGM/DGM	SR.MANAGER	PWI	SSE/ELECT	SSE/TD	SSE/SIG/M
SSE/TELE/M	SR.DEE (TD/BB)	SR.DEE/G/BB	DEN (NE)	SR.DEN (CO)	ADRM	DRM

RAILTEL CORPORATION OF INDIA LTD.
EASTERN REGION

PROJECT - Rectification of U/G OFC & 6 Quad copper cable
in KQR - Rema (55 km) Sec.of ECR
WO. NO. 2002110395,Dated 28.07.2021

PROJECT BY-
M/S U.K.TRADERS
10,LUXMANPUR ALLAHABAD ROAD SULTANPUR U.P
PIN CODE - 228001

SCALE
NTS

SHEET No.
13




As Built Drawing For OFC & 6-Quad Cable Route

Section : - Koderma Junction To Rema Station

Sub. Section : - Koderma Town To Maheshpur Halt

Chainage : - 16/23 - 18/9

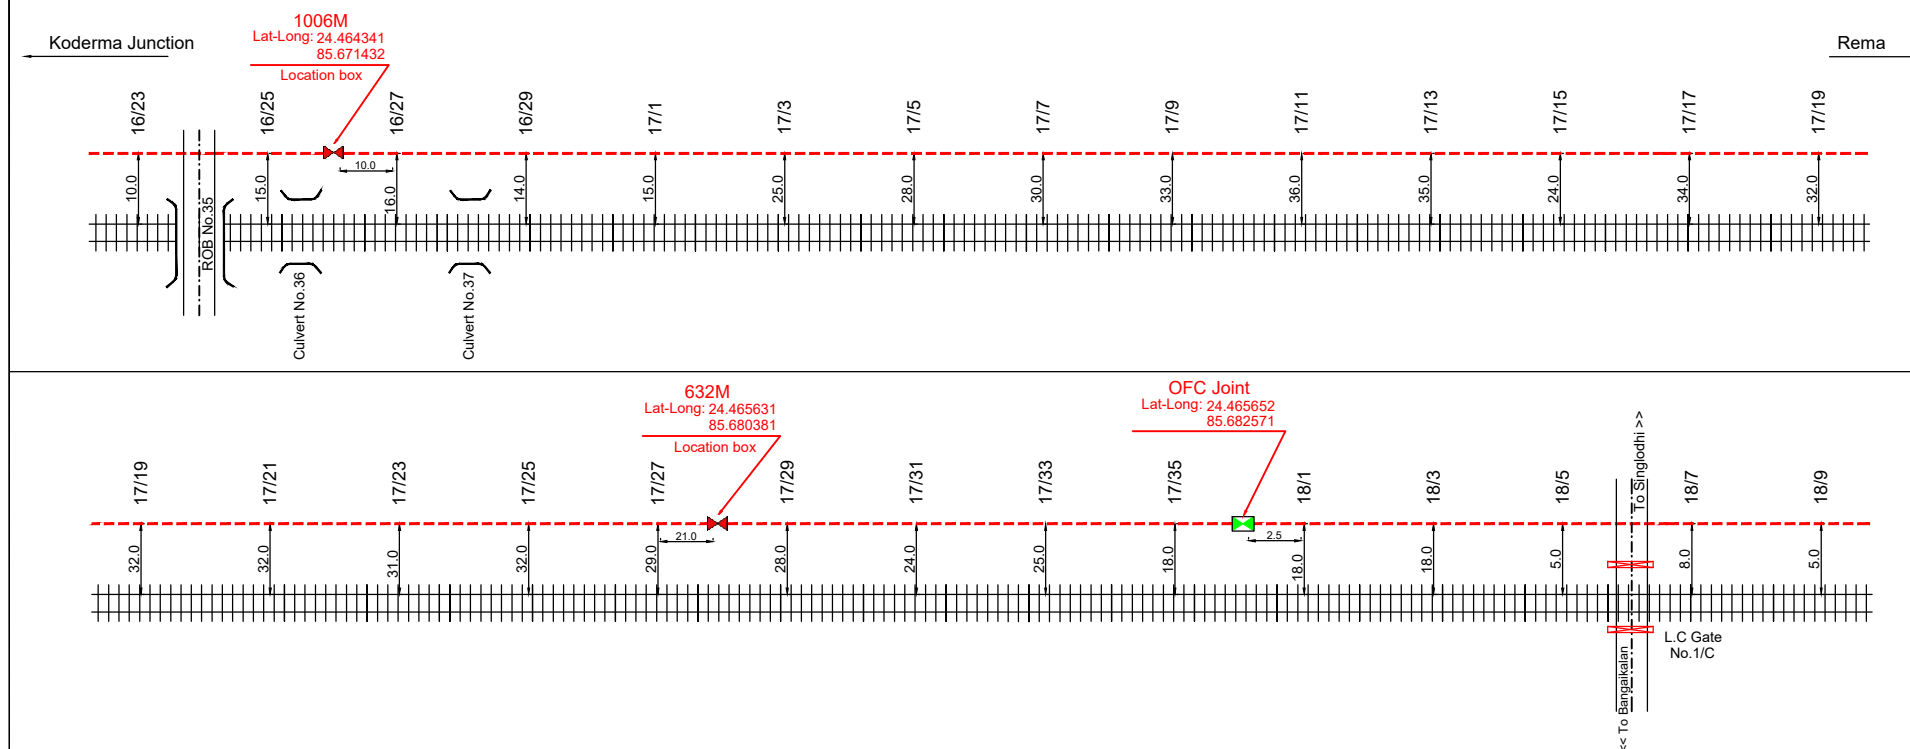

LEGENDS:

6 Quad joint / Location Box
Straight Joint

OFC Joint

DWC / GI

Rly Track

OFC & 6-Quad Cable

Bridge/Culvert

Kaccha/Pakka Road



GM	AGM/DGM	SR.MANAGER	PWI	SSE/ELECT	SSE/TD	SSE/SIG/M
SSE/TELE/M	SR.DEE (TD/BB)	SR.DEE/G/BB	DEN (NE)	SR.DEN (CO)	ADRM	DRM

RAILTEL CORPORATION OF INDIA LTD.
EASTERN REGION

PROJECT - Rectification of U/G OFC & 6 Quad copper cable
in KQR - Rema (55 km) Sec.of ECR
WO. NO. 2002110395,Dated 28.07.2021

PROJECT BY-

M/S U.K.TRADERS
10,LUXMANPUR ALLAHABAD ROAD SULTANPUR U.P
PIN CODE - 228001

SCALE
NTS

SHEET No.
14





As Built Drawing For OFC & 6-Quad Cable Route

Section : - Koderma Junction To Rema Station

Sub. Section : - Koderma Town To Maheshpur Halt

Chainage : - 18/9 - 19/21

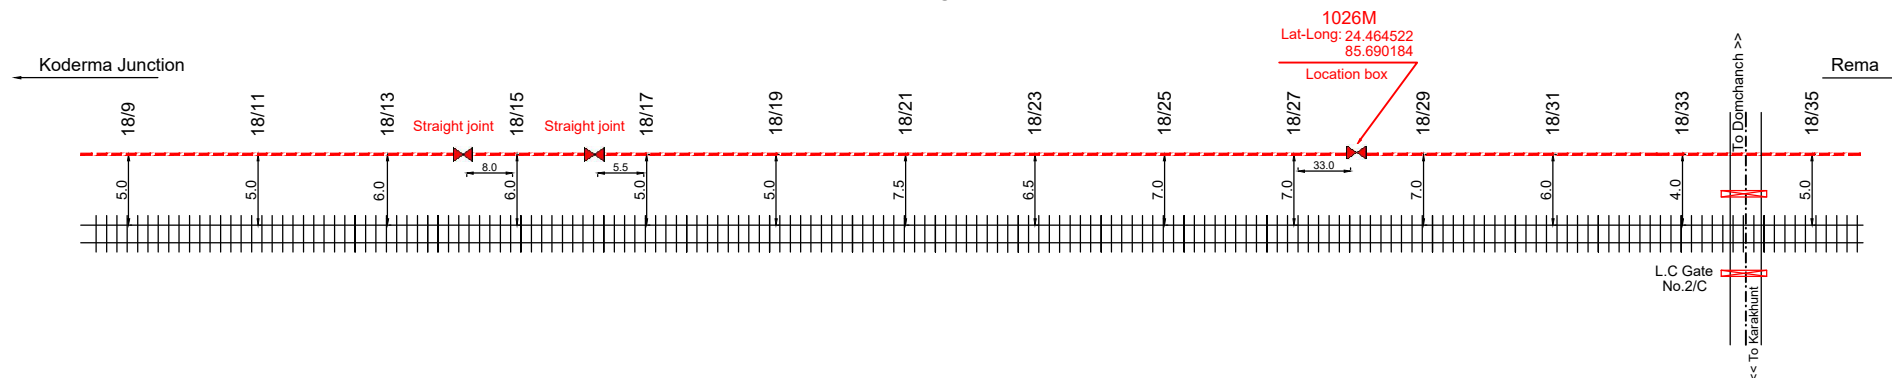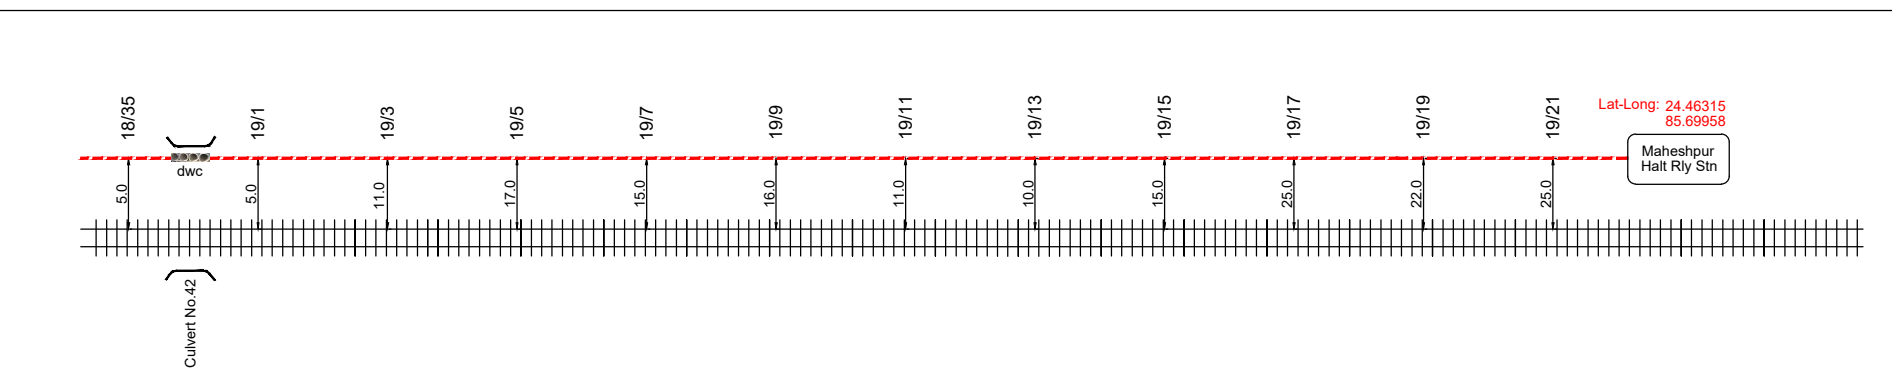

LEGENDS:

6 Quad joint / Location Box
Straight Joint



OFC Joint



DWC / GI



Rly Track



OFC & 6-Quad Cable



Bridge/Culvert



Kaccha/Pakka Road



GM	AGM/DGM	SR.MANAGER	PWI	SSE/ELECT	SSE/TD	SSE/SIG/M
SSE/TELE/M	SR.DEE (TD/BB)	SR.DEE/G/BB	DEN (NE)	SR.DEN (CO)	ADRM	DRM

RAILTEL CORPORATION OF INDIA LTD.
EASTERN REGION

PROJECT - Rectification of U/G OFC & 6 Quad copper cable
in KQR - Rema (55 km) Sec.of ECR
WO. NO. 2002110395, Dated 28.07.2021

PROJECT BY-
M/S U.K.TRADERS
10,LUXMANPUR ALLAHABAD ROAD SULTANPUR U.P
PIN CODE - 228001

SCALE
NTS

SHEET No.
15

DERMA

6 - QUAD CABLE ROUTE DIAGRAM (SECTION REMA - KAWAR)

KAWAR →

REMA

RAILWAY TRACK (SINGLE LINE)

24m	56/20
19m	56/18
17m	56/16
15m	56/14
16m	56/12
32m	56/10
34m	56/8
38m	56/6
47m	56/4
50m	56/3
53m	56/1
45m	55/21
42m	55/20
40m	55/18
38m	55/16
38m	55/14
24m	55/12
25m	55/11
26m	55/10
25m	55/9
26m	55/8
24m	55/7
26m	55/6
27m	55/5
31m	55/4
← 39m →	55/3

R. Mandel
8367 Tele/Kar
03/12/2021

OFC AND 6 - QUAD CABLE ROUTE DIAGRAM (SECTION REMA - KANAR)

RAILWAY TRACK (SINGLE LINE)	
13 m	59/08
14 m	59/06
12 m	59/4
15 m	59/12
25 m	58/22
24 m	58/20
26 m	58/18
30 m	58/16
33 m	58/14
35 m	58/12
21 m	58/10
15 m	58/8
18 m	58/6
17 m	58/4
20 m	58/2
19 m	57/19
15 m	57/18
19 m	57/16
21 m	57/14
23 m	57/12
18 m	57/10
18 m	57/8
20 m	57/6
26 m	57/4
30 m	57/2
28 m	56/22

R. Mondal
8847461486
03/12/2024

OFC AND 6 - QUAD CABLE ROUTE DIAGRAM (SECTION REMA - KAWAR)

RAILWAY TRACK (SINGLE LINE)

17.000	61/18
18.000	61/16
20.000	61/14
25.000	61/12
35.000	61/10
33.000	61/8
36.000	61/6
30.000	61/4
28.000	61/2
11.000	60/19
12.000	60/18
13.000	60/16
10.000	60/14
15.000	60/12
16.000	60/10
16.000	60/08
26.000	60/06
33.000	60/04
13.000	60/02
11.000	59/21
11.000	59/20
10.000	59/18
10.000	59/16
14.000	59/14
15.000	59/12
13.000	59/10

F. Hand
886/1000
03/12/2014

OFC AND 6-QUAD CABLE ROUTE DIAGRAM (SECTION REMA - KANAR)

RAILWAY TRACK (SINGLE LINE)

18m.	64/02
11m.	63/23
13m	63/22
12m	63/20
12m	63/18
20m	63/16
15m	63/14
18m	63/12
25m	63/10
28m	63/08
35m	63/06
37m	63/04 63/04
46m	63/02
40m	62/20
35m	62/18
35m	62/16
32m	62/14
26m	62/12
18m	62/10
18m	62/08
11m	62/06
20m.	62/04
18m	62/02
15m	61/23
18m	61/22
22m	61/20

R. Mandi
SSE Field No. 1
03/12/2024
Page 4

OFC AND 6-QUAD CABLE ROUTE DIAGRAM (SECTION REMA - KANAR)

RAILWAY TRACK (SINGLE LINE)	
14m	66/08
11m	66/06
11m	66/04
14m	66/02
17m	65/22
15m	65/20
10m	65/18
16m	65/16
16m	65/14
22m	65/12
17m	65/10
16m	65/08
16m	65/06
14m	65/04
15m	65/03
16m	65/01
20m	64/21
22m	64/20
21m	64/18
21m	64/16
19m	64/14
19m	64/12
15m	64/10
15m	64/08
14m	64/06
12m	64/04

K. Mondal
 03/12/2021
 Page 5

OFC AND 6- QUAD CABLE ROUTE DIAGRAM (SECTION REMA - KANAR)

MMD →

RAILWAY TRACK (SINGLE LINE)	
17m	66/14
13m	66/12
14m	66/10
10m	66/08
11m	66/06
13m	66/04
15m	66/02
11m	67/22
10m	67/20
10m	67/18
10m	67/16
12m	67/14
15m	67/12
17m	67/10
24m	67/08
27m	67/06
23m	67/04
30m	67/02
15m	66/21
22m	66/20
31m	66/18
28m	66/16
17m	66/14
11m	66/12
14m	66/10

R. Handal
8847401422
03/11/2021

OFC AND 6-QUAD CABLE ROUTE DIAGRAM (SECTION REMA - KANAR)

RAILWAY TRACK (SINGLE LINE)

24m	70/10
22m	70/9
18m	70/8
21m	70/6
20m	70/05
22m	70/04
22m	70/03
21m	69/02
24m	70/01
22m	69/19
20m	69/18
20m	69/17
19m	69/16
19m	69/15
23m	69/14
17m	69/13
11m	69/12
10m	69/11
16m	69/10
18m	69/08
17m	69/06
18m	69/04
17m	69/02
22m	68/19
19m	68/18
11m	68/16

Handed
88/12/2021
03/12/2021

OFC AND 6 - QUAD CABLE ROUTE DIAGRAM (SECTION REMA - KAWAR)

MMD →



RAILWAY TRACK (SINGLE LINE)

56m	71/20
55m	71/19
56m	71/18
54m	71/17
54m	71/16
42m	71/14
37m	71/13
31m	71/12
29m	71/10
29m	71/09
29m	71/08
27m	71/07
27m	71/06
16m	71/05
14m	71/04
10m	71/03
11m	71/02
13m	71/01
18m	70/19
19m	70/18
18m	70/17
14m	70/16
12m	70/15
11m	70/14
15m	70/13
18m	70/12

R. Mondal
8861delus4
03/12/2021.
Page 8

OFC AND 6-QUAD CABLE ROUTE DIAGRAM (SECTION REMA-KAWAR.)

RAILWAY TRACK (SINGLE LINE)	
25m	724/08
33m	724/06
35m	724/04
37m	724/02
36m	723/24
32m	723/20
36m	723/18
25m	723/16
29m	723/14
25m	723/12
20m	723/10
20m	723/08
20m	723/06
16m	723/04
15m	723/02
33m	722/04
55m	722/02
45m	722/20
45m	722/18
41m	722/16
38m	722/14
42m	722/12
42m	722/10
46m	722/08
45m	722/06
56m	722/04
	722/02

K. Nanda
88/12/2024
02/12/2024

Page ⑨

⑪

OFC AND 6-QUAD CABLE ROUTE DIAGRAM (SECTION REMA-KAWAR)

MMD →



RAILWAY TRACK (SINGLE LINE)

26m	74/08
05m	74/04
22m	74/02
28m	76/18
21m	76/16
21m	76/14
19m	76/12
25m	76/10
28m	76/08
17m	76/06
14m	76/04
20m	76/02
17m	75/18
16m	75/16
14m	75/14
15m	75/12
14m	75/10
16m	75/08
20m	75/06
15m	75/04
13m	75/02
24m	74/21
25m	74/20
22m	74/18
20m	74/16
18m	74/14
17m	74/12
28m	74/10

R. Mondal
SSE/Telecom
03.12.2024.

Page 10

OFC AND 6-QUAD CABLE ROUTE DIAGRAM (SECTION REMA-KANAR)

RAILWAY TRACK (SINGLE LINE)

17m.	80/02
18m	79/20
15m	79/18
21m	79/16
22m	79/14
25m	79/12
23m.	79/10
20m.	79/08
22m	79/06
23m	79/04
21m.	79/02
19m	78/20
17m	78/18
17m	78/16
16m	78/14
14m	78/12
15m	78/10
15m	78/08
14m	78/06
15m	78/04
20m.	78/02
23m	77/18
23m	77/16
19m	77/14
23m	77/12
27m	77/10

R. Mondy
886/Telephone
03/12/2021.

OFC AND 6- QUAD CABLE ROUTE DIAGRAM (SECTION REMA - KAWAR)

RAILWAY TRACK (SINGLE LINE)	
13m	82/12
11m	82/10
25m	82/08
28m	82/06
25m	82/05
25m	82/03
23m	82/01
27m	81/18
26m	81/16
30m	81/14
25m	81/12
30m	81/10
25m	81/08
29m	81/06
31m	81/04
28m	81/02
24m	80/19
27m	80/17
24m	80/15
22m	80/13
23m	80/12
18m	80/11
20m	80/10
19m	80/8
18m	80/06
17m	80/4

R. Manoj
8807 Telephone
03/14/2024
Page (12)

0 FC AND 6-QUAD CABLE ROUTE DIAGRAM (SECTION REMA-KAWAR.)

RAILWAY TRACK (SINGLE LINE)


13m	85/04
12m	85/02
11m	84/18
16m	84/16
13m	84/14
12m	84/12
11m	84/10
14m	84/08
19m	84/06
16m	84/04
13m	84/02
14m	83/19
15m	83/18
18m	83/17
19m	83/16
17m	83/14
15m	83/12
12m	83/10
13m	83/08
13m	83/06
20m	83/04
24m	83/02
23m	82/18
22m	82/16
24m	82/15
24m	82/13

R. Mondal
 8887704111111
 03/12/2021
 Page (13)

OFC AND

6 - QUAD CABLE ROUTE DIAGRAM (SECTION REMA - KAWAR)

MMD →

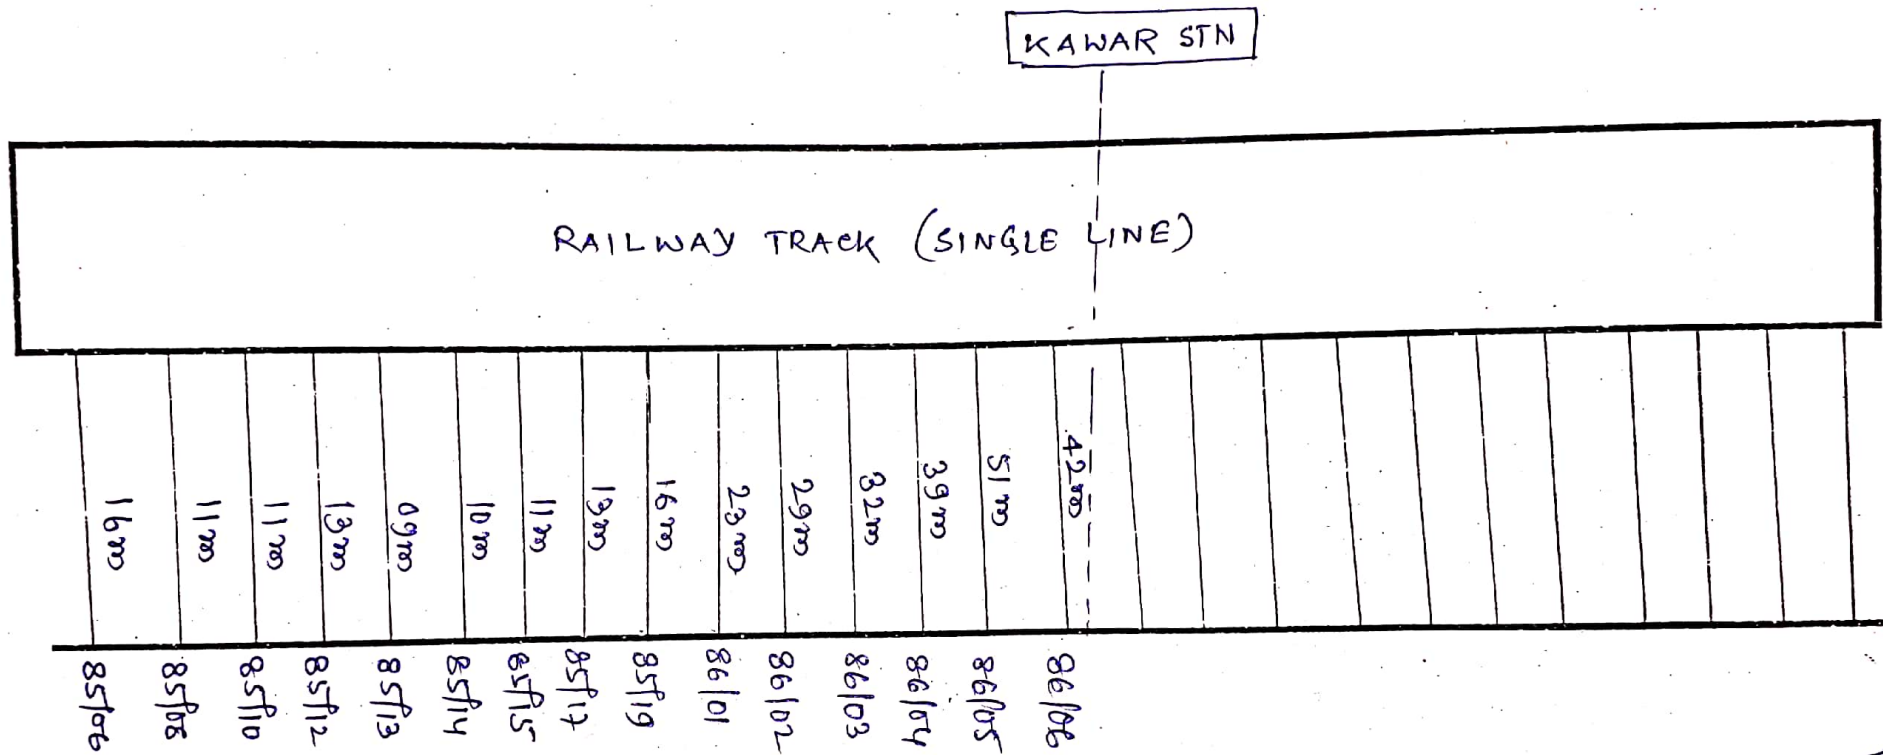

R. Mondal
SSC Telecom R.
09/12/2021

OFC AND 6-QUAD CABLE ROUTE DIAGRAM (SECTION KAWAR - SALAIYA)

MMD →

KAWAR STN

RAILWAY TRACK (SINGLE LINE)	
86/6	8 m
86/8	28 m
86/10	24 m
86/12	19 m
86/14	22 m
86/16	24 m
86/18	28 m
87/02	33 m
87/04	25 m
87/06	23 m
87/08	18 m
87/10	17 m
87/12	13 m
87/14	14 m
87/16	15 m
87/18	15 m
87/19	16 m
88/02	25 m
88/04	15 m
88/06	16 m
88/08	18 m
88/10	25 m
88/12	26 m

TRACK CROSSING

F. Monali
SST/706/KBR
30/12/2021

MMD →

OFC AND 6 - QUAD CABLE ROUTE DIAGRAM (SECTION KAWAR - SALAIYA)

88/14	11 m	RAILWAY TRACK (SINGLE LINE)
88/16	18 m	
88/18	19 m	
89/01	21 m	
89/03	24 m	
89/04	23 m	
89/06	25 m	
89/08	30 m	
89/10	36 m	
89/12	40 m	
89/13	42 m	
89/15	46 m	
89/18	33 m	
89/19	25 m	
90/01	23 m	
90/03	15 m	
90/05	13 m	
90/06	14 m	
90/08	09 m	
90/10	10 m	
90/11	12 m	
90/13	18 m	
90/15	14 m	
90/17	16 m	
90/19	17 m	

TRACK CROSSING

K. Mondal
SSG Telecom
30/12/2021

MMD →

OFC AND 6-QUAD CABLE ROUTE DIAGRAM (SECTION KANAR - SALAIYA)

93/05	11 m
93/03	13 m.
93/01	11 m
92/19	14 m
92/18	15 m
92/16	16 m
92/14	13 m
92/12	11 m
92/10	10 m
92/09	13 m
92/07	13 m
92/05	22 m
92/04	18 m
92/02	22 m
91/18	20 m
91/17	28 m
91/16	24 m
91/14	35 m
91/12	33 m
91/10	34 m
91/09	29 m
91/08	31 m
91/06	33 m
91/04	31 m
91/03	28 m
91/01	22 m.

RAILWAY TRACK (SINGLE-LINE)

R. Mand
SSR/Telephone
30/12/2021
Page ③

MMD →


OFC AND 6- QUAD CABLE ROUTE DIAGRAM (SECTION KAWAR - SALAIYA)

93/06	18 m.
93/08	25 m
93/10	24 m
93/11	22 m
93/12	18 m
93/13	19 m
93/15	16 m
93/17	14 m
93/19	15 m
94/02	22 m.
94/04	29 m
94/06	40 m
94/08	45 m
94/09	41 m
94/10	38 m
94/12	33 m
94/14	28 m
94/15	25 m
94/17	22 m
94/19	23 m
95/01	26 m
95/03	30 m
95/05	28 m
95/06	26 m
95/08	20
95/10	33 m.

RAILWAY TRACK (SINGLE LINE)

R. Mandal
SST/Tele/USE
30/12/2024.

OFC AND 6 - QUAD CABLE ROUTE DIAGRAM (SECTION KAWAR - SALAIYA)

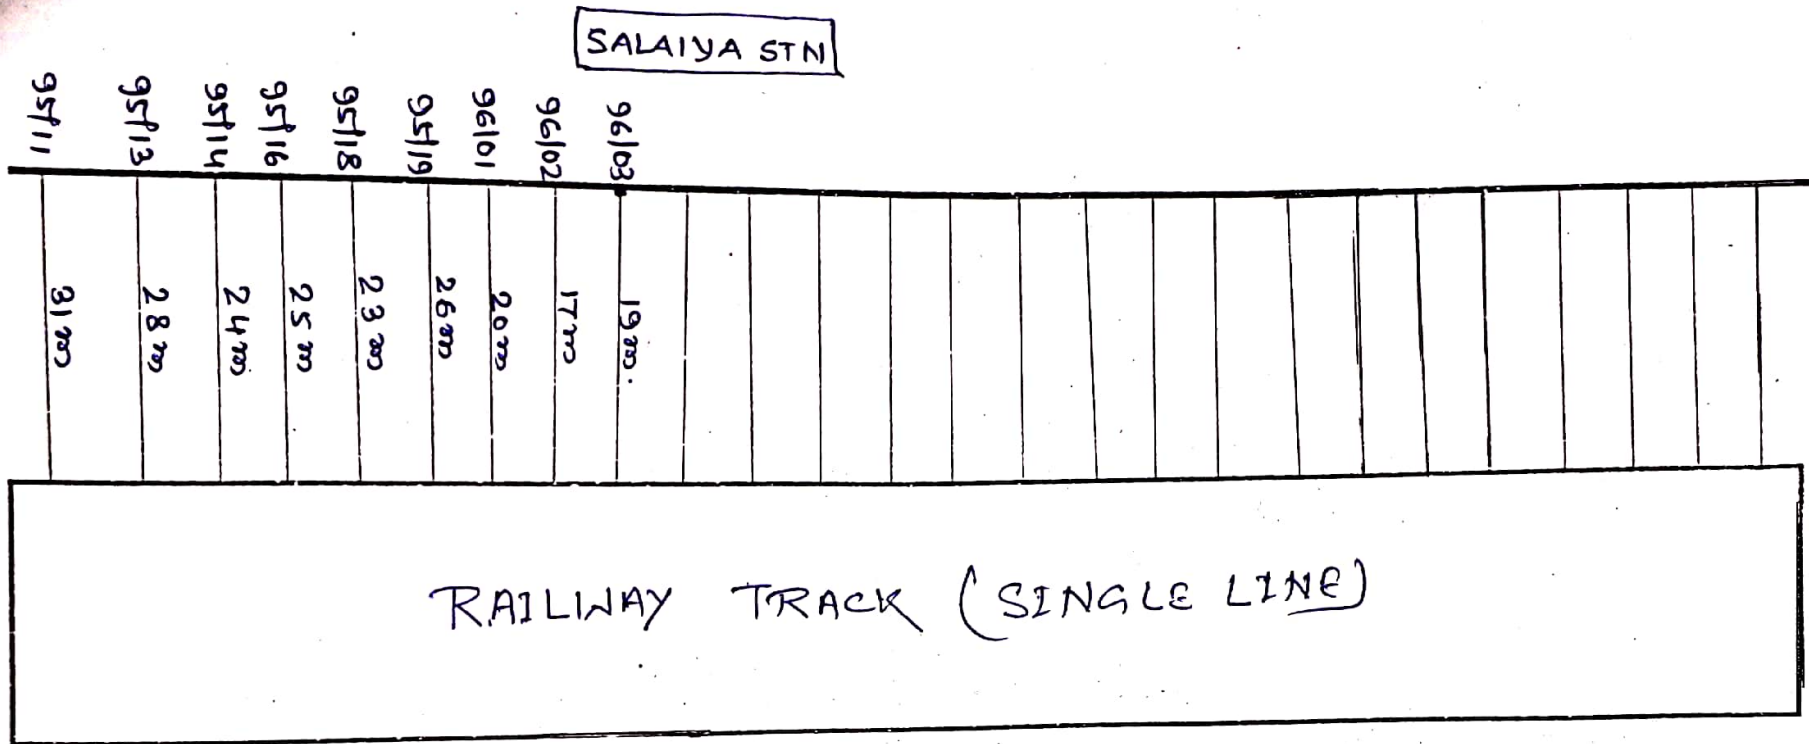

T. Mandal
 SSB Td/URR
 30/12/2021

OFC AND 6-QUAD CABLE ROUTE DIAGRAM (SECTION SALAIYA - NGRH)

SALAIYA

96/04	18 m.
96/06	20 m
96/08	25 m
96/10	31 m
96/12	31 m
96/13	30 m
96/15	32 m
96/17	28 m
96/18	14 m
96/19	13 m
97/01	19 m
97/03	18 m
97/05	19 m
97/07	22 m
97/09	25 m
97/11	30 m
97/13	28 m
97/15	31 m
97/16	29 m
97/18	29 m
97/19	30 m
98/01	24 m
98/03	25 m
98/05	40 m
98/07	42 m
98/09	42 m.

RAILWAY TRACK (SINGLE LINE)

K. Mandi
887/tele/NGR
06/04/2022.

MMD →

6 - QUAD CABLE ROUTE DIAGRAM (SECTION SALAIYA - NG RH)


100/15	29 m
100/14	26 m
100/12	27 m
100/10	26 m
100/09	26 m
100/07	28 m
100/05	30 m
100/03	17 m
100/01	11 m
99/19	25 m
99/18	25 m
99/16	24 m
99/15	21 m
99/13	21 m
99/12	19 m
99/10	31 m
99/08	35 m
99/06	41 m
99/04	41 m
99/02	31 m
98/18	26 m
98/16	25 m
98/15	23 m
98/13	23 m
98/12	25 m
98/10	26 m

RAILWAY TRACK (SINGLE LINE)

R. Nandall
SS & Fide/NER
06/01/2022

NMD →


6 - QUAD CABLE ROUTE DIAGRAM (SECTION SALAIYA - NGRH.)

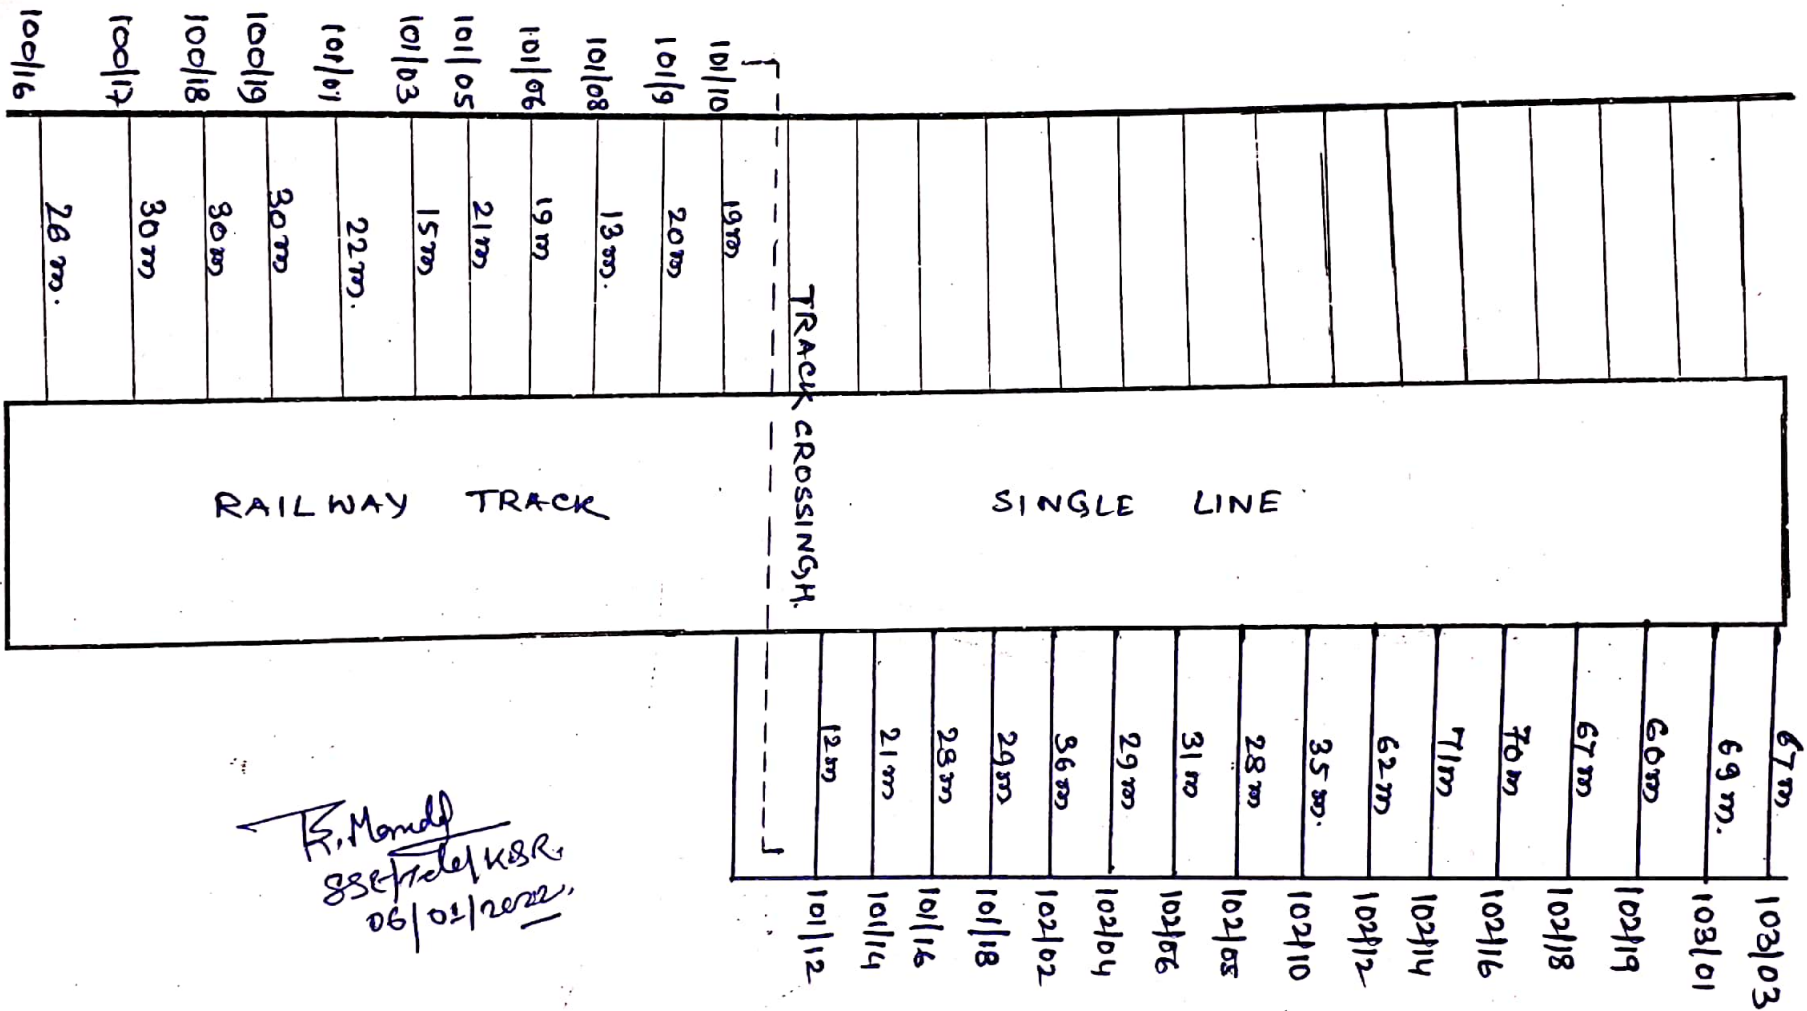

K. Mondal
SSE/Tele K&R
06/01/2022

OFC AND 6-QUAD CABLE ROUTE DIAGRAM (SECTION SALAIYA - NGRH)

NMD →

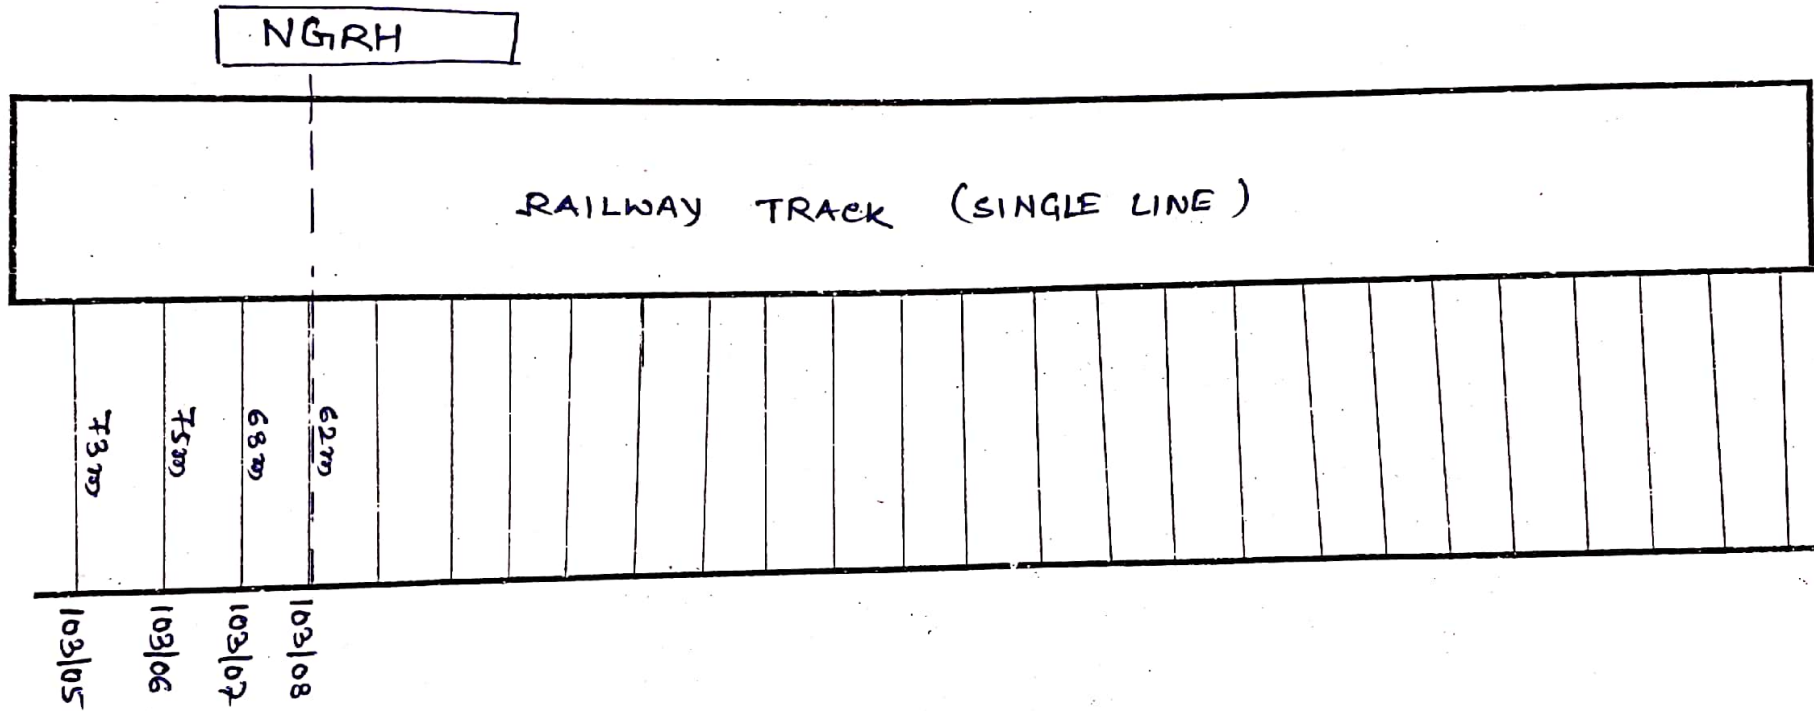

R. Mani
SS & Tele/NGR
06/01/2022


Ofc and 6-QUAD CABLE ROUTE DIAGRAM (SECTION NGRH - MMD)

NGRH.	
RAILWAY TRACK (SINGLE LINE)	
32m	105/19
83m	105/17
80m	105/15
86m	105/13
39m	105/11
29m	105/09
81m	105/07
35m	105/05
36m	105/03
50m	105/01
41m	104/18
14m	104/16
13m	104/15
26m	104/13
26m	104/11
40m	104/09
45m	104/07
71m	104/05
74m	104/03
74m	104/01
74m	103/19
72m	103/17
70m	103/16
80m	103/14
88m	103/12
37m	103/10
35m	103/08

K. Nand
888/766/KBR
15/01/2022

MMD →

OFC AND 6 - QUAD CABLE ROUTE DIAGRAM (SECTION: NGRH - MMD.)

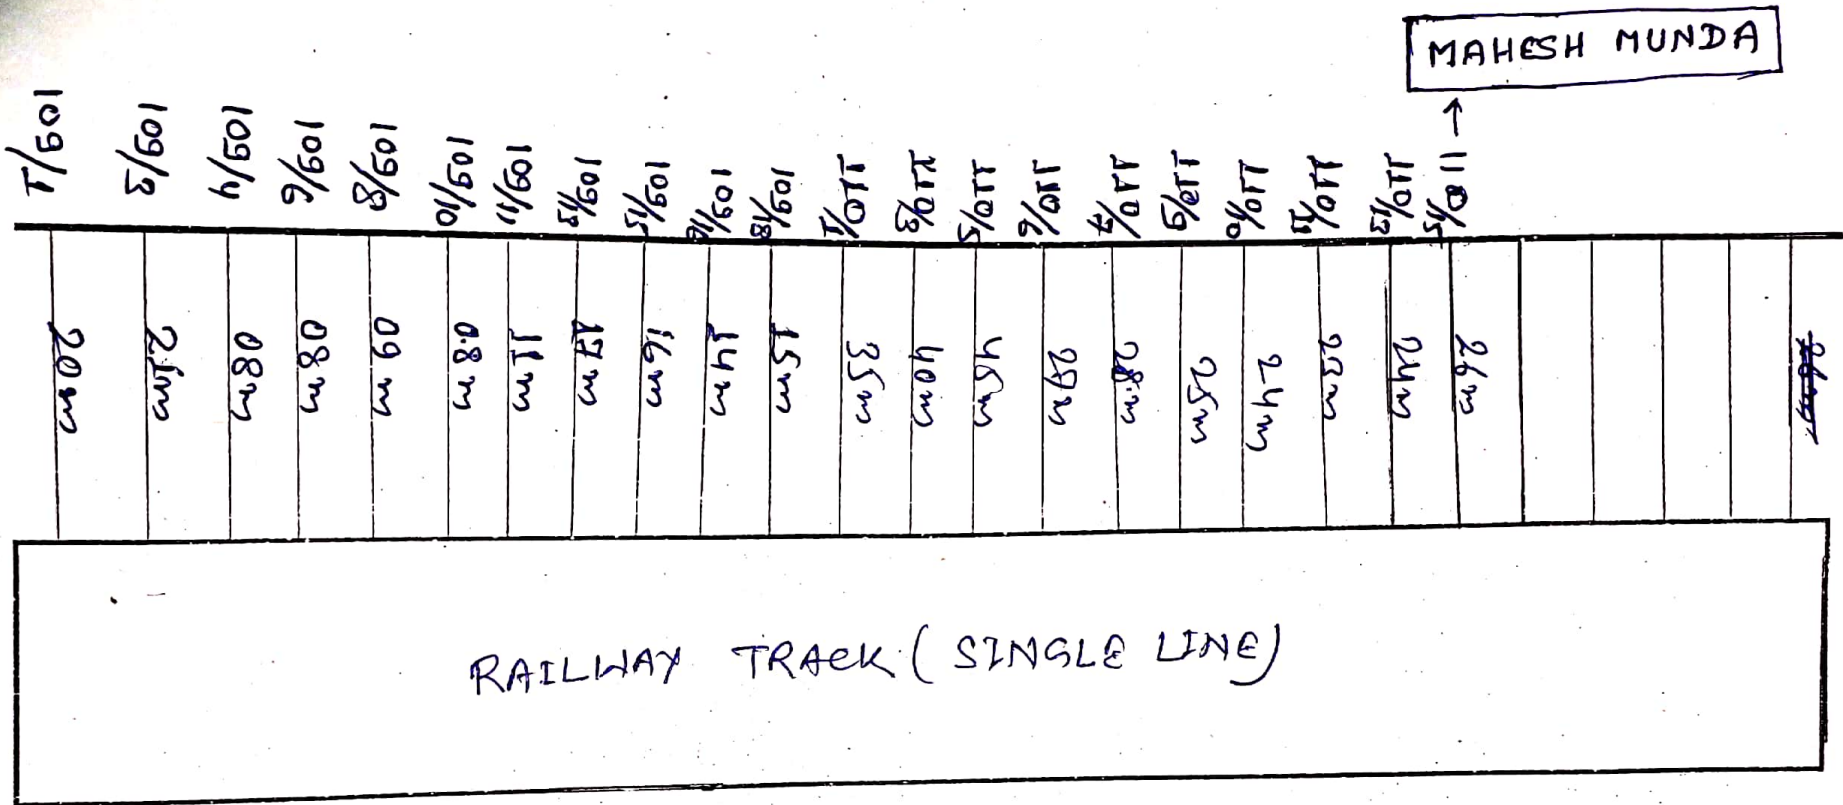

R. Munda
SSE/Telecom R.
15/01/2022.

Page-3