



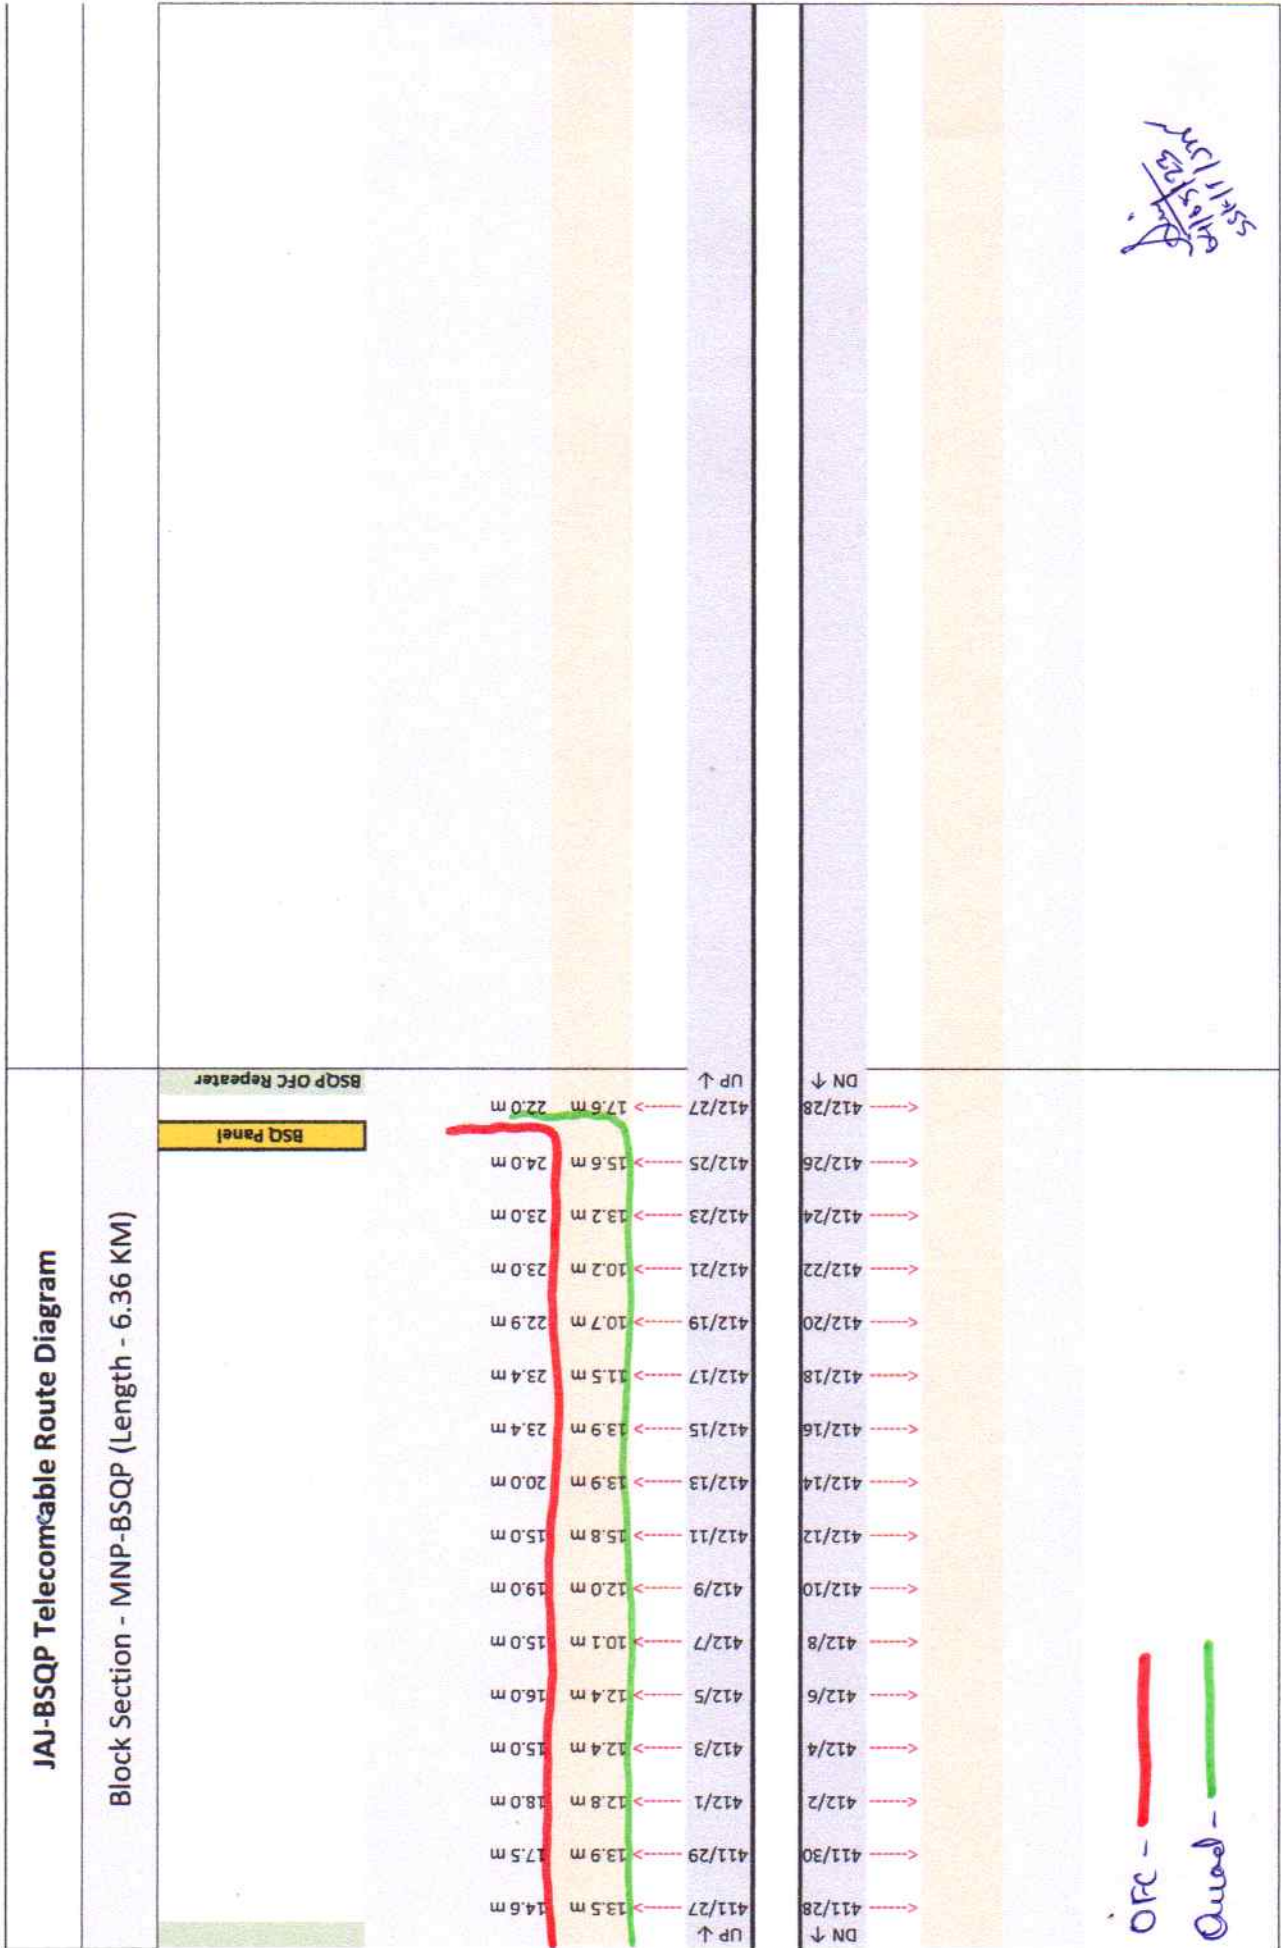

20.

JAI-BSQP Telecomable Route Diagram

Block Section - MNP-BSQP (Length - 6.36 KM)

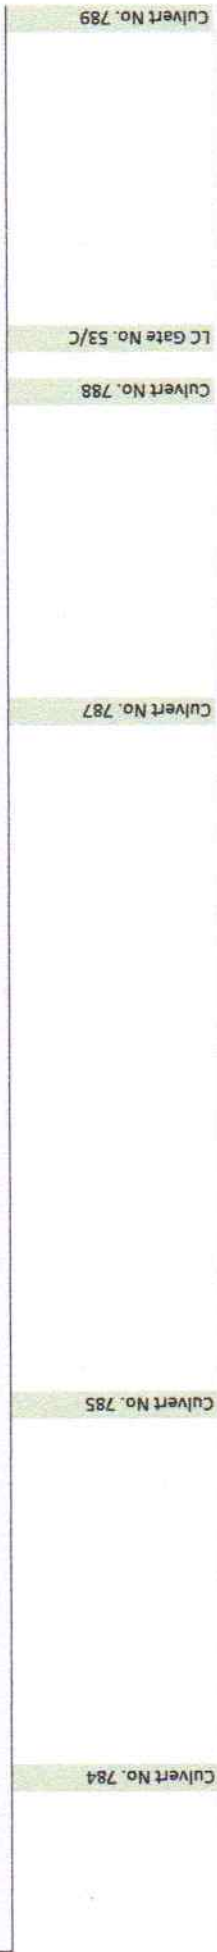


DN ↓	409/14	16.0 m	10.3 m	16.0 m	UP ↓
↔	409/16	15.0 m	09.0 m	15.0 m	
↔	409/18	16.0 m	09.8 m	16.0 m	
↔	409/20	22.5 m	08.3 m	22.5 m	
↔	409/22	21.9 m	08.2 m	21.9 m	
↔	409/24	22.9 m	09.6 m	22.9 m	
↔	409/26	24.0 m	09.9 m	24.0 m	
↔	409/28	23.0 m	15.0 m	23.0 m	
↔	410/2	22.0 m	09.5 m	22.0 m	
↔	410/4	22.0 m	14.3 m	22.0 m	
↔	410/6	22.0 m	14.8 m	22.0 m	
↔	410/8	21.4 m	12.0 m	21.4 m	
↔	410/10	13.7 m	09.9 m	13.7 m	
↔	410/12	11.7 m	10.8 m	11.7 m	
↔	410/14	11.0 m	10.4 m	11.0 m	
↔	410/16	11.2 m	08.2 m	11.2 m	
↔	410/18	11.0 m	10.3 m	11.0 m	
↔	410/20	11.9 m	08.2 m	11.9 m	
↔	410/22	13.7 m	08.5 m	13.7 m	
↔	410/24	12.6 m	08.7 m	12.6 m	
↔	410/26	14.8 m	10.5 m	14.8 m	
↔	410/28	19.6 m	12.0 m	19.6 m	
↔	410/30	19.6 m	12.0 m	19.6 m	
↔	411/2	09.8 m	12.3 m	09.8 m	
↔	411/4	11.0 m	10.9 m	11.0 m	
↔	411/6	11.0 m	10.9 m	11.0 m	
↔	411/8	10.2 m	05.4 m	10.2 m	
↔	411/10	10.8 m	10.8 m	10.8 m	
↔	411/12	10.0 m	12.9 m	10.0 m	
↔	411/14	14.9 m	09.0 m	14.9 m	
↔	411/16	15.1 m	05.5 m	15.1 m	
↔	411/18	06.3 m	08.2 m	06.3 m	
↔	411/20	14.7 m	10.3 m	14.7 m	
↔	411/22	13.9 m	12.0 m	13.9 m	
↔	411/24	14.8 m	11.2 m	14.8 m	
↔	411/26	14.9 m	08.7 m	14.9 m	
UP ↑	411/25	08.7 m		UP ↑	

Orc - 
Quad - 

04-18-22
5541717m

JAI-BSQP Telecomable Route Diagram

Block Section - MNP-BSQP (Length - 6.36 KM)

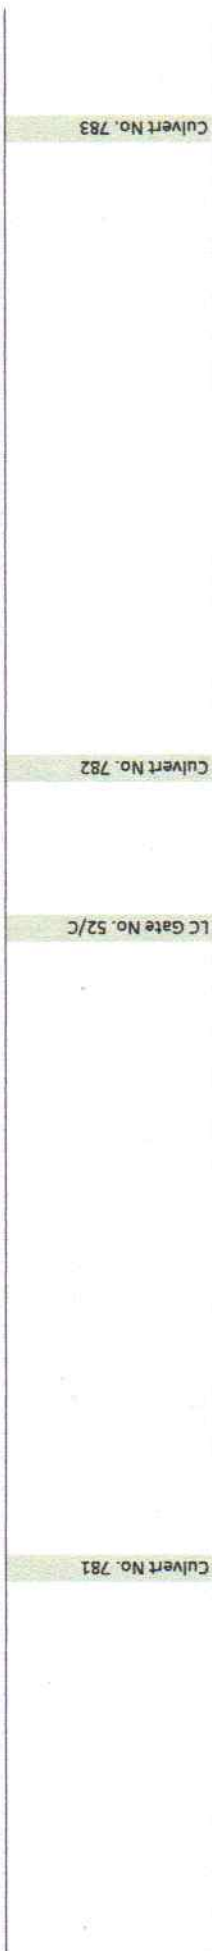


OFC - —
 Quad - —

5/10/23
 5/17/23
 5/17/23


Block Section - BFM-MNP (Length - 4.9 KM)

Block Section - MNP-BSQP (Length - 6.36 KM)

SSP/MNP

LC Gate No. 51/C

MNP Panel / OFC Repa

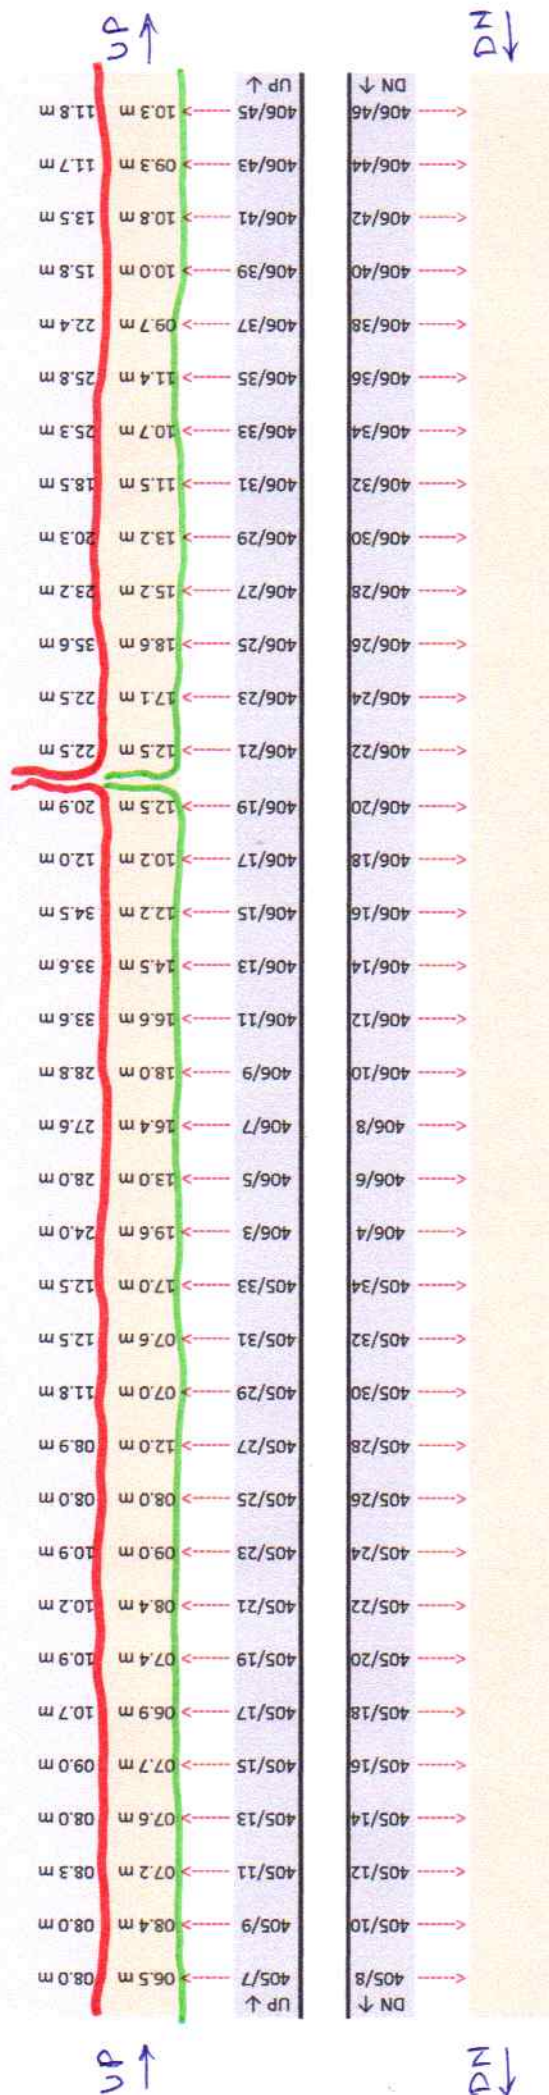

Orc - 

5561711
00/03/20
A

JAI-BSQP Telecomable Route Diagram

Block Section - BFM-MNP (Length - 4.9 KM)

Culvert Mankijor
LC Gate No. 50/C
Basuachak Halt
Culvert
Culvert No. 775

UP ↑

402/25	12.4 m	12.5 m	UP ↓
402/26	12.7 m	12.7 m	
402/27	11.7 m	12.0 m	
403/1	14.9 m	14.9 m	
403/2	14.5 m	14.5 m	
403/3	13.1 m	13.3 m	
403/4	13.1 m	13.1 m	
403/5	12.9 m	12.9 m	
403/6	12.6 m	12.6 m	
403/7	10.7 m	10.7 m	
403/8	10.3 m	10.3 m	
403/9	10.3 m	10.3 m	
403/10	13.1 m	13.1 m	
403/11	13.0 m	13.0 m	
403/12	13.5 m	13.5 m	
403/13	11.2 m	11.2 m	
403/14	10.9 m	10.9 m	
403/15	09.1 m	09.1 m	
403/16	08.3 m	08.3 m	
403/17	06.2 m	06.2 m	
403/18	05.5 m	05.5 m	
403/19	07.9 m	07.9 m	
403/20	09.7 m	09.7 m	
403/21	11.0 m	11.0 m	
403/22	10.5 m	10.5 m	
403/23	10.7 m	10.7 m	
403/24	09.6 m	09.6 m	
403/25	08.9 m	08.9 m	
403/26	08.9 m	08.9 m	
403/27	09.2 m	09.2 m	
403/28	08.5 m	08.5 m	
403/29	08.5 m	08.5 m	
403/30	07.9 m	07.9 m	
403/31	07.9 m	07.9 m	
403/32	08.8 m	08.8 m	
404/1	09.0 m	09.0 m	
404/2	08.5 m	08.5 m	
404/3	08.5 m	08.5 m	
404/4	09.2 m	09.2 m	
404/5	08.5 m	08.5 m	
404/6	08.5 m	08.5 m	
404/7	09.9 m	09.9 m	
404/8	11.0 m	11.0 m	
404/9	10.2 m	10.2 m	
404/10	08.5 m	08.5 m	
404/11	09.0 m	09.0 m	
404/12	08.5 m	08.5 m	
404/13	09.1 m	09.1 m	
404/14	09.2 m	09.2 m	
404/15	08.2 m	08.2 m	
404/16	08.4 m	08.4 m	
404/17	08.5 m	08.5 m	
404/18	08.2 m	08.2 m	
404/19	09.5 m	09.5 m	
404/20	08.2 m	08.2 m	
404/21	08.4 m	08.4 m	
404/22	09.2 m	09.2 m	
404/23	08.2 m	08.2 m	
404/24	08.4 m	08.4 m	
404/25	09.0 m	09.0 m	
404/26	08.2 m	08.2 m	
404/27	07.6 m	07.6 m	
404/28	08.5 m	08.5 m	
404/29	08.9 m	08.9 m	

UP ↓

DN ↓


DN ↓

OFC - 
Quadr - 

5/16/2022
SCEIT/178

JAJ-BSQP Telecom-cable Route Diagram

Block Section - JMU-BFM (Length - 9.07 KM)

Block Section - BFM-MNP (Length - 4.9 KM)



UP ↑	400/17	10.9 m	400/18	DN ↓
	400/19	10.2 m	400/20	
	400/21	10.2 m	400/22	
	400/23	15.2 m	400/24	
	400/25	14.1 m	400/26	
	400/27	13.5 m	400/28	
	400/29	14.0 m	400/30	
401/1	13.5 m	401/2		
401/3	11.3 m	401/4		
401/5	17.1 m	401/6		
401/7	17.0 m	401/8		
401/9	16.5 m	401/10		
401/11	17.1 m	401/12		
401/13	18.9 m	401/14		
401/15	20.2 m	401/16		
401/17	15.5 m	401/18		
401/19	11.0 m	401/20		
401/21	11.0 m	401/22		
401/23	17.1 m	401/24		
401/25	16.3 m	401/26		
401/27	10.2 m	401/28		
401/29	12.5 m	401/30		
401/31	22.3 m	401/32		
401/33	10.5 m	401/34		
402/1	21.7 m	402/2		
402/3	20.5 m	402/4		
402/5	21.6 m	402/6		
402/7	25.0 m	402/8		
402/9	23.5 m	402/10		
402/11	13.8 m	402/12		
402/13	12.9 m	402/14		
402/15	12.7 m	402/16		
402/17	11.8 m	402/18		
402/19	12.8 m	402/20		
402/21	11.6 m	402/22		
402/23	12.6 m	402/24		
UP ↑				DN ↓

04/05/23
SCE/17/574

OFC -
Quad -

JAI-BSQP Telecommable Route Diagram

Block Section - JMU-BFM (Length - 9.07 KM)

↑ 5

↑ 5

UP ↓	398/5	→
→	398/7	←
→	398/9	←
→	398/11	←
→	398/13	←
→	398/15	←
→	398/17	←
→	398/19	←
→	398/21	←
→	398/23	←
→	398/25	←
→	398/27	←
→	398/29	←
→	399/1	←
→	399/3	←
→	399/5	←
→	399/7	←
→	399/9	←
→	399/11	←
→	399/13	←
→	399/15	←
→	399/17	←
→	399/19	←
→	399/21	←
→	399/23	←
→	399/25	←
→	399/27	←
→	399/29	←
→	400/1	←
→	400/3	←
→	400/5	←
→	400/7	←
→	400/9	←
→	400/11	←
→	400/13	←
→	400/15	←
UP ↓	400/16	←

↓ 2

↓ 2

DN ↓	398/6	→
→	398/8	←
→	398/10	←
→	398/12	←
→	398/14	←
→	398/16	←
→	398/18	←
→	398/20	←
→	398/22	←
→	398/24	←
→	398/26	←
→	398/28	←
→	398/30	←
→	399/2	←
→	399/4	←
→	399/6	←
→	399/8	←
→	399/10	←
→	399/12	←
→	399/14	←
→	399/16	←
→	399/18	←
→	399/20	←
→	399/22	←
→	399/24	←
→	399/26	←
→	399/28	←
→	399/30	←
→	400/2	←
→	400/4	←
→	400/6	←
→	400/8	←
→	400/10	←
→	400/12	←
→	400/14	←
→	400/16	←
→	07.9 m	←
→	PCC	←

54.06/12.2
54.06/12.2

Ofc -

Quad -

JAI-BSQP Telecom cable Route Diagram

Block Section - JMU-BFM (Length - 9.07 KM)

15 ↑

UP ↑	395/19	395/21	395/23	395/25	395/27	396/1	396/3	396/5	396/7	396/9	396/11	396/13	396/15	396/17	396/19	396/21	396/23	396/25	396/27	396/29	397/1	397/3	397/5	397/7	397/9	397/11	397/13	397/15	397/17	397/19	397/21	397/23	397/25	397/27	398/1	398/3	UP ↑
------	--------	--------	--------	--------	--------	-------	-------	-------	-------	-------	--------	--------	--------	--------	--------	--------	--------	--------	--------	--------	-------	-------	-------	-------	-------	--------	--------	--------	--------	--------	--------	--------	--------	--------	-------	-------	------

15 ↑

12 ↓

DN ↓	395/20	395/22	395/24	395/26	395/28	396/2	396/4	396/6	396/8	396/10	396/12	396/14	396/16	396/18	396/20	396/22	396/24	396/26	396/28	396/30	397/2	397/4	397/6	397/8	397/10	397/12	397/14	397/16	397/18	397/20	397/22	397/24	397/26	397/28	398/2	398/4	DN ↓
------	--------	--------	--------	--------	--------	-------	-------	-------	-------	--------	--------	--------	--------	--------	--------	--------	--------	--------	--------	--------	-------	-------	-------	-------	--------	--------	--------	--------	--------	--------	--------	--------	--------	--------	-------	-------	------

12 ↓


04/05/23
SKEITLM

OFC -

Quad -


JAJ-BSQP Telecommable Route Diagram

Block Section - JMU-BFM (Length - 9.07 KM)

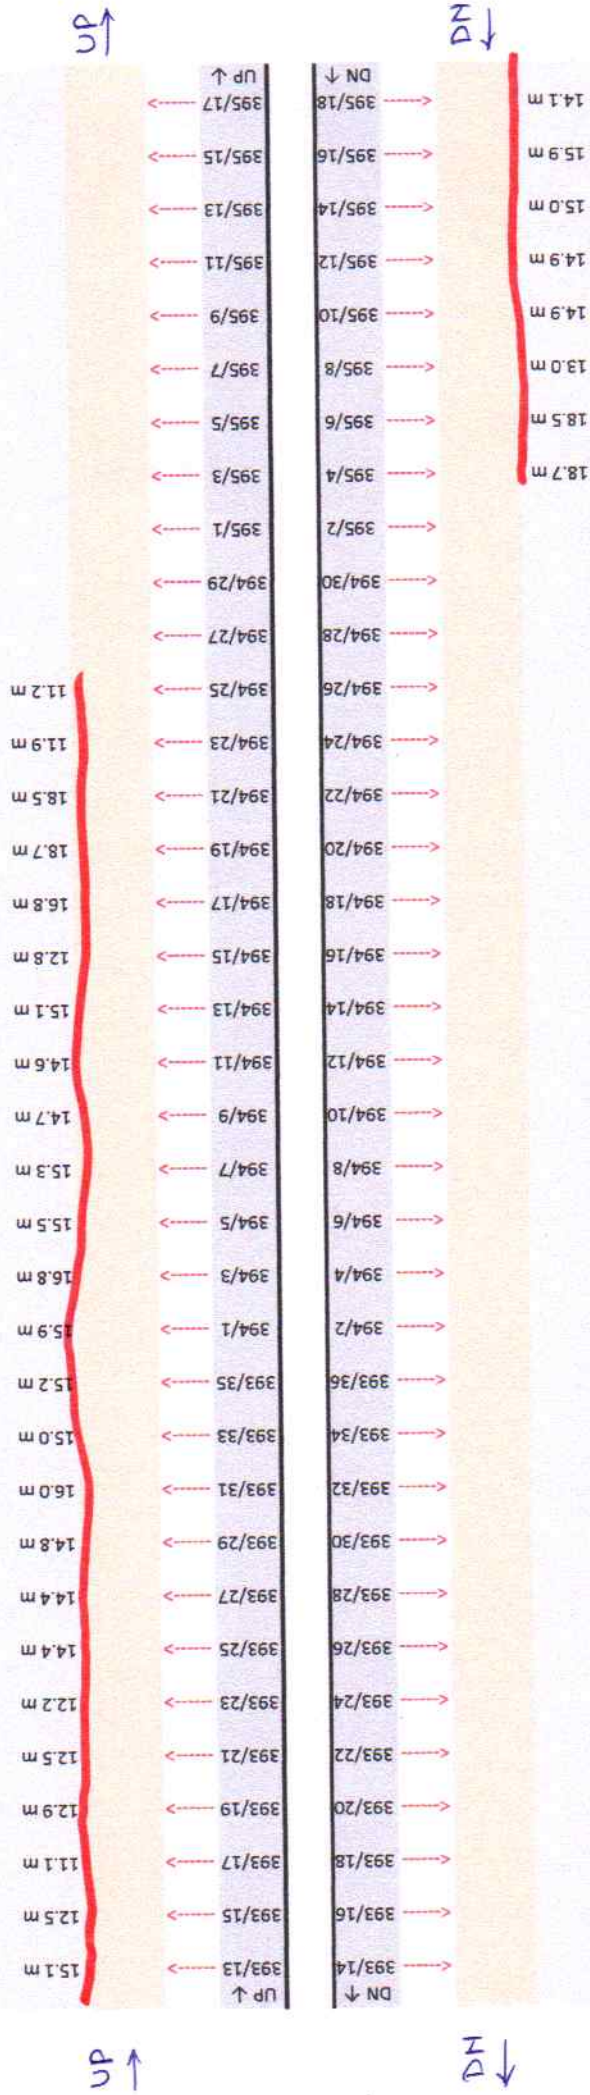

JAI-BSQP Telecomable Route Diagram

Block Section - CUX-JMU (Length - 8.02 KM)

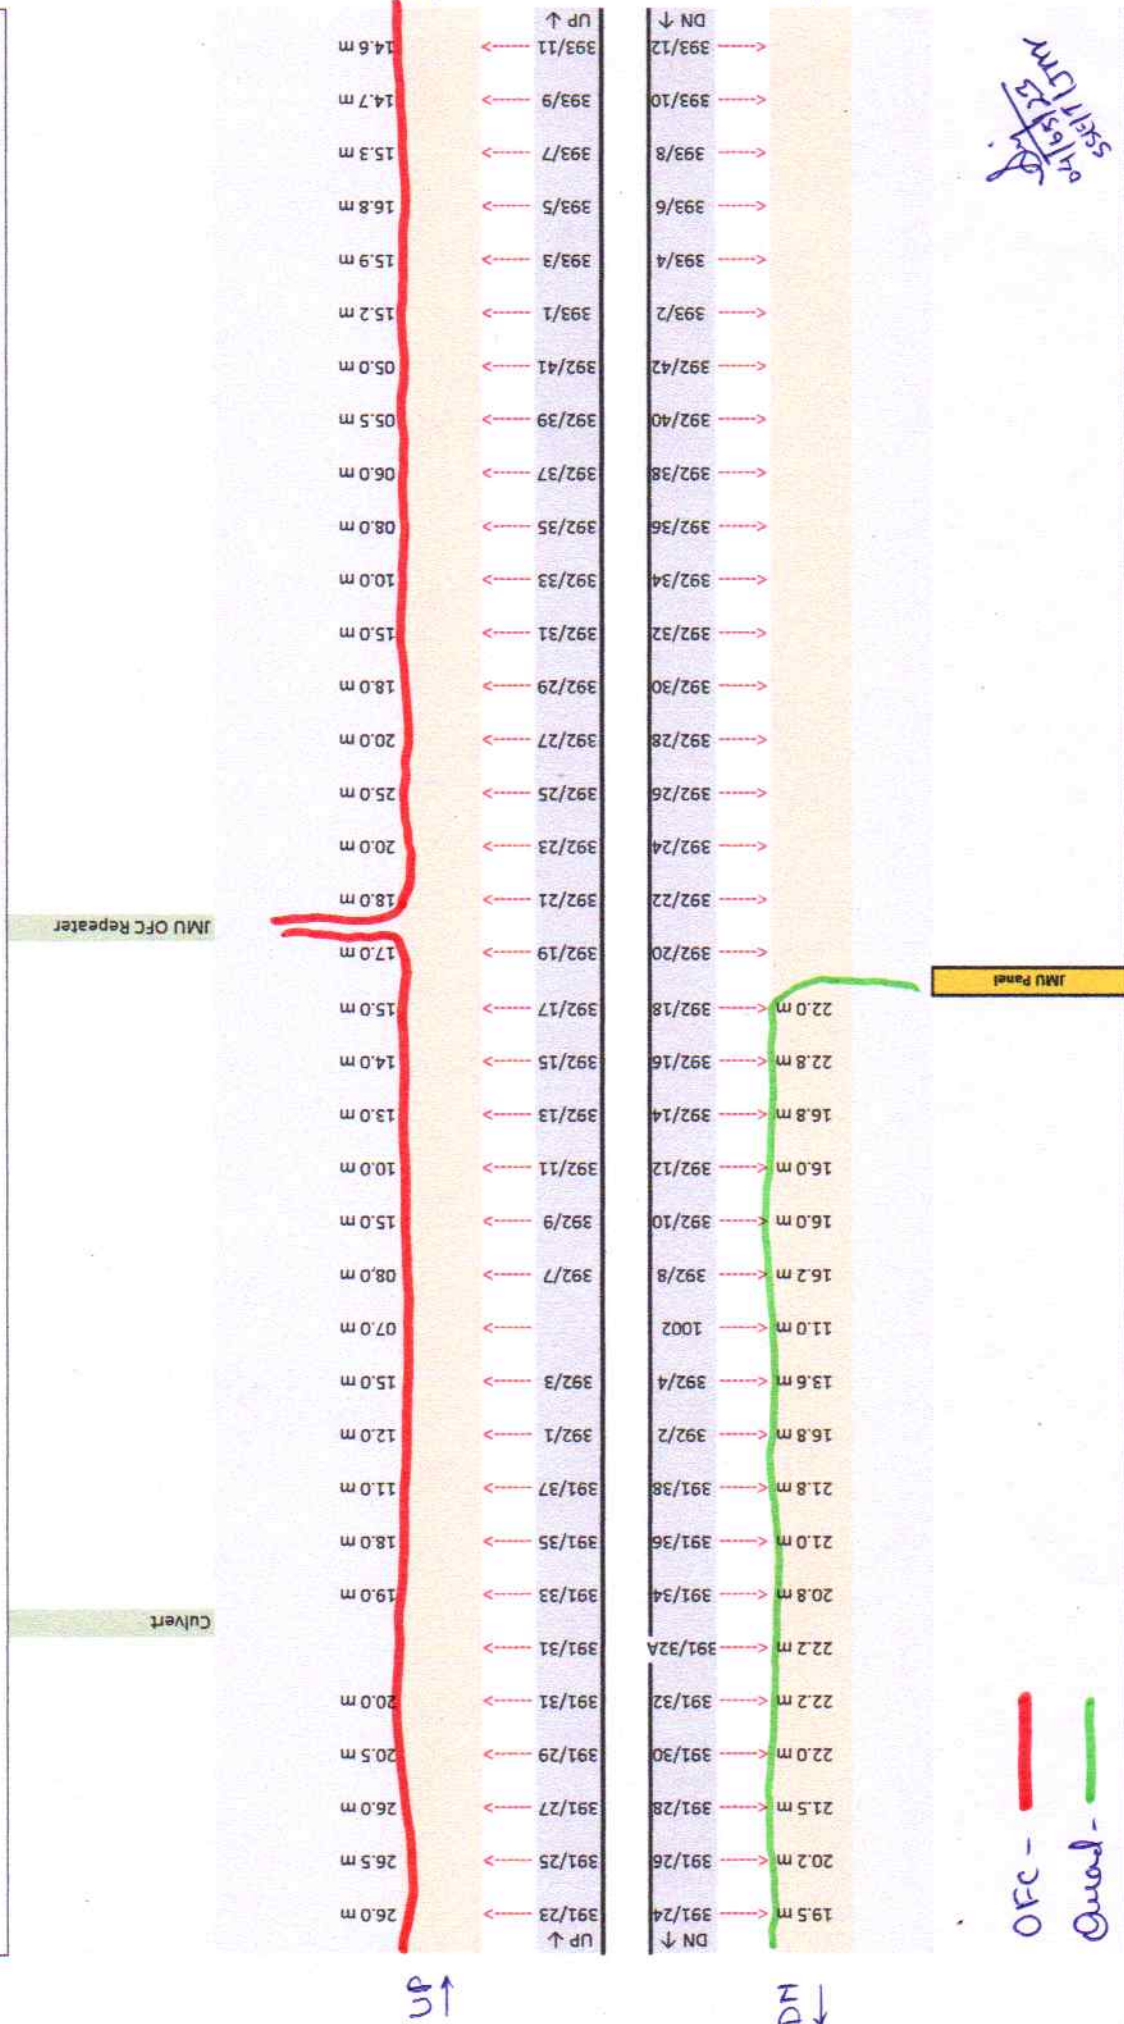

JAI-BSQP Telecom Cable Route Diagram


Block Section - CUX-JMU (Length - 8.02 KM)

Bridge No. 745, Alan Riv

Culvert

Culvert No. 743

LC Gate No. 45/C

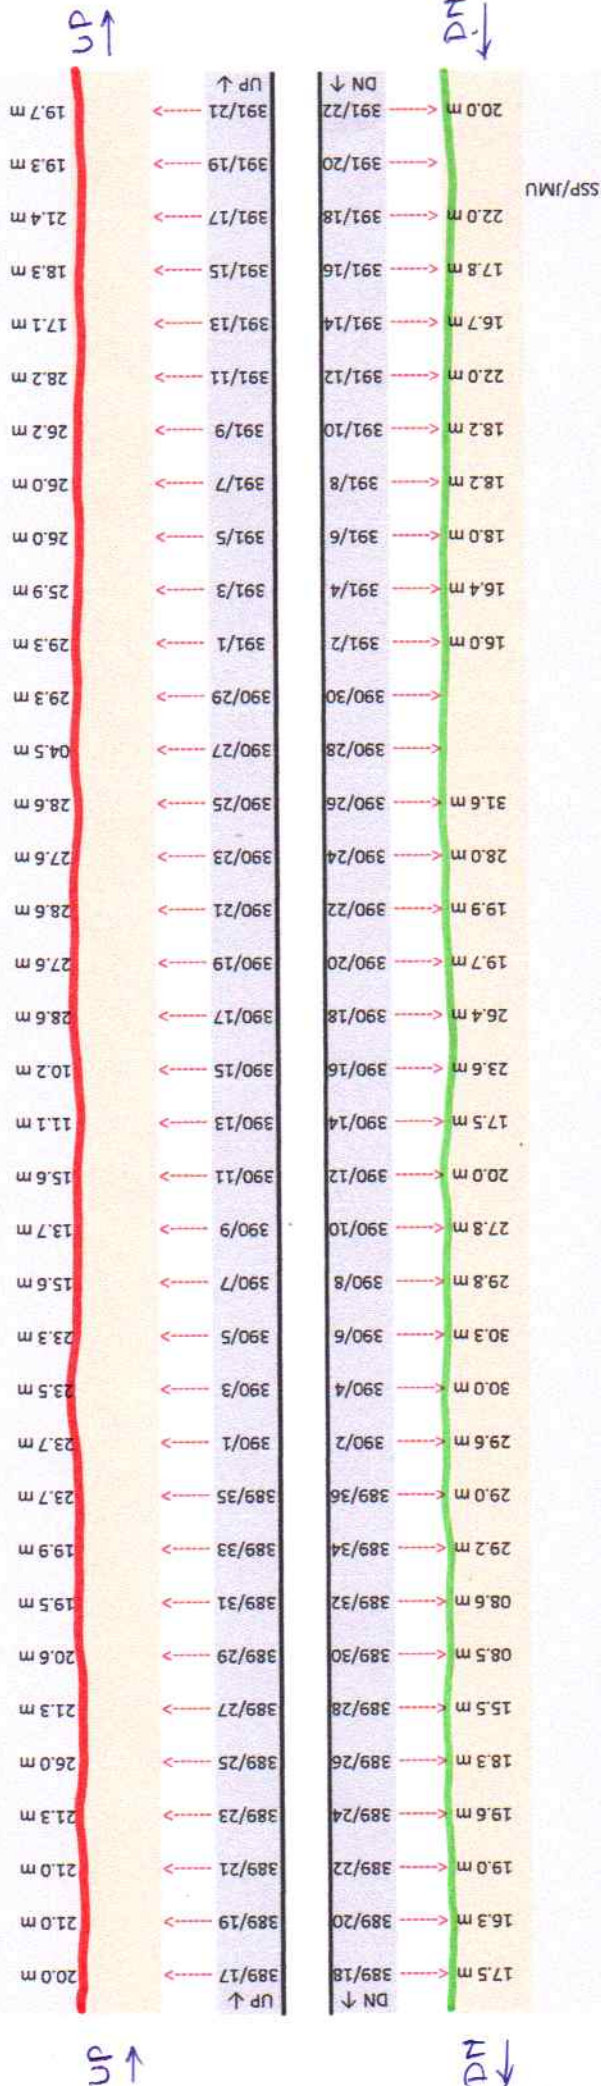

OFC - —
Quad - —




5.5/6/11/12/13/2337/2338

Block Section - CUX-JMU (Length - 8.02 KM)

Culvert No. 742

Culvert No. 741

Culvert

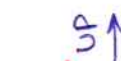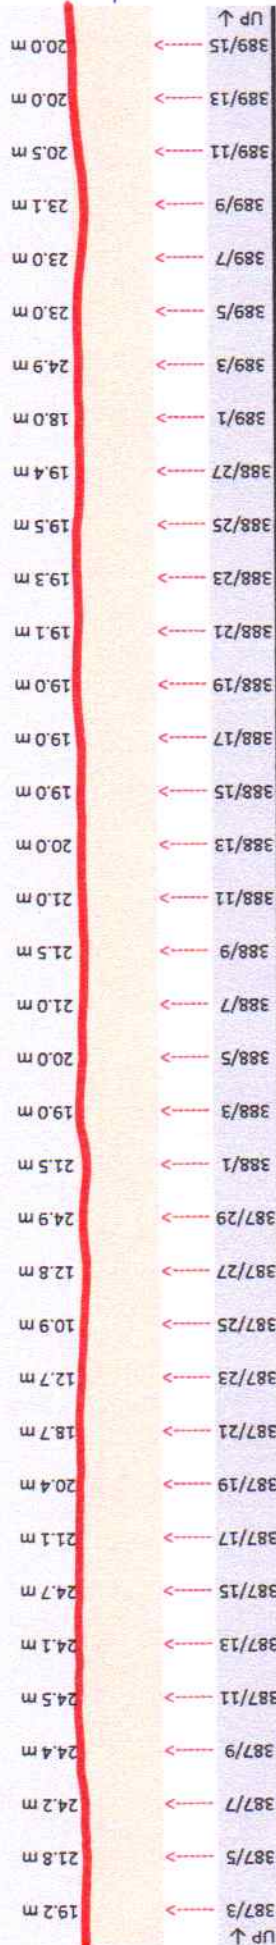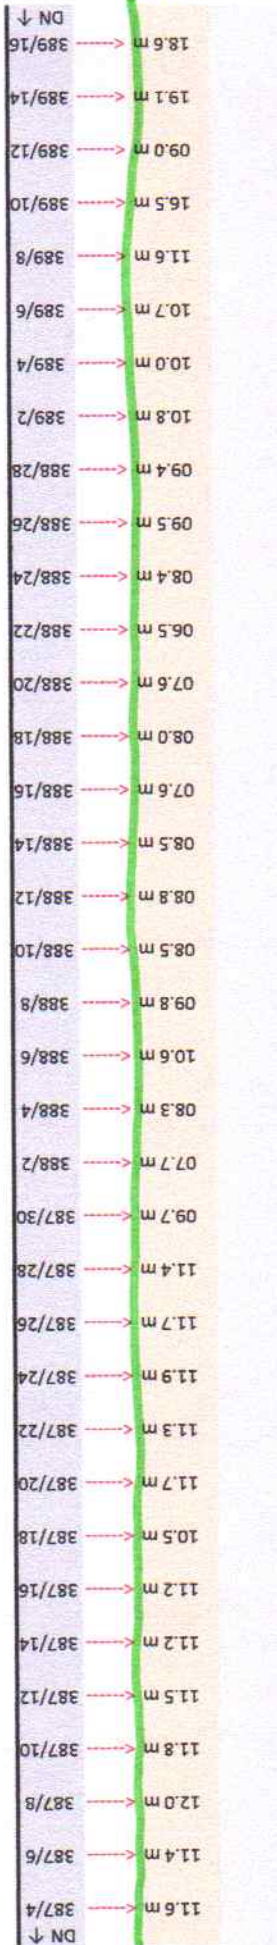

off -

Quoted -

6/16/22
5:47 PM
[Signature]

JAI-BSQP Telecommunication Route Diagram


Block Section - CUX-JMU (Length - 8.02 KM)

LC Gate 44/C

Culvert No. 738

Culvert No. 737

Culvert No. 736

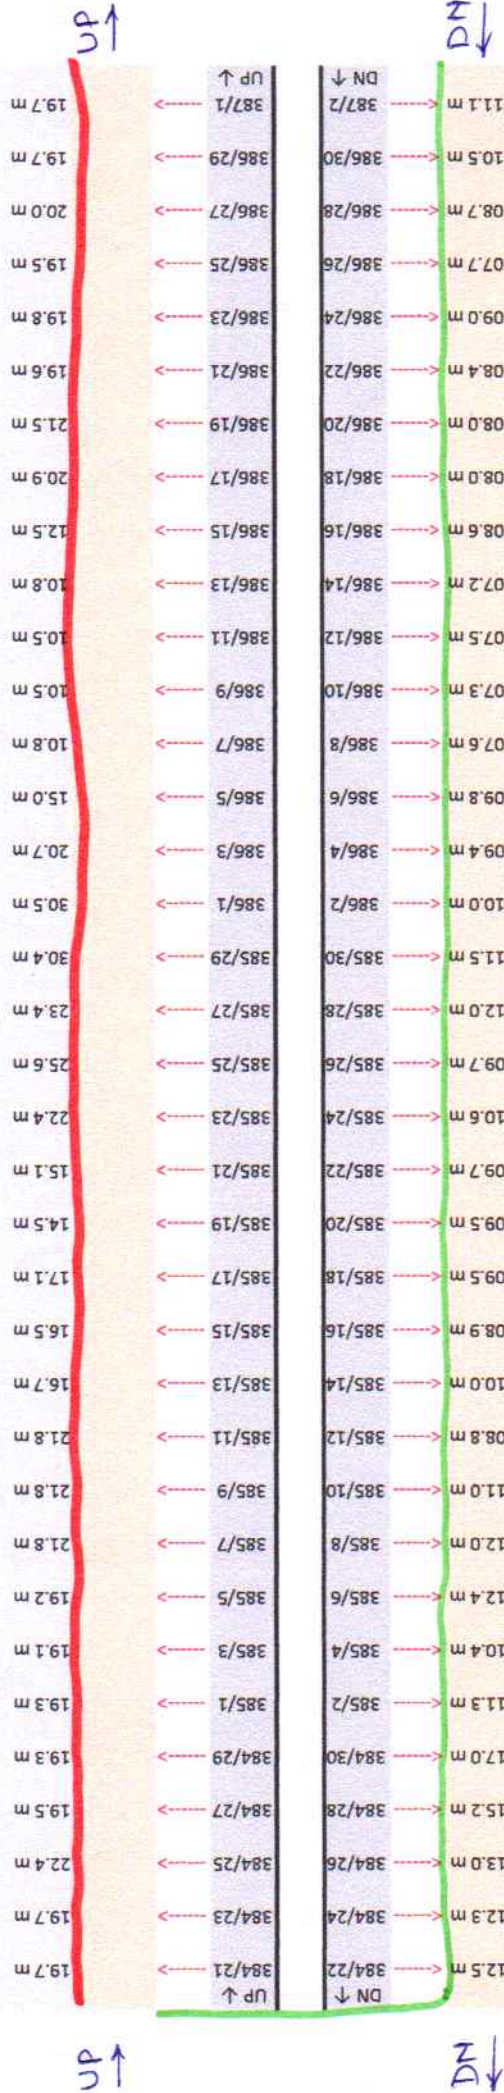

OFC - —
Quad - —


04/09/23
55:17:50

JAI-BSQP Telecom Cable Route Diagram

Block Section - GHR-CUX (Length - 6.55 KM)

CUX Panel / OFC Repeat

LC Gate 43/C

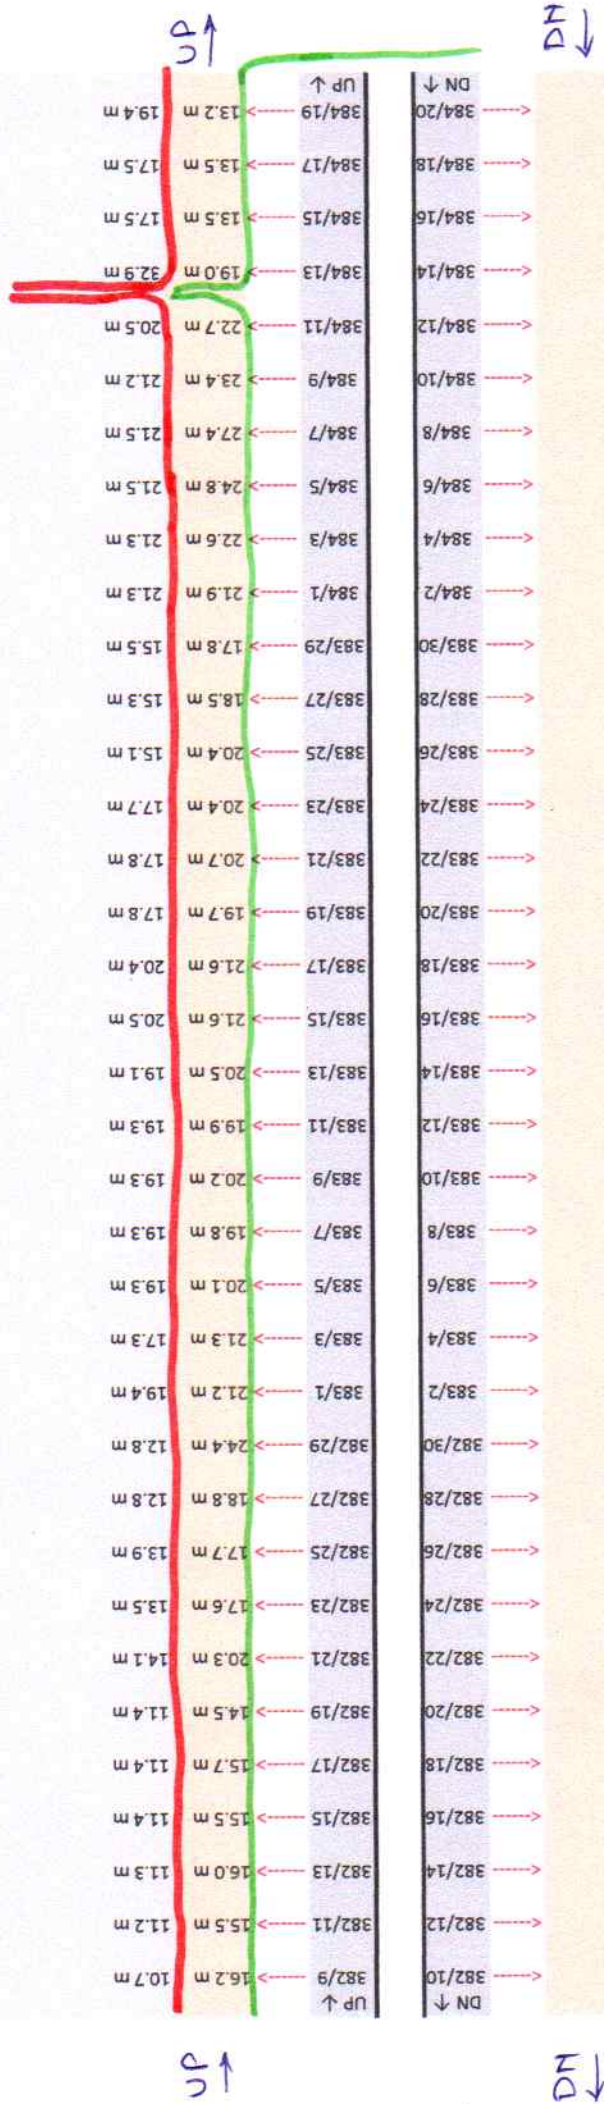

OFC - Red line
Quad - Green line

04/10/23
SCE/11/11/11

JAI-BSQP Telecomable Route Diagram

Block Section - GHR-CUX (Length - 6.55 KM)

Culvert

Culvert No. 731

Culvert No. 730

UP ↑	379/23	12.0 m	16.9 m	12.0 m	12.1 m	12.1 m	14.7 m	15.1 m	14.8 m	11.7 m	11.7 m	14.5 m	10.4 m	18.7 m	17.2 m	11.4 m	12.4 m	14.8 m	15.0 m	18.1 m	18.6 m	21.7 m	19.7 m	18.0 m	11.7 m	17.6 m	12.5 m	16.1 m	15.3 m	12.4 m	13.8 m	13.8 m	17.1 m	15.1 m	15.9 m	12.7 m	16.6 m	11.4 m	12.7 m	381/23	15.6 m	381/25	15.5 m	16.3 m	381/27	11.4 m	17.7 m	382/1	19.2 m	17.5 m	13.3 m	11.2 m	16.6 m	382/7	11.4 m	UP ↑
------	--------	--------	-------	--------	--------	--------	--------	--------	-------	--------	------

DN ↓	379/24	12.0 m	379/26	12.0 m	379/28	12.1 m	380/2	11.4 m	380/3	11.4 m	380/5	09.9 m	380/7	12.1 m	380/9	12.1 m	380/11	11.7 m	380/13	11.7 m	380/15	10.4 m	380/17	11.7 m	380/19	11.4 m	380/21	12.4 m	380/23	14.8 m	380/25	18.1 m	380/27	18.6 m	380/29	17.5 m	381/1	12.1 m	381/3	11.7 m	381/5	11.7 m	381/7	12.5 m	381/9	12.4 m	381/11	13.8 m	381/13	13.8 m	381/15	12.7 m	381/17	12.7 m	381/19	16.6 m	381/21	14.8 m	381/23	15.6 m	381/25	15.5 m	381/27	11.4 m	382/1	17.7 m	382/3	13.3 m	382/5	11.2 m	382/7	11.4 m	DN ↓
------	--------	--------	--------	--------	--------	--------	-------	--------	-------	--------	-------	--------	-------	--------	-------	--------	--------	-------	--------	-------	--------	-------	--------	-------	--------	-------	--------	--------	--------	--------	--------	--------	--------	--------	--------	--------	--------	--------	--------	--------	--------	--------	--------	--------	--------	-------	--------	-------	--------	-------	--------	-------	--------	------

OFC - —
 Quad - —

5.5/15/17/23/25/27/4483/448

JAI-BSQP Telecom'able Route Diagram

Block Section - GHR-CUX (Length - 6.55 KM)



UP ↑	377/21	14.4 m	15.0 m	UP ↑	379/21	16.6 m	12.0 m
377/29	21.6 m	80.0 m	377/27	19.9 m	80.0 m	379/19	15.6 m
377/25	19.2 m	22.0 m	377/23	16.0 m	18.0 m	379/17	14.5 m

JAI-BSQP Telecomfable Route Diagram


Block Section - DPX-GHR (Length - 4.29 KM)

SSP GHR

Culvert No. 727

Culvert

LC Gate 41/C

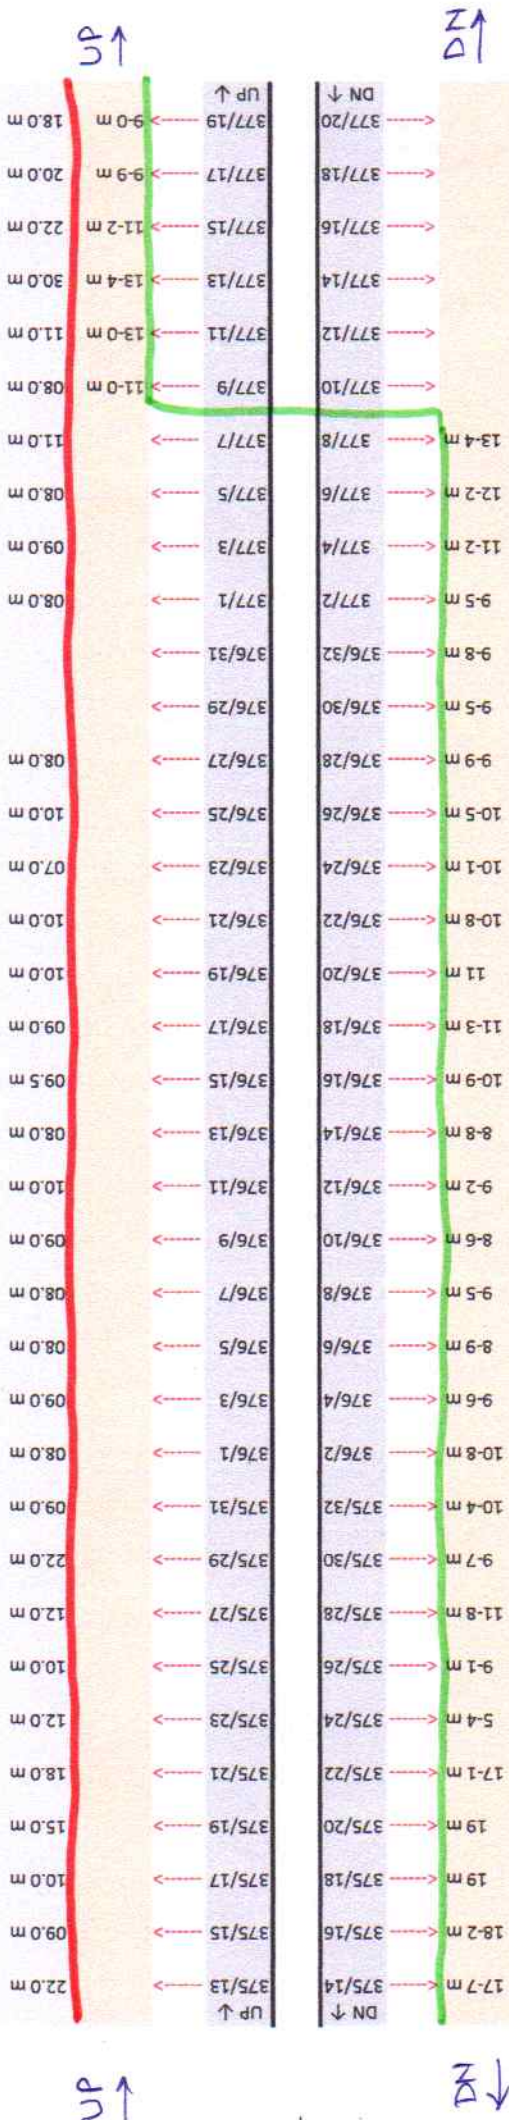

OFC - —
 Guard - —

64/10/23
 5.4/17.7m

JAI-BSQP Telecom Cable Route Diagram

Block Section - JAI-DPX

Block Section - DPX-GHR (Length - 4.29 KM)



UP ↑	373/1	19.0 m	373/3	18.0 m	373/5	18.0 m	373/7	17.0 m	373/9	15.0 m	373/11	19.0 m	373/13	18.0 m	373/15	15.0 m	373/17	18.0 m	373/19	15.0 m	373/21	11.0 m	373/23	23.0 m	373/25	10.0 m	373/27	10.0 m	373/29	10.0 m	374/1	10.0 m	374/3	11.0 m	374/5	10.0 m	374/7	12.0 m	374/9	13.0 m	374/11	15.0 m	374/13	10.0 m	374/15	12.0 m	374/17	14.0 m	374/19	15.0 m	374/21	13.0 m	374/23	12.0 m	374/25	23.0 m	374/27	24.0 m	374/29	23.0 m	375/1	25.0 m	375/3	23.0 m	375/5	21.0 m	375/7	23.0 m	375/9	25.0 m	375/11	23.0 m	UP ↑
DN ↓	373/2	24.7 m	373/4	20.2 m	373/6	20.7 m	373/8	20.0 m	373/10	16.3 m	373/12	18.3 m	373/14	17.8 m	373/16	29.4 m	373/18	27.0 m	373/20	29.3 m	373/22	18 m	373/24	16.6 m	373/26	14.8 m	373/28	15.7 m	373/30	15 m	374/2	14.4 m	374/4	15.2 m	374/6	14.8 m	374/8	15.6 m	374/10	17 m	374/12	18.7 m	374/14	18 m	374/16	18.5 m	374/18	16.9 m	374/20	16.2 m	374/22	15.2 m	374/24	15.3 m	374/26	15.6 m	374/28	19.2 m	374/30	19.7 m	375/2	19.6 m	375/4	20.8 m	375/6	19.5 m	375/8	17.7 m	375/10	12.7 m	375/12	16.4 m	DN ↓

OFC - —

Quad - —

04/08/2023
SCEH LMF

JAI-BSQP Telecom Cable Route Diagram

Block Section - JAI-DPX (Length - 7.14 KM)

Culvert 718

Nagi Bridge No. 717

Culvert No. 716

5 ↑

18.0 m	372/33	UP ↑
18.0 m	372/31	
19.0 m	372/29	
20.0 m	372/27	
20.0 m	372/25	
20.0 m	372/23	
18.0 m	372/21	
15.0 m	372/19	
10.0 m	372/17	
09.0 m	372/15	
11.0 m	372/13	
09.0 m	372/11	
11.0 m	372/9	
20.0 m	372/7	
20.0 m	372/5	
22.0 m	372/3	
21.0 m	372/1	
30.0 m	371/31	
26.0 m	371/29	
20.0 m	371/27	
18.0 m	371/25	
20.0 m	371/23	
23.0 m	371/21	
28.0 m	371/19	
23.0 m	371/17	
22.0 m	371/15	
21.0 m	371/13	
23.0 m	371/11	
22.0 m	371/9	
21.0 m	371/7	
23.0 m	371/5	
19.0 m	371/3	
19.0 m	371/1	
21.0 m	370/29	
18.0 m	370/27	
15.0 m	370/25	UP ↑

2 ↑

17.9 m	372/34	DN ↓
19.0 m	372/32	
16.0 m	372/30	
16.0 m	372/28	
18.2 m	372/26	
17.0 m	372/24	
17.0 m	372/22	
19.3 m	372/20	
20.8 m	372/18	
21.6 m	372/16	
29.5 m	372/14	
20.6 m	372/12	
13.0 m	372/10	
20.0 m	372/8	
24.3 m	372/6	
26.6 m	372/4	
21.7 m	372/2	
24.7 m	371/32	
23.4 m	371/30	
27.4 m	371/28	
25.5 m	371/26	
26.1 m	371/24	
26.9 m	371/22	
29.5 m	371/20	
30.5 m	371/18	
27.9 m	371/16	
28.0 m	371/14	
25.4 m	371/12	
18.8 m	371/10	
21.8 m	371/8	
24.7 m	371/6	
23.3 m	371/4	
23.6 m	371/2	
19.8 m	370/30	
15.7 m	370/28	
15.1 m	370/26	DN ↓

5.04/15/17/19/4169/

Block Section - JAJ-DPX (Length - 7.14 KM)

LC Gate 38/C

59 ↑

$\downarrow$
Z

Quand -

05/15/2017

JAI-BSQP Telecom-able Route Diagram

Block Section - JAI-DPX (Length - 7.14 KM)

Culvert No. 711

OFC/RCL Repeater
RRU/IAI

OFC Dist.	6 Q Dist.	UP ↑	DN ↓	6 Q Dist.	OFC Dist.
WLI/20 - 56.0 m	366/13	366/15	366/14	88.5 m	
WLI/21 - 10.0 m	366/17	366/18	366/16	95.0 m	
WLI/22 - 09.0 m	366/21	366/22	366/24	105.0 m	
WLI/23 - 10.0 m	366/23	366/25	366/26	36.0 m	
WLI/24 - 11.0 m	366/27	366/28	366/29	37.5 m	
WLI/25 - 05.0 m	366/29	366/31	366/32	15.6 m	
WLI/26 - 07.0 m	366/33	366/35	366/36	09.7 m	
