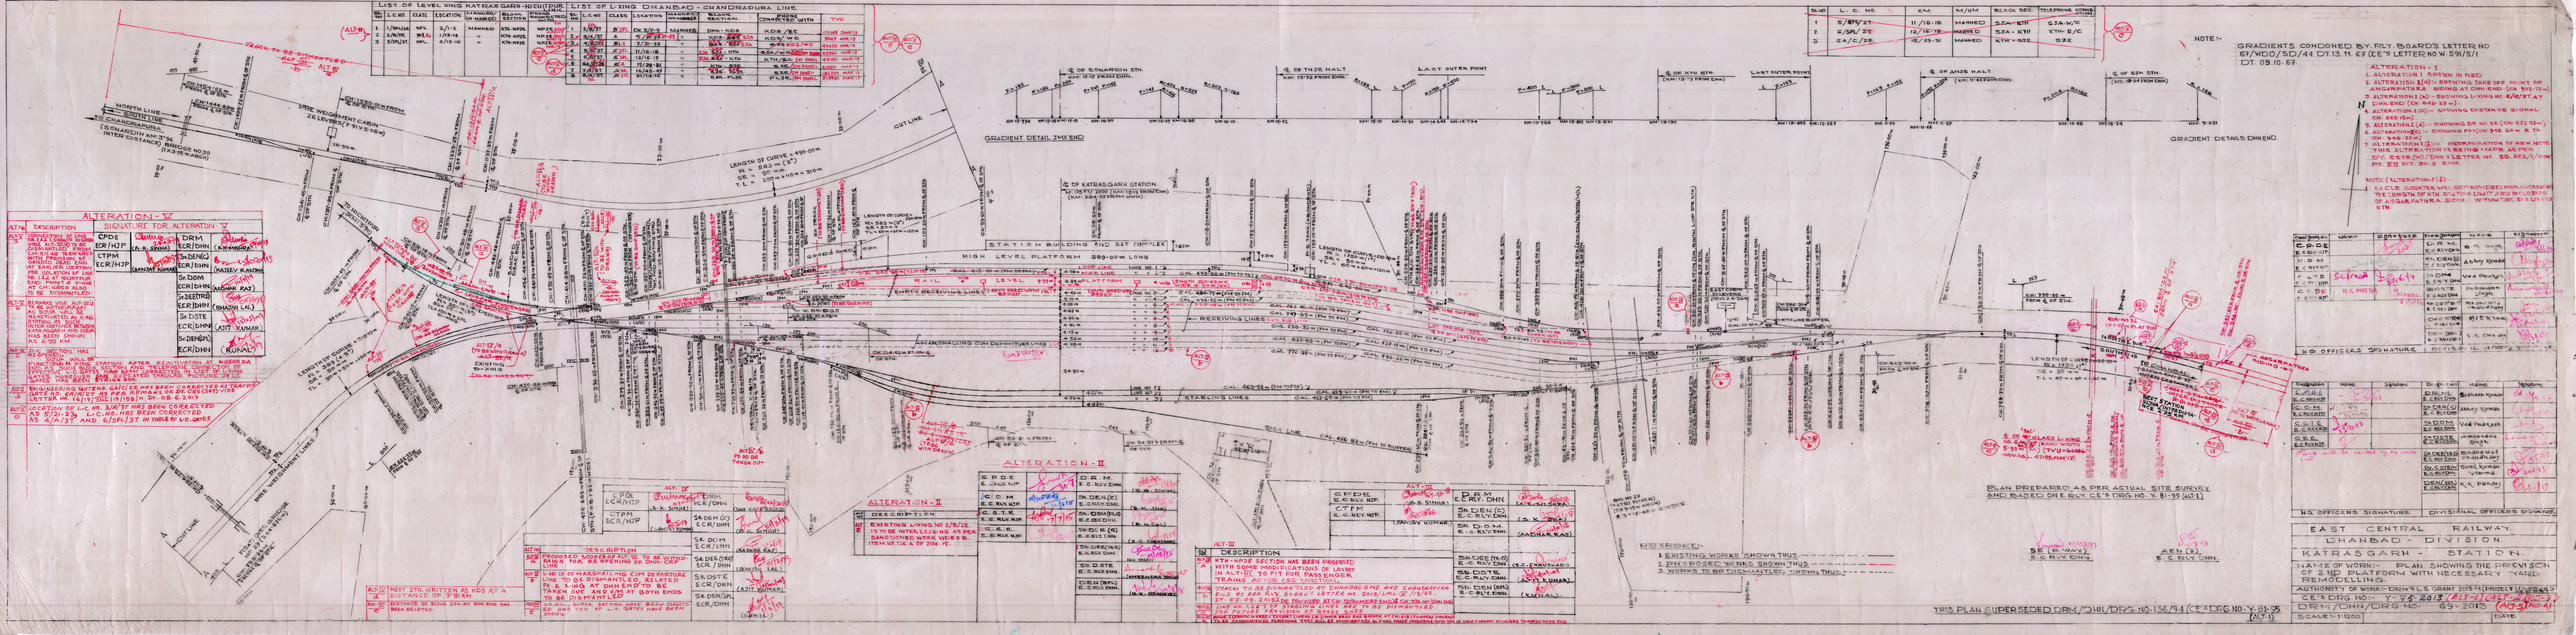
ALTERATION - V
ALTERATION - II
ALTERATION - I
NOTE :-
GRADIENTS CONDONED BY RLY BOARD'S LETTER NO 67/WCO/SC/44 DT 13.11.67 (CE'S LETTER NO W. 59/5/1 DT 09.10.67
ALTERATION - I.
1. ALTERATION I SHOWN IN RED
2. ALTERATION II (A) = SHOWING TAKE OFF POINT OF ANGA PATHRA SIDING AT DMH END. (CR. 951-72)
3. ALTERATION (B) = SHOWING LYING NO 6/6/1 AT DMH END (CR. 648-73 Sk).
4. ALTERATION (C) = SHOWING STARTER SIGNAL (CR. 865-69)
5. ALTERATION (D) = SHOWING BR NO 26 (CR. 872-69)
6. ALTERATION (E) = SHOWING PATCH (NO 342-69 & TS CR. 348-71 Sk)
7. ALTERATION (F) = INCORPORATION OF NEW NOTE. THIS ALTERATION IS BASED MAPS AS PER D/C. E. STR. (W) / DHN'S LETTER NO SG. 662/1/COM PT XII DT. 30.10.73
NOTE (ALTERATION - F) :-
A SICLE COUNTER WILL BE PROVIDED FOR INDICATING THE LENGTH OF THE STATION UNIT AND INCLUSION OF ANGA PATHRA SIDING WITHIN THIS STATION UNIT.
GRADIENT DETAIL JMK END
GRADIENT DETAILS DRN END
STATION BUILDING AND SET COMPLEX
HIGH LEVEL PLATFORM 380-00m LONG
RECEIVING LINES
STABLING LINES
LOOP LINE
GOODS SHED
PLAN PREPARED AS PER ACTUAL SITE SURVEY AND BASED ON E. RLY. CE'S DRG NO. Y. 81-35 (ALT-I)
REFERENCE :-
1. EXISTING WORKS SHOWN THUS ———
2. PROPOSED WORKS SHOWN THUS ———
3. WORKS TO BE DISMANTLED SHOWN THUS - - - - -
THIS PLAN SUPERSEDED DRM/DHN/DRG NO-136/94 (CE'S DRG NO-Y-81-35 (ALT-I)
EAST CENTRAL RAILWAY
DHANBAD - DIVISION.
KATRASGARH - STATION.
NAME OF WORK :- PLAN SHOWING THE PROVISION OF 2 ND PLATFORM WITH NECESSARY YARD REMODELLING.
DRM/DHN/DRG NO:- 69-2015 (ALT-I) (ALT-II)
SCALE :- 1:1250
DATE.