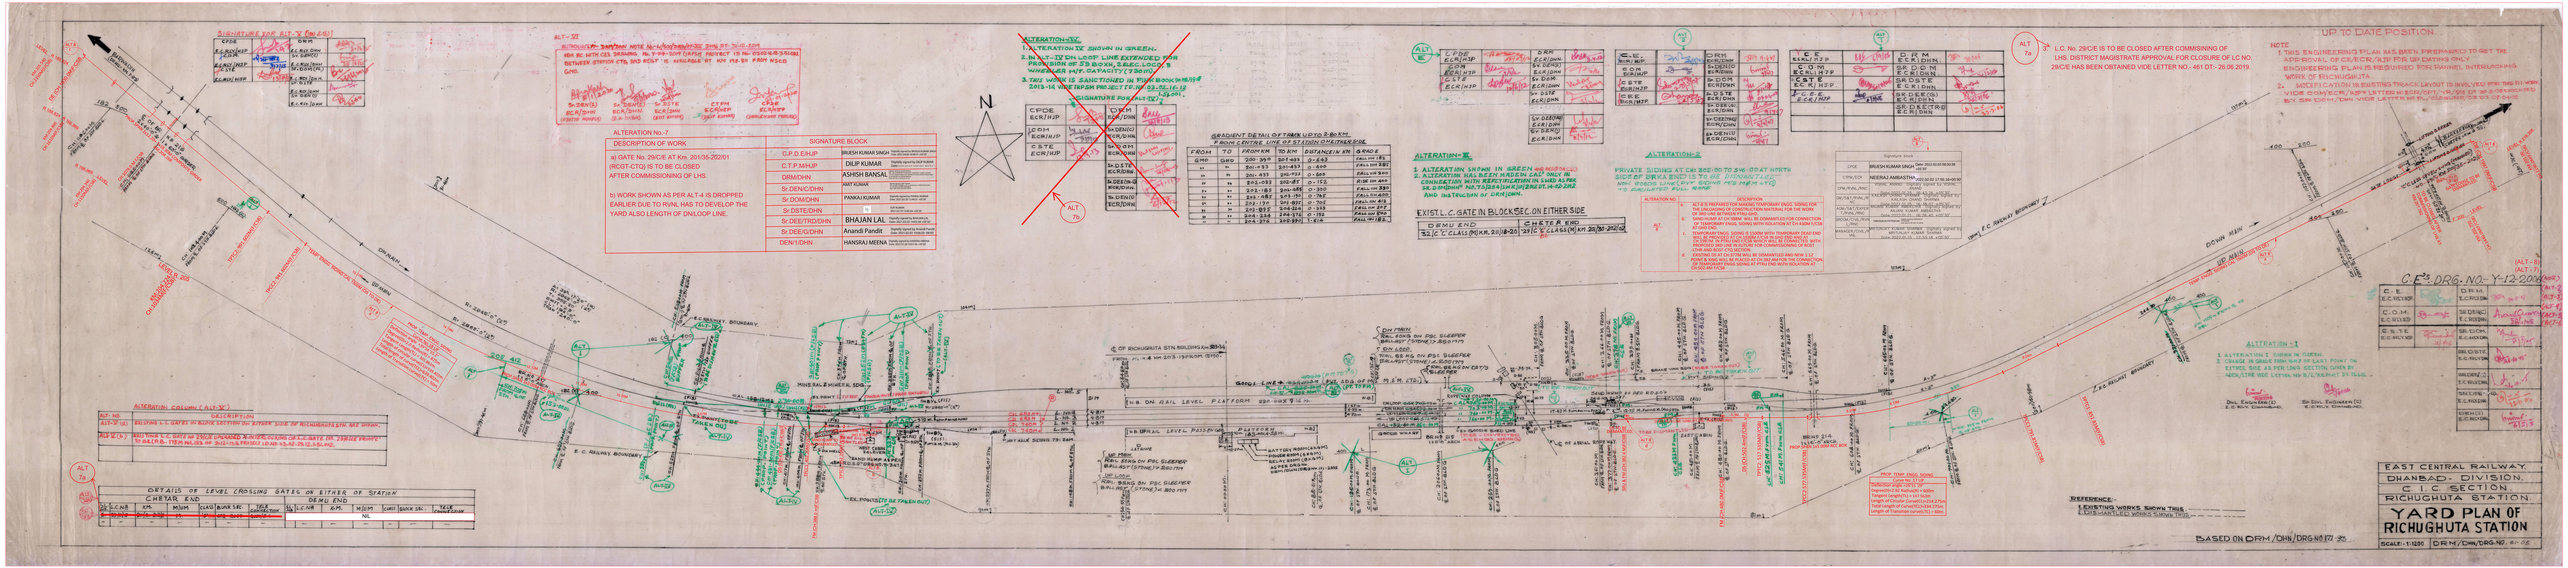
EAST CENTRAL RAILWAY
DHANBAD DIVISION
C.I.C. SECTION
RICHUGHUTA STATION
YARD PLAN OF RICHUGHUTA STATION
SCALE - 1:1250
DRM/DHN/DRG.NO. 61-02
C.E. DRG. NO. Y-12200
BASED ON DRM/DHN/DRG NO 61-02
UP TO DATE POSITION
NOTE
1. THIS ENGINEERING PLAN HAS BEEN PREPARED TO GET THE APPROVAL OF CE/CE/ECR/BJP FOR UP CABINS ONLY ENGINEERING PLAN IS REQUIRED FOR SIGNAL, INTERLOCKING WORK OF RICHUGHUTA.
2. MODIFICATION IN EXISTING TRACK LAYOUT IS INVOLVED FOR THE 21 NOS VIDE DRG NO. Y-12200 LETTER NO. 201/CT/-6/283 DT. 26.06.2019 AND ACCEPTED BY SR. CE(C)/DHN VIDE LETTER NO. 201/CT/-6/283 DT. 12.12.2019
L.C. No. 29/C/E IS TO BE CLOSED AFTER COMMISSIONING OF LHS. DISTRICT MAGISTRATE APPROVAL FOR CLOSURE OF LC NO. 29/CE HAS BEEN OBTAINED VIDE LETTER NO.- 481 DT.- 26.06.2019.
ALTERATION-XV
1. ALTERATION IX SHOWN IN GREEN.
2. IN XV-12 DN LOOP LINE EXTENDED FOR PROVISION OF 23 BOXN, 5 SEC. LOCO & 1 WHEELER W/P. CAPACITY (73 BOXN).
3. THIS WORK IS SANCTIONED IN PWI BOOK NO. 18/18 2013-14 VIDE TERPSM PROJECT ID NO. 03-05-16-12 1.3.2017
ALTERATION-IX
ALTERATION-VI
ALTERATION-II
PRIVATE SIDINGS AT CH 202-00 TO 246-00 AT NORTH SIDE OF UP MAIN LINE TO BE DISMANTLED. NOW BOXN LINE EXCEPT MGS PREPARED VIDE DRG NO. Y-12200 ALTERATION-I
ALTERATION-I
1. ALTERATION I SHOWN IN GREEN.
2. CHANGE IN GRADE FROM NATURE OF LAST POINT ON EITHER SIDE AS PER LONG SECTION GIVEN BY ADEN/ATHE VIDE LETTER NO. 61/T/ADEN/ATHE DT. 19.11.2019.
